

4/5/17
14/5/17
4/12/17


NORTHWICH.

DRAWING N° 1379

LENGTH 99'-6" O.P. x 21'-6" B. x 10'-10" M.D.

SEPTEMBER 19TH 1916

SCALE = $\frac{1}{2}$ " = 1 FOOT.

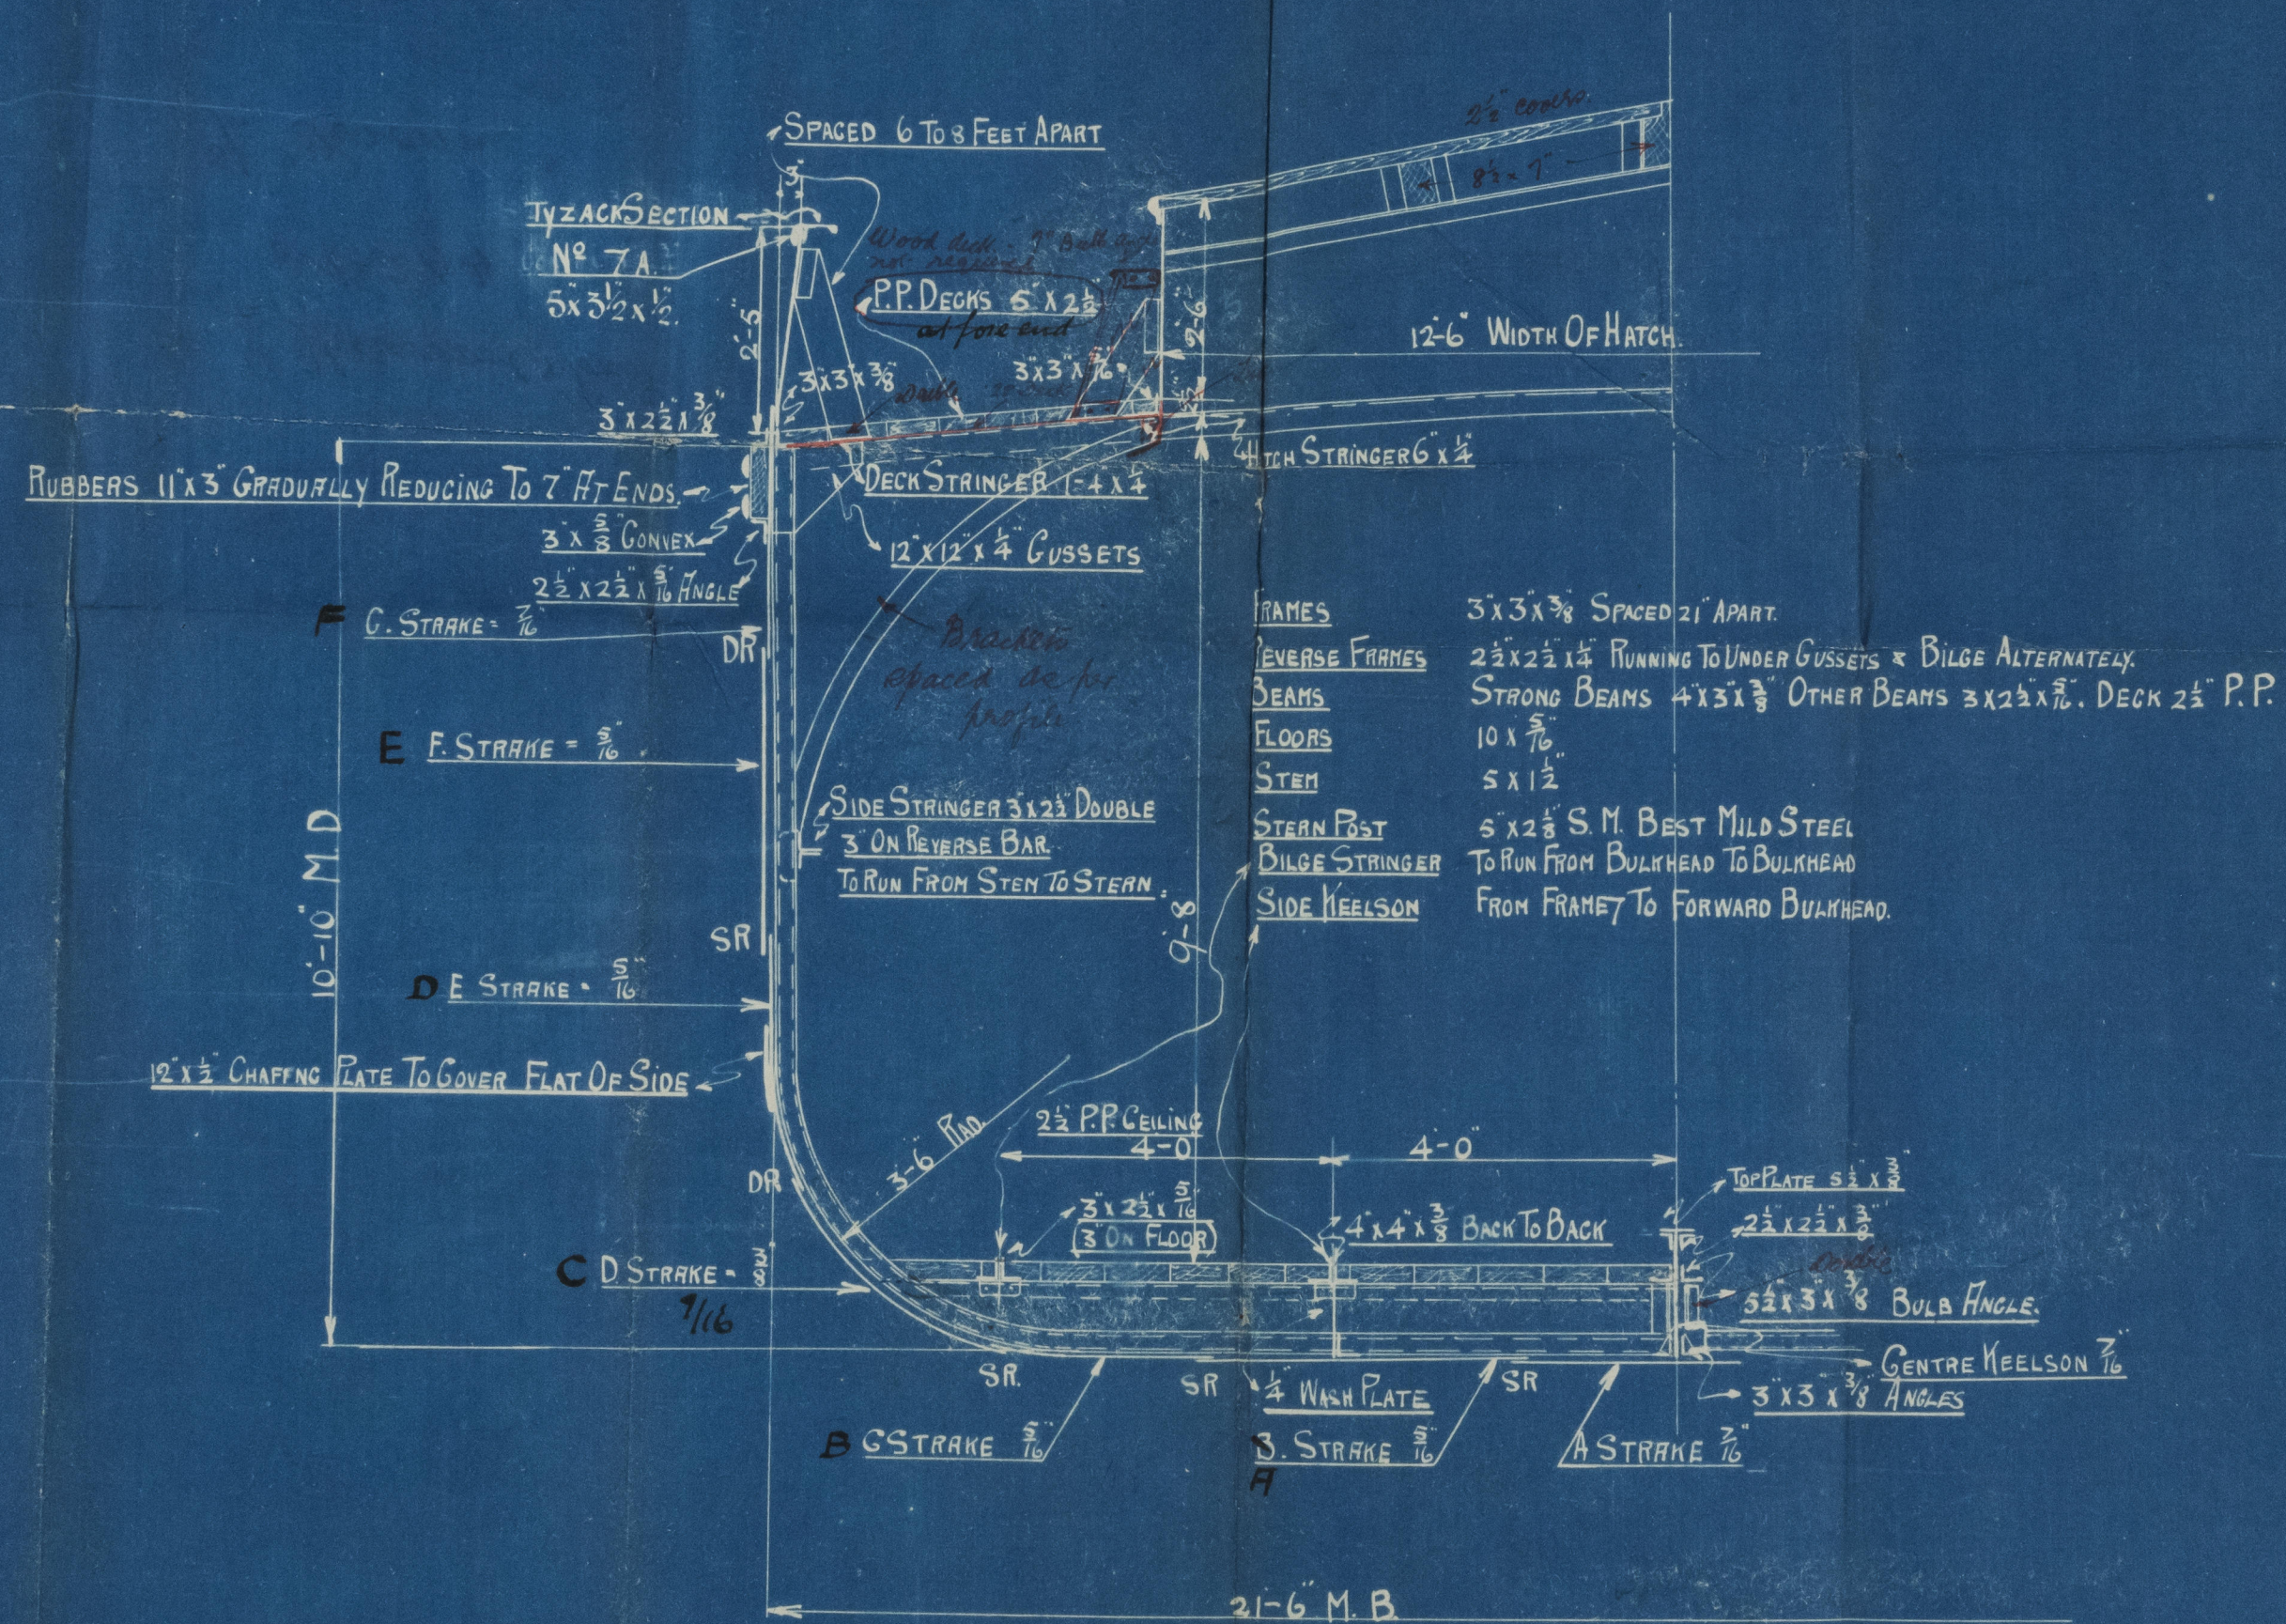

W. J. Yarwood & Sons
No 244.

5/6 "Peronne"

Midship Section

Liv Rpt No 77502



© 2021

Lloyd's Register
Foundation

006749-006759-0270

W. J. Chas. Wood
LLOYD'S REGISTER OF SHIPPING
13 NOV 1917
LONDON

LLOYD'S REGISTER OF SHIPPING
RECEIVED
12 MAY 1917
LONDON

LLOYD'S REGISTER OF SHIPPING
RECEIVED
21 JUN 1917
LONDON

LLOYD'S REGISTER OF SHIPPING
RECEIVED
1 JUL 1917
LONDON

LLOYD'S REGISTER OF SHIPPING
RECEIVED
25 SEP 1917
LONDON

006749-006759-0270

4/12/17
14/5/17
15/11/17



© 20

Lloyd's Register
Foundation