





26.11.13

No 868 Ship

Amended Arrangement of  
1st Class Saloon Deckhouse

Scale  $\frac{1}{8}'' = 1 \text{ foot}$

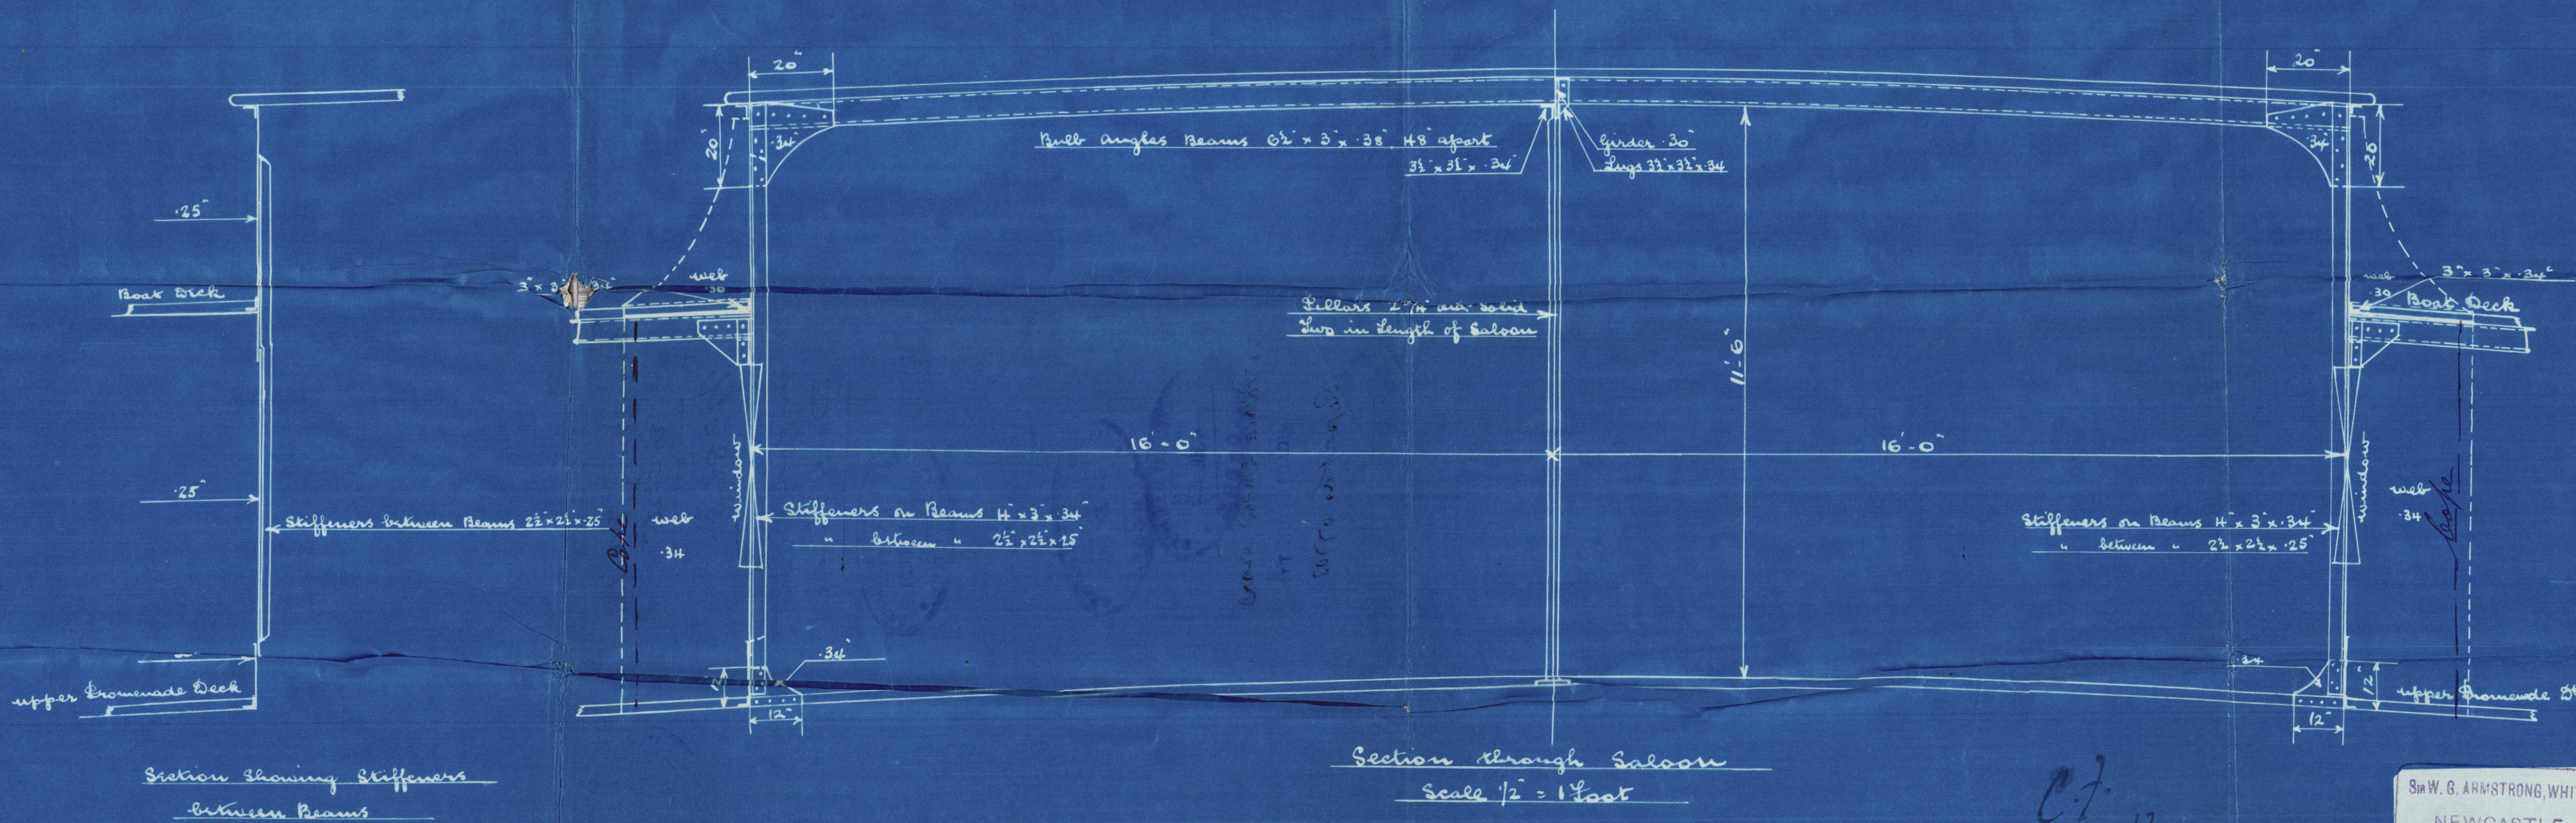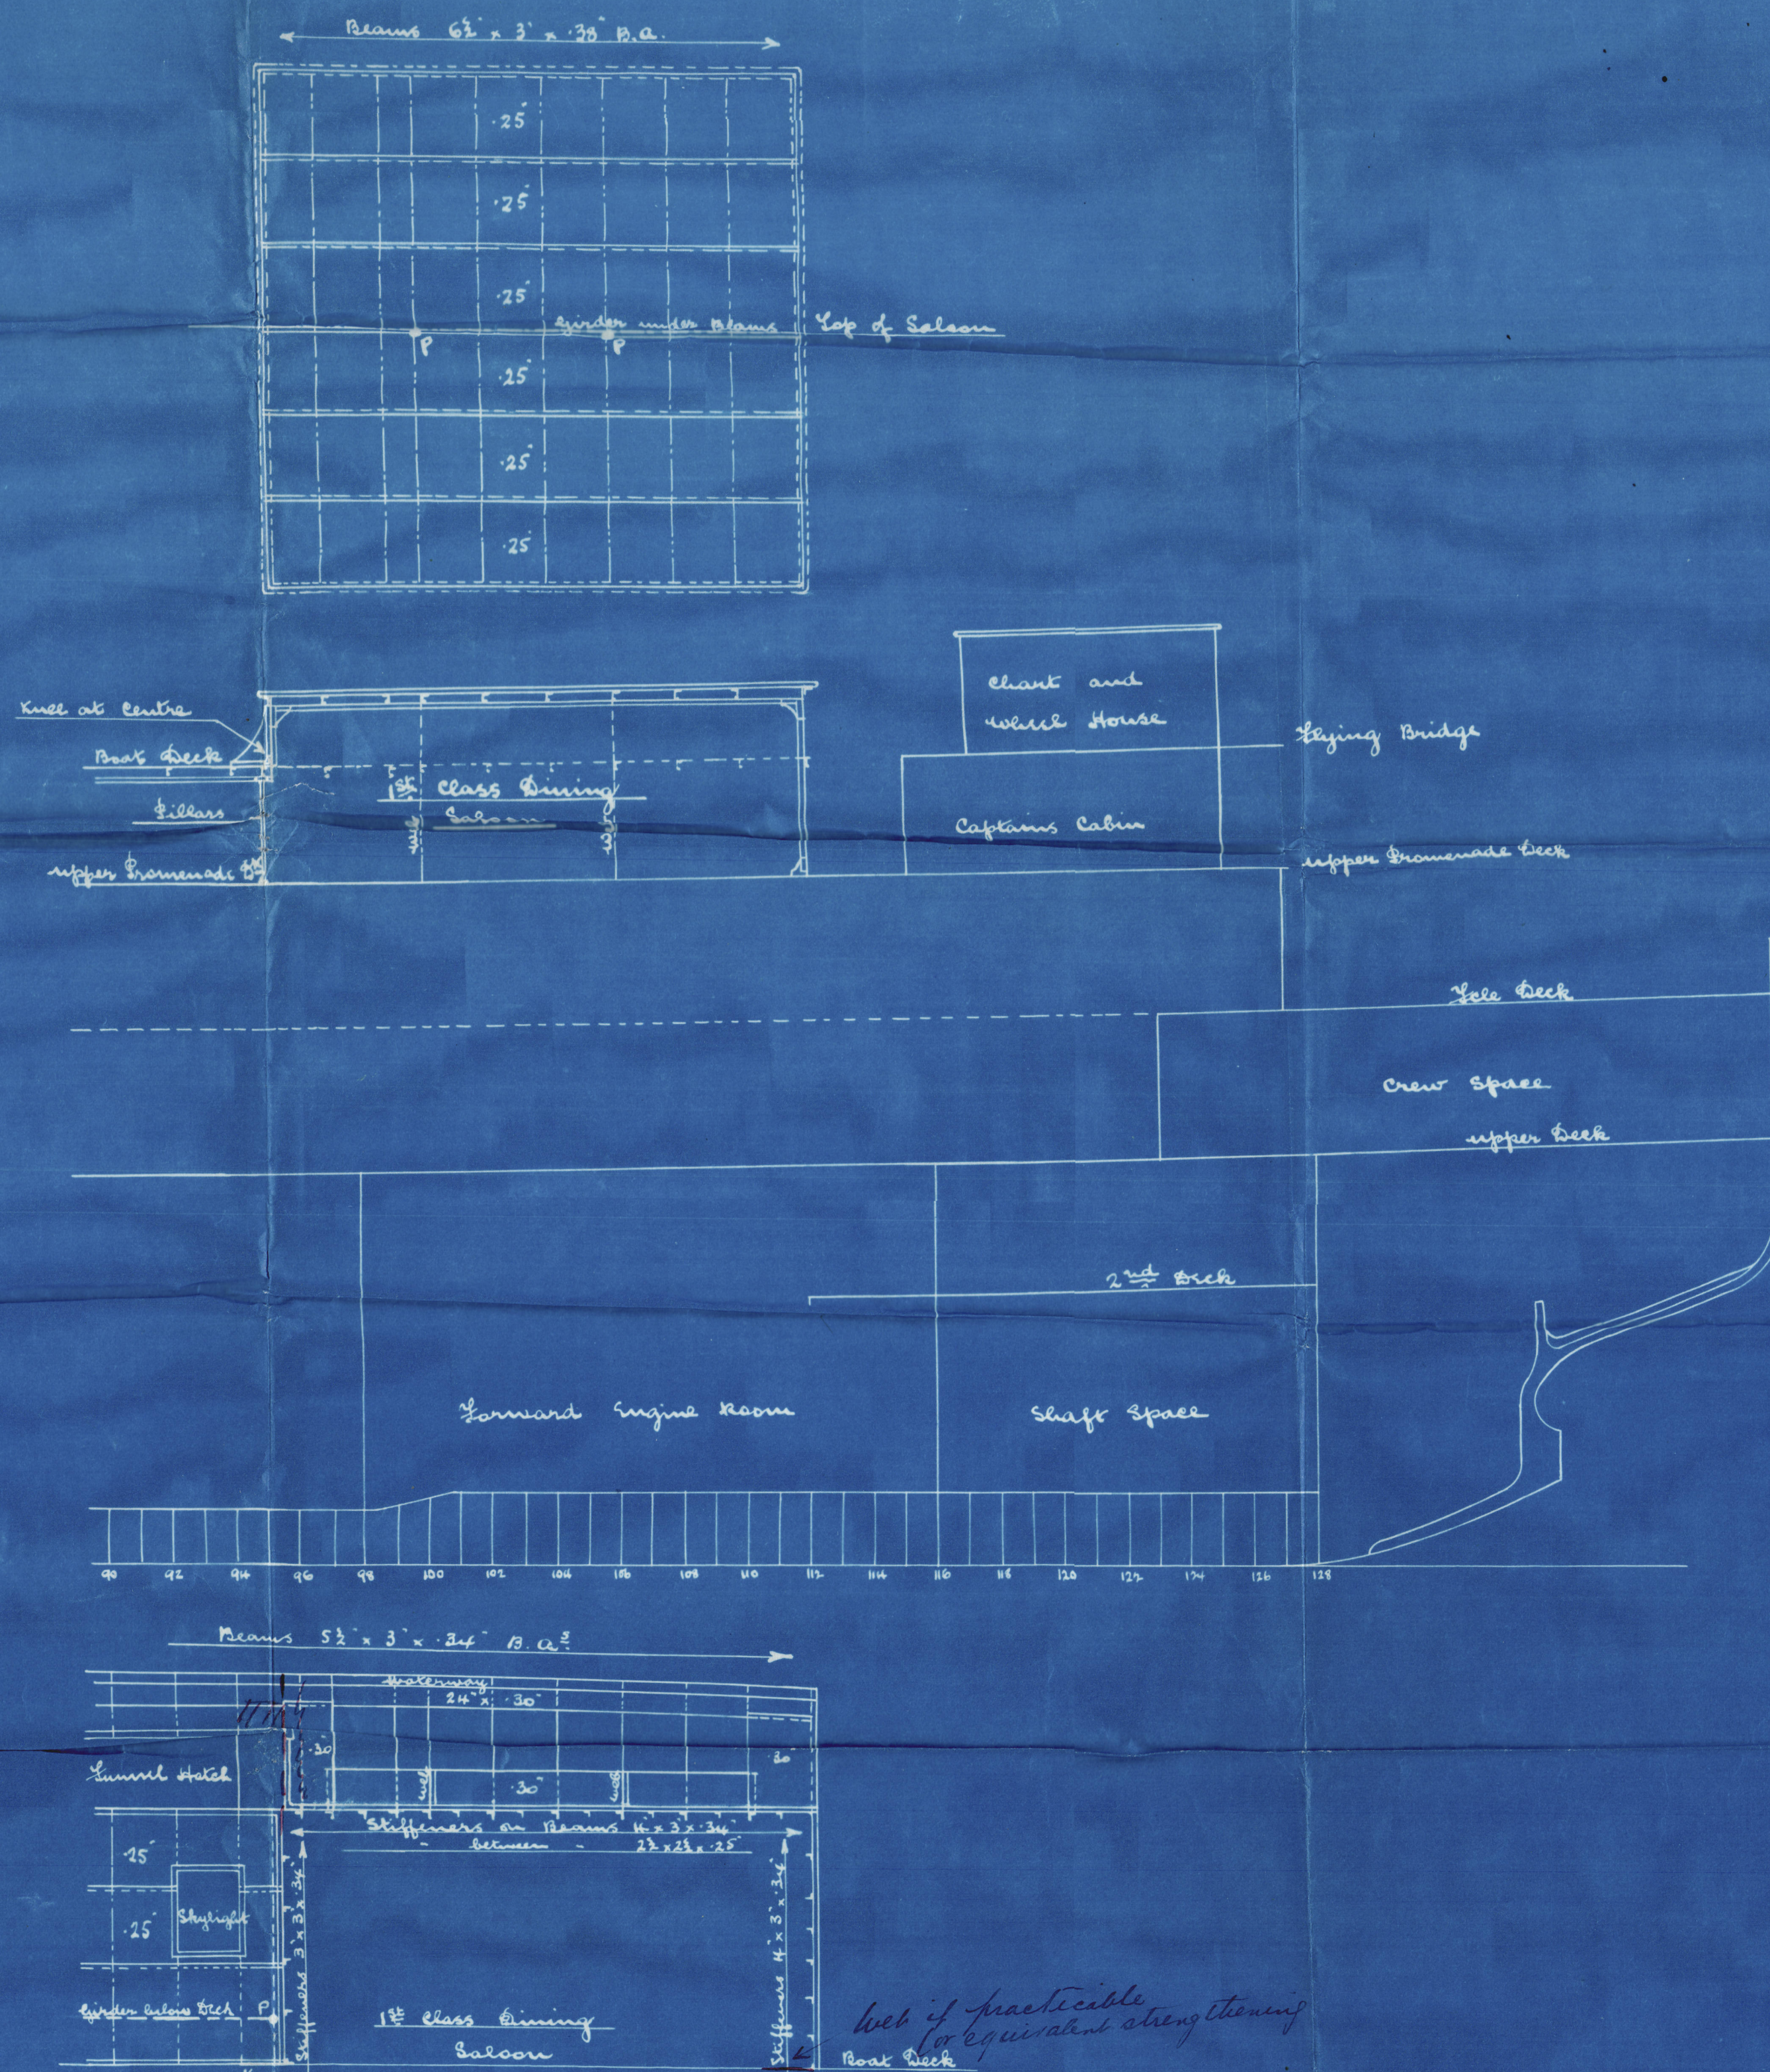




Sir W. G. ARMSTRONG, WHITWORTH & CO. LIMITED  
NEWCASTLE-UPON-TYNE,  
No 3710 DATE 22.11.13  
WALKER SHIPYARD



Armstrong Whitworth  
& Co. L<sup>td</sup>


No. 868

Arranged 1<sup>st</sup> Saloon  
Deck House.

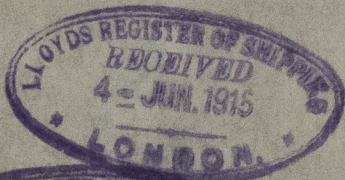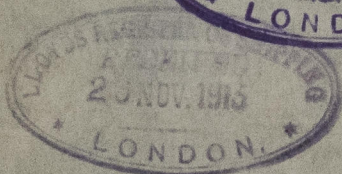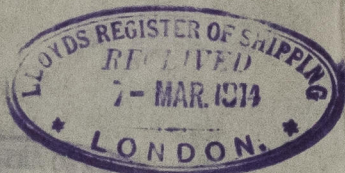

S/S PRINCE EDWARD ISLAND  
NEWCASTLE-ON-TYNE.

Report No. 67703

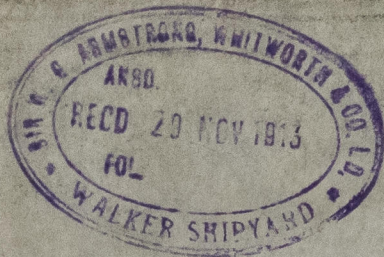

27/11/13

Lloyd's

Associated with Lloyd's Bank



© 2020

Lloyd's Register  
Foundation

006780-006786-0146