

No.868 SHIP.
PROFILE AND DECK PLANS.

SCALE $\frac{1}{8}$ " = 1 FOOT.

CLASS :- + 100 A. I. LLOYDS.

PRINCIPAL DIMENSIONS.


LENGTH OVER FENDER 300'-0"
RULE LENGTH 285'-0"
BREADTH MOULDED AT DECK 52'-0"
DEPTH MOULDED 24'-0"

LOAD DRAFT 18'-0".

Corrected in Blue by
Sir. W. G. & Co. Ltd.
Walker Shipyard 1/7/15

15.7.13
24.7.13.
31.8.13
13.9.13
8.10.13
22.11.13
26.11.13
27.1.14

W. G. ARMSTRONG & CO. LTD.
WALKER SHIPYARD
NEWCASTLE-UPON-TYNE

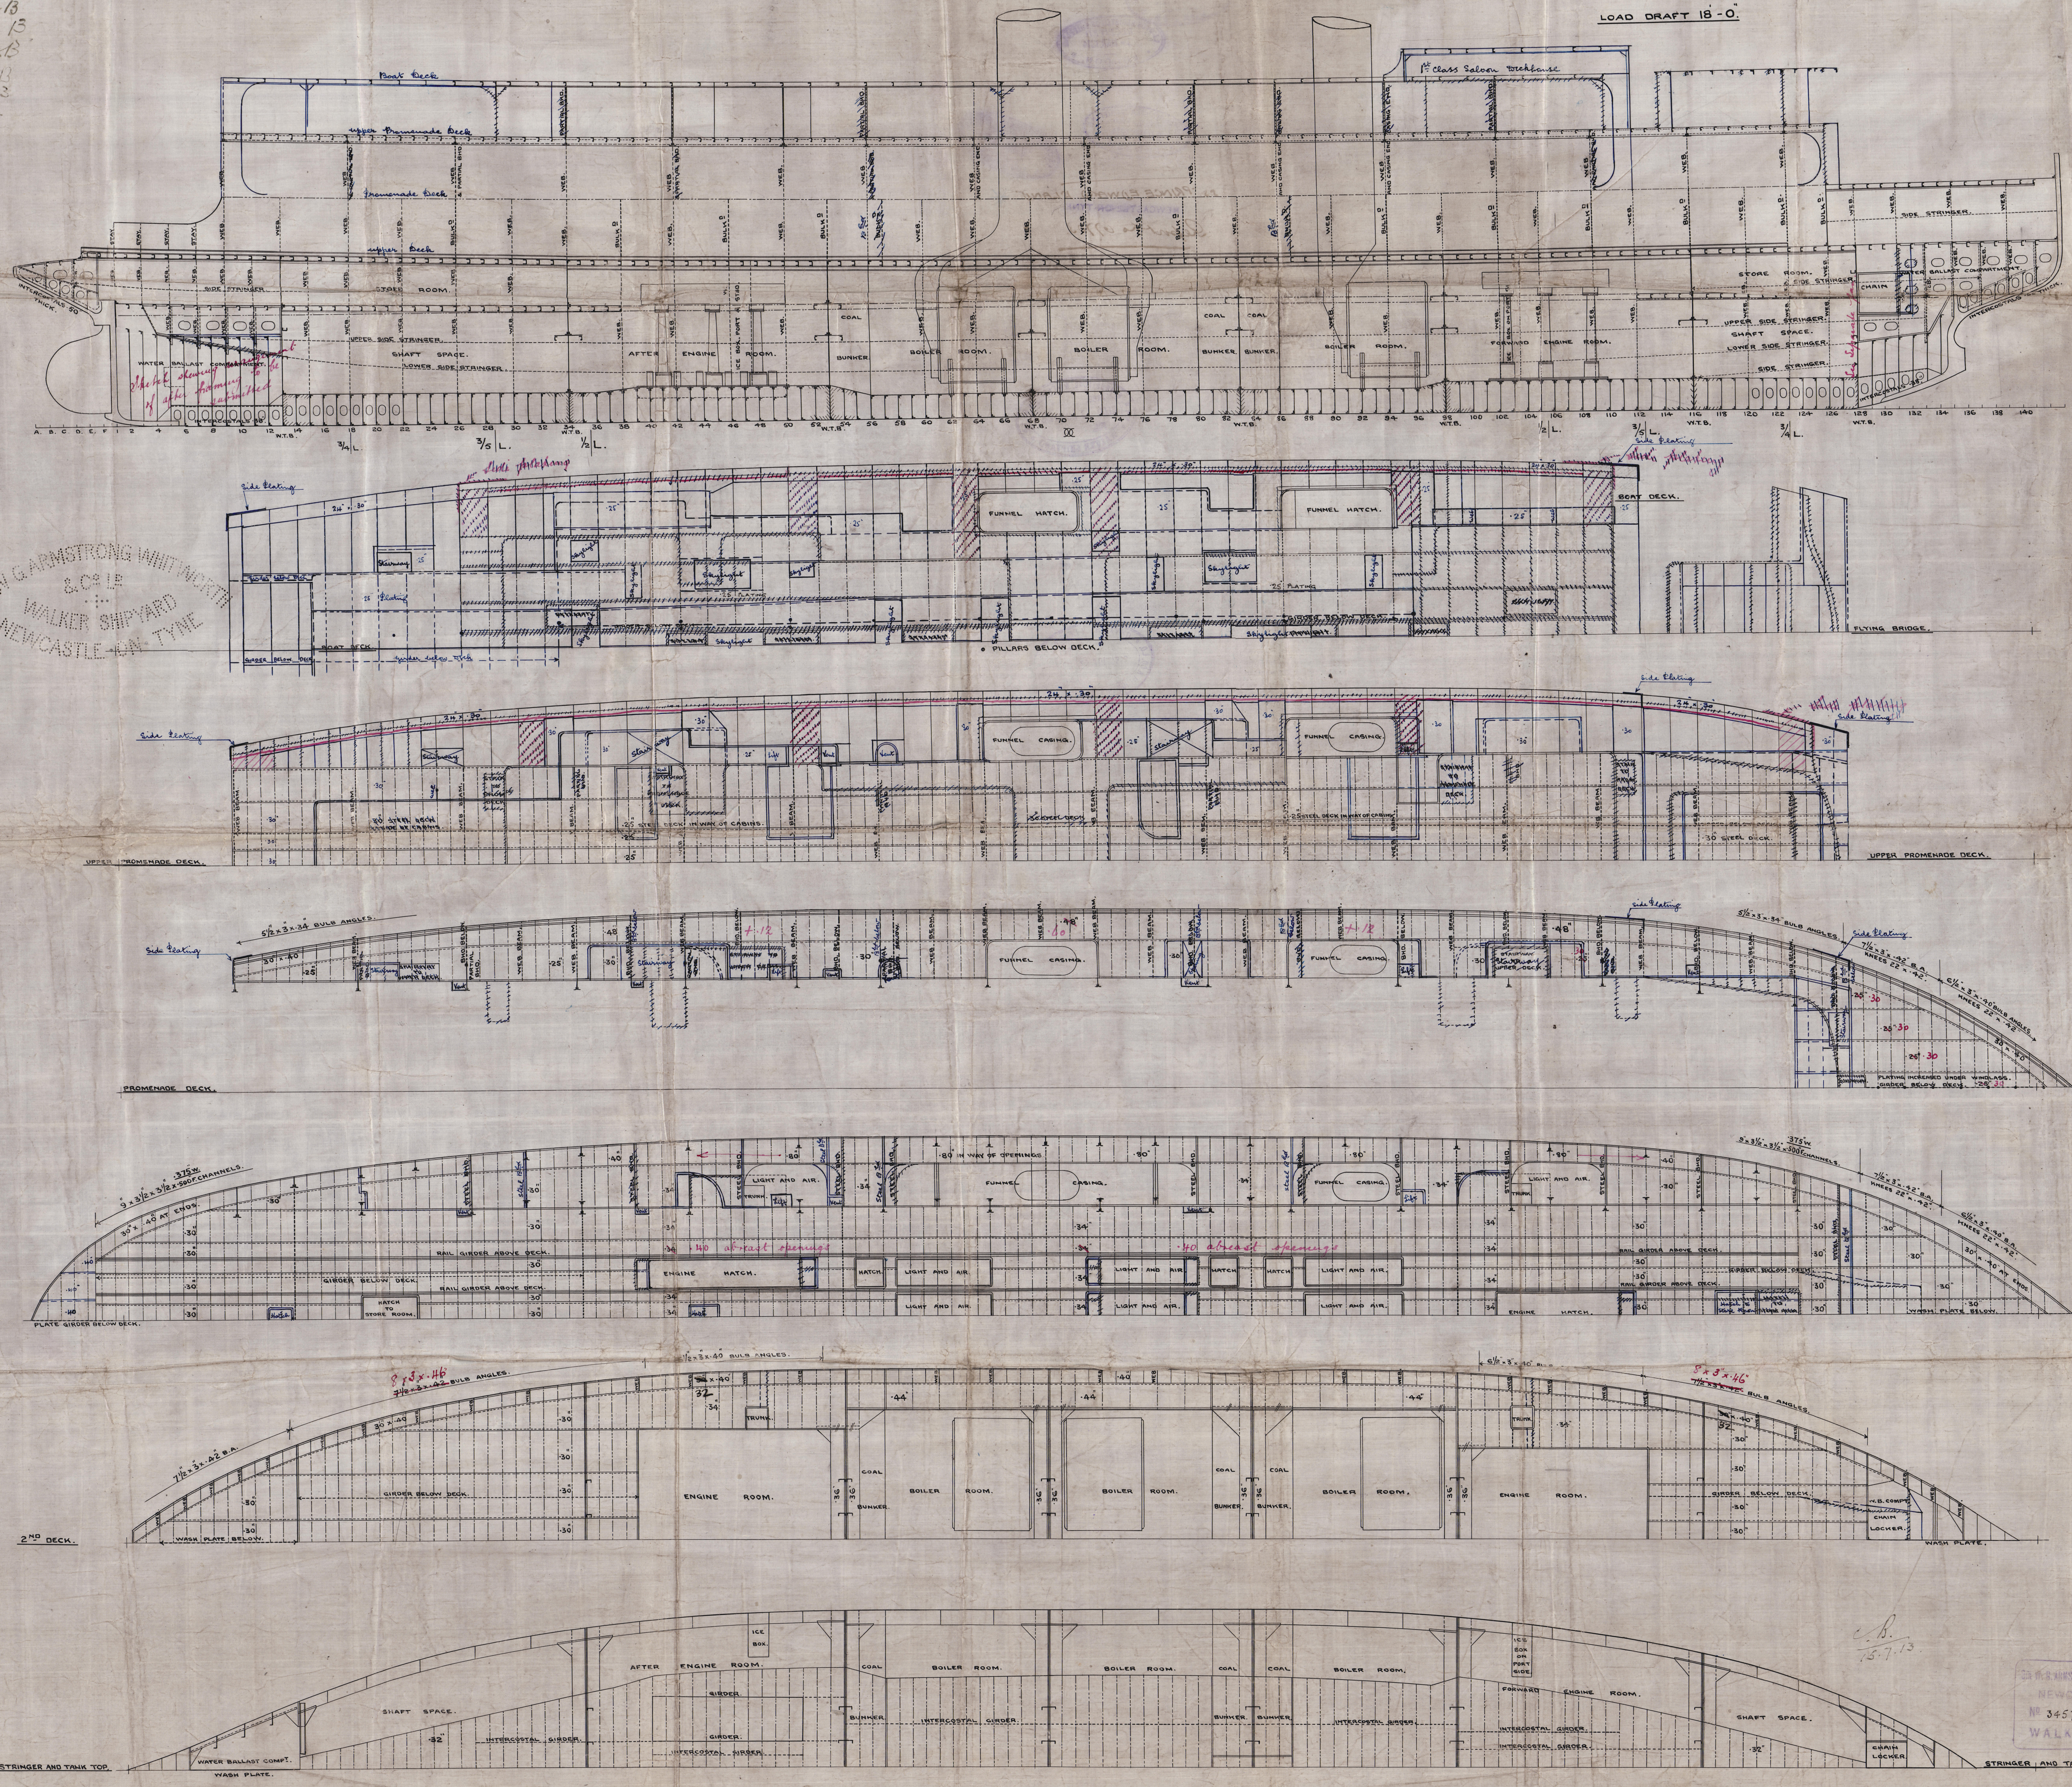

W. G. ARMSTRONG & CO. LTD.
NEWCASTLE-UPON-TYNE.
NO 3457, DATE 8-7-13
WALKER SHIPYARD.

D. S. 90

LLOYD'S REGISTER OF SHIPPING
 RECEIVED
 7- MAR 1914
 LONDON.

SS. PRINCE EDWARD ISLAND
NEWCASTLE-ON-TYNE
Report no 67703