

TO BE OF BEST HAMMERED SCRAP IRON






TO LLOYDS REQUIREMENTS & TESTS

SPEED $9\frac{1}{2}$ KNOTS AT SEA

AREA OF RUDDER 34 sq ft

DRAUGHT 8'-0"

DIA OF CHAIN $\frac{11}{16}$ " DIA OF RODS $\frac{3}{4}$ "

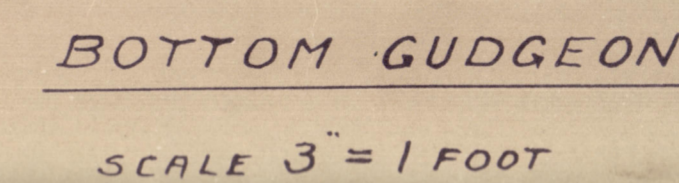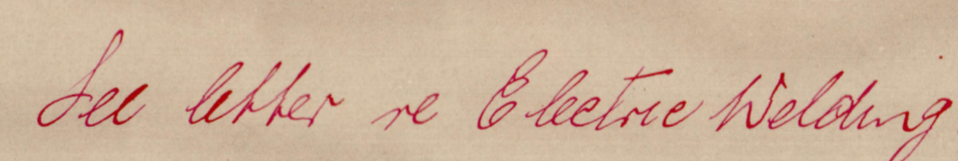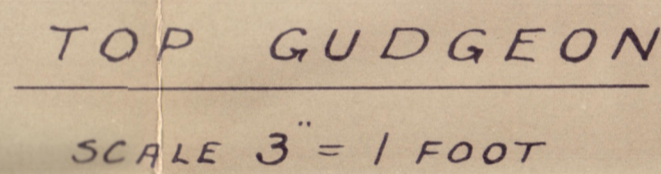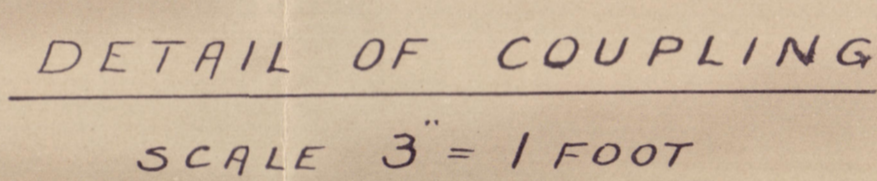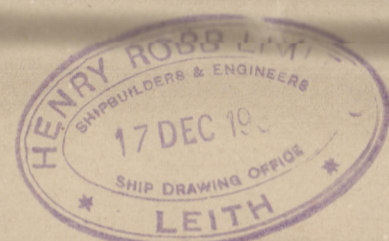

H.R. 3/242/3

Henry Pratt 2^d
N^o 242 & 243

Steamframe & Propeller

Lith. Rpt. No. 19419

m. v. "Joseph Flint"

Lith Rpt N^o 19587

M. V. "A. A. COWAN"



© 2021

Lloyd's Register
Foundation

006877-006888-0173