

"LA HEVE" MIDSHIP SECTION.

SCALE :- $\frac{1}{2}$ " = 1 FOOT.

DIMENSIONS

| | |
|---------------------------|---------|
| LENGTH S.P. | 395'-0" |
| BREADTH MLD | 55'-0" |
| DEPTH MLD TO MAIN DECK | 24'-6" |
| DEPTH MLD TO SHELTER DECK | 33'-6" |

TO CLASS LLOYDS 100 A.I. * WITH FREEBOARD
COMPLETE SUPERSTRUCTURE VESSEL WITH TONNAGE OPENING.
CORRESPONDING DRAFT 22'-2 1/2" MLD.
ALL SECTIONAL MATERIAL TO NEW BRITISH STANDARD

NUMERALS

| | | | | |
|-------------|---|--------------------|---|----------|
| D | = | 24.25 + 8.0 | = | 32.25 |
| L x D | = | 395 x 32.25 | = | 12739.00 |
| L x (B+D) | = | 395 x (55 + 32.25) | = | 34461.00 |
| L/D | = | 395 / 32.25 | = | 11.79 |
| D FORE BODY | = | | = | 12.42 |

EQUIPMENT NUMBER.

| | | | |
|-----------------------|--------------------|---|----------|
| HULL | 395 x (55 + 32.25) | = | 34357.50 |
| FORECASTLE | 39.75 x 7.5 x 7.5 | = | 223.60 |
| MIDHOUSE SHELTER DECK | 85 x 8.0 x 5 | = | 340.00 |
| BOAT DECK | 78.0 x 8.0 x 5 | = | 312.00 |
| CAPTAINS HOUSE | 85 x 8.0 x 5 | = | 100.00 |
| EQUIPMENT NO | | = | 35935.10 |

EQUIPMENT

| | |
|--|--|
| 2 BOWER ANCHORS EACH 63 3/4 CWTB STOCKLESS | |
| 1 " 84 1/2 " " | |
| 1 STREAM ANCHOR 7 1/2 " EX STOCK | |
| 270 FATHOMS 2 7/8" STUD LINK CHAIN CABLE | |
| 30 " 4 1/2" STEEL WIRE 9/16" ON REEL | |
| 120 " 5" STEEL WIRE TOWLINE 9/16" ON REEL | |
| 90 " 8" HEMP | |
| 90 " 5" " | |
| 90 " 7" " | |
| 90 " 7" " | |

| ITEM | EXTENT | ENDS |
|--|--|-----------------|
| CENTRE GIRDER | 41 x 58 FOR 1/2 L | 44 |
| " " BOTTOM ANGLES | 4 x 4 x 50 DOUBLE | 48 |
| " " TOP | 3 1/2 x 3 1/2 x 40 | 48 |
| " " VERTICAL | 3 1/2 x 3 1/2 x 48 SINGLE | |
| INTERCOSTAL GIRDER | 30 | |
| " " BOTTOM ANGLES | 3 1/2 x 3 1/2 x 48 SINGLE | |
| " " TOP | 3 1/2 x 3 1/2 x 48 | |
| " " VERTICAL | 3 1/2 x 3 1/2 x 36 | ON SOLID FLOORS |
| FLOORS (SOLID) | 40 SPACED 10'-0" APART 2'-3" FORD OF 1/2 L SOLID UNDER | |
| TANK FRAMES ON SOLID FLOORS | 30 x 3 1/2 x 48 SINGLE | |
| " " REV. | 3 1/2 x 3 1/2 x 48 SINGLE | |
| TANK TOP CENTRE STRAKE | 8 1/2 x 50 FOR 1/2 L | 48 |
| " " PLATING | 48 | 38 |
| ALL TANK TOP LANDINGS | 2 1/2 IR 3/4 WHERE CEILING FITTED | |
| 4 1/2 IR 3/4 IN TUNNEL OVER OIL NO CEILING | | |
| CEILING ON TANK TOP IN HOLDS | 2 1/2 WHITE PINE ON 3 BEARERS OVER OIL | |
| | 1 1/2 " W.B. | |


RIVETING.

| | |
|--|----------------------------------|
| BUTTS OF BOTTOM SHELL (WHERE NOT WELDED) | - 3R FORE & AFT |
| " " SIDE | - 3R FORE & AFT |
| " " STRAKE BELOW SHEERSTRAKE | - 3R FORE & AFT |
| " " SHEERSTRAKE | - 3R FORE & AFT |
| " " LOWER DECK STRINGER PLATE | - 2R FORE & AFT |
| " " PLATING - 1R FORE & AFT | |
| " " MAIN | - STRINGER PLATE - 2R FORE & AFT |
| " " PLATING - 2R FOR 1/2 LENGTH 1R AT ENDS | |
| " " FOCLE | - STRINGER PLATE - 2R |
| " " PLATING - 1R | |

BUTTS ALL
WELDED.

MAIN WELDING ITEMS

| | |
|---|--|
| BUTTS OF CENTRE GIRDER | |
| " OF TANK TOP PLATING & MARGIN | |
| " OF SHELTER DECK STRINGER & PLATING | |
| " KEEL PLATE | |
| " BOTTOM SHELL B, C, D & E STRAKES | |
| LOWER & MAIN DECK STRINGER PLATES TO SHELL | |
| BUTTS OF LOWER & MAIN DK STRINGER & DECK PLATING WELDED | |
| BUTTS OF SIDE SHELL & SHEERSTRAKE WELDED | |

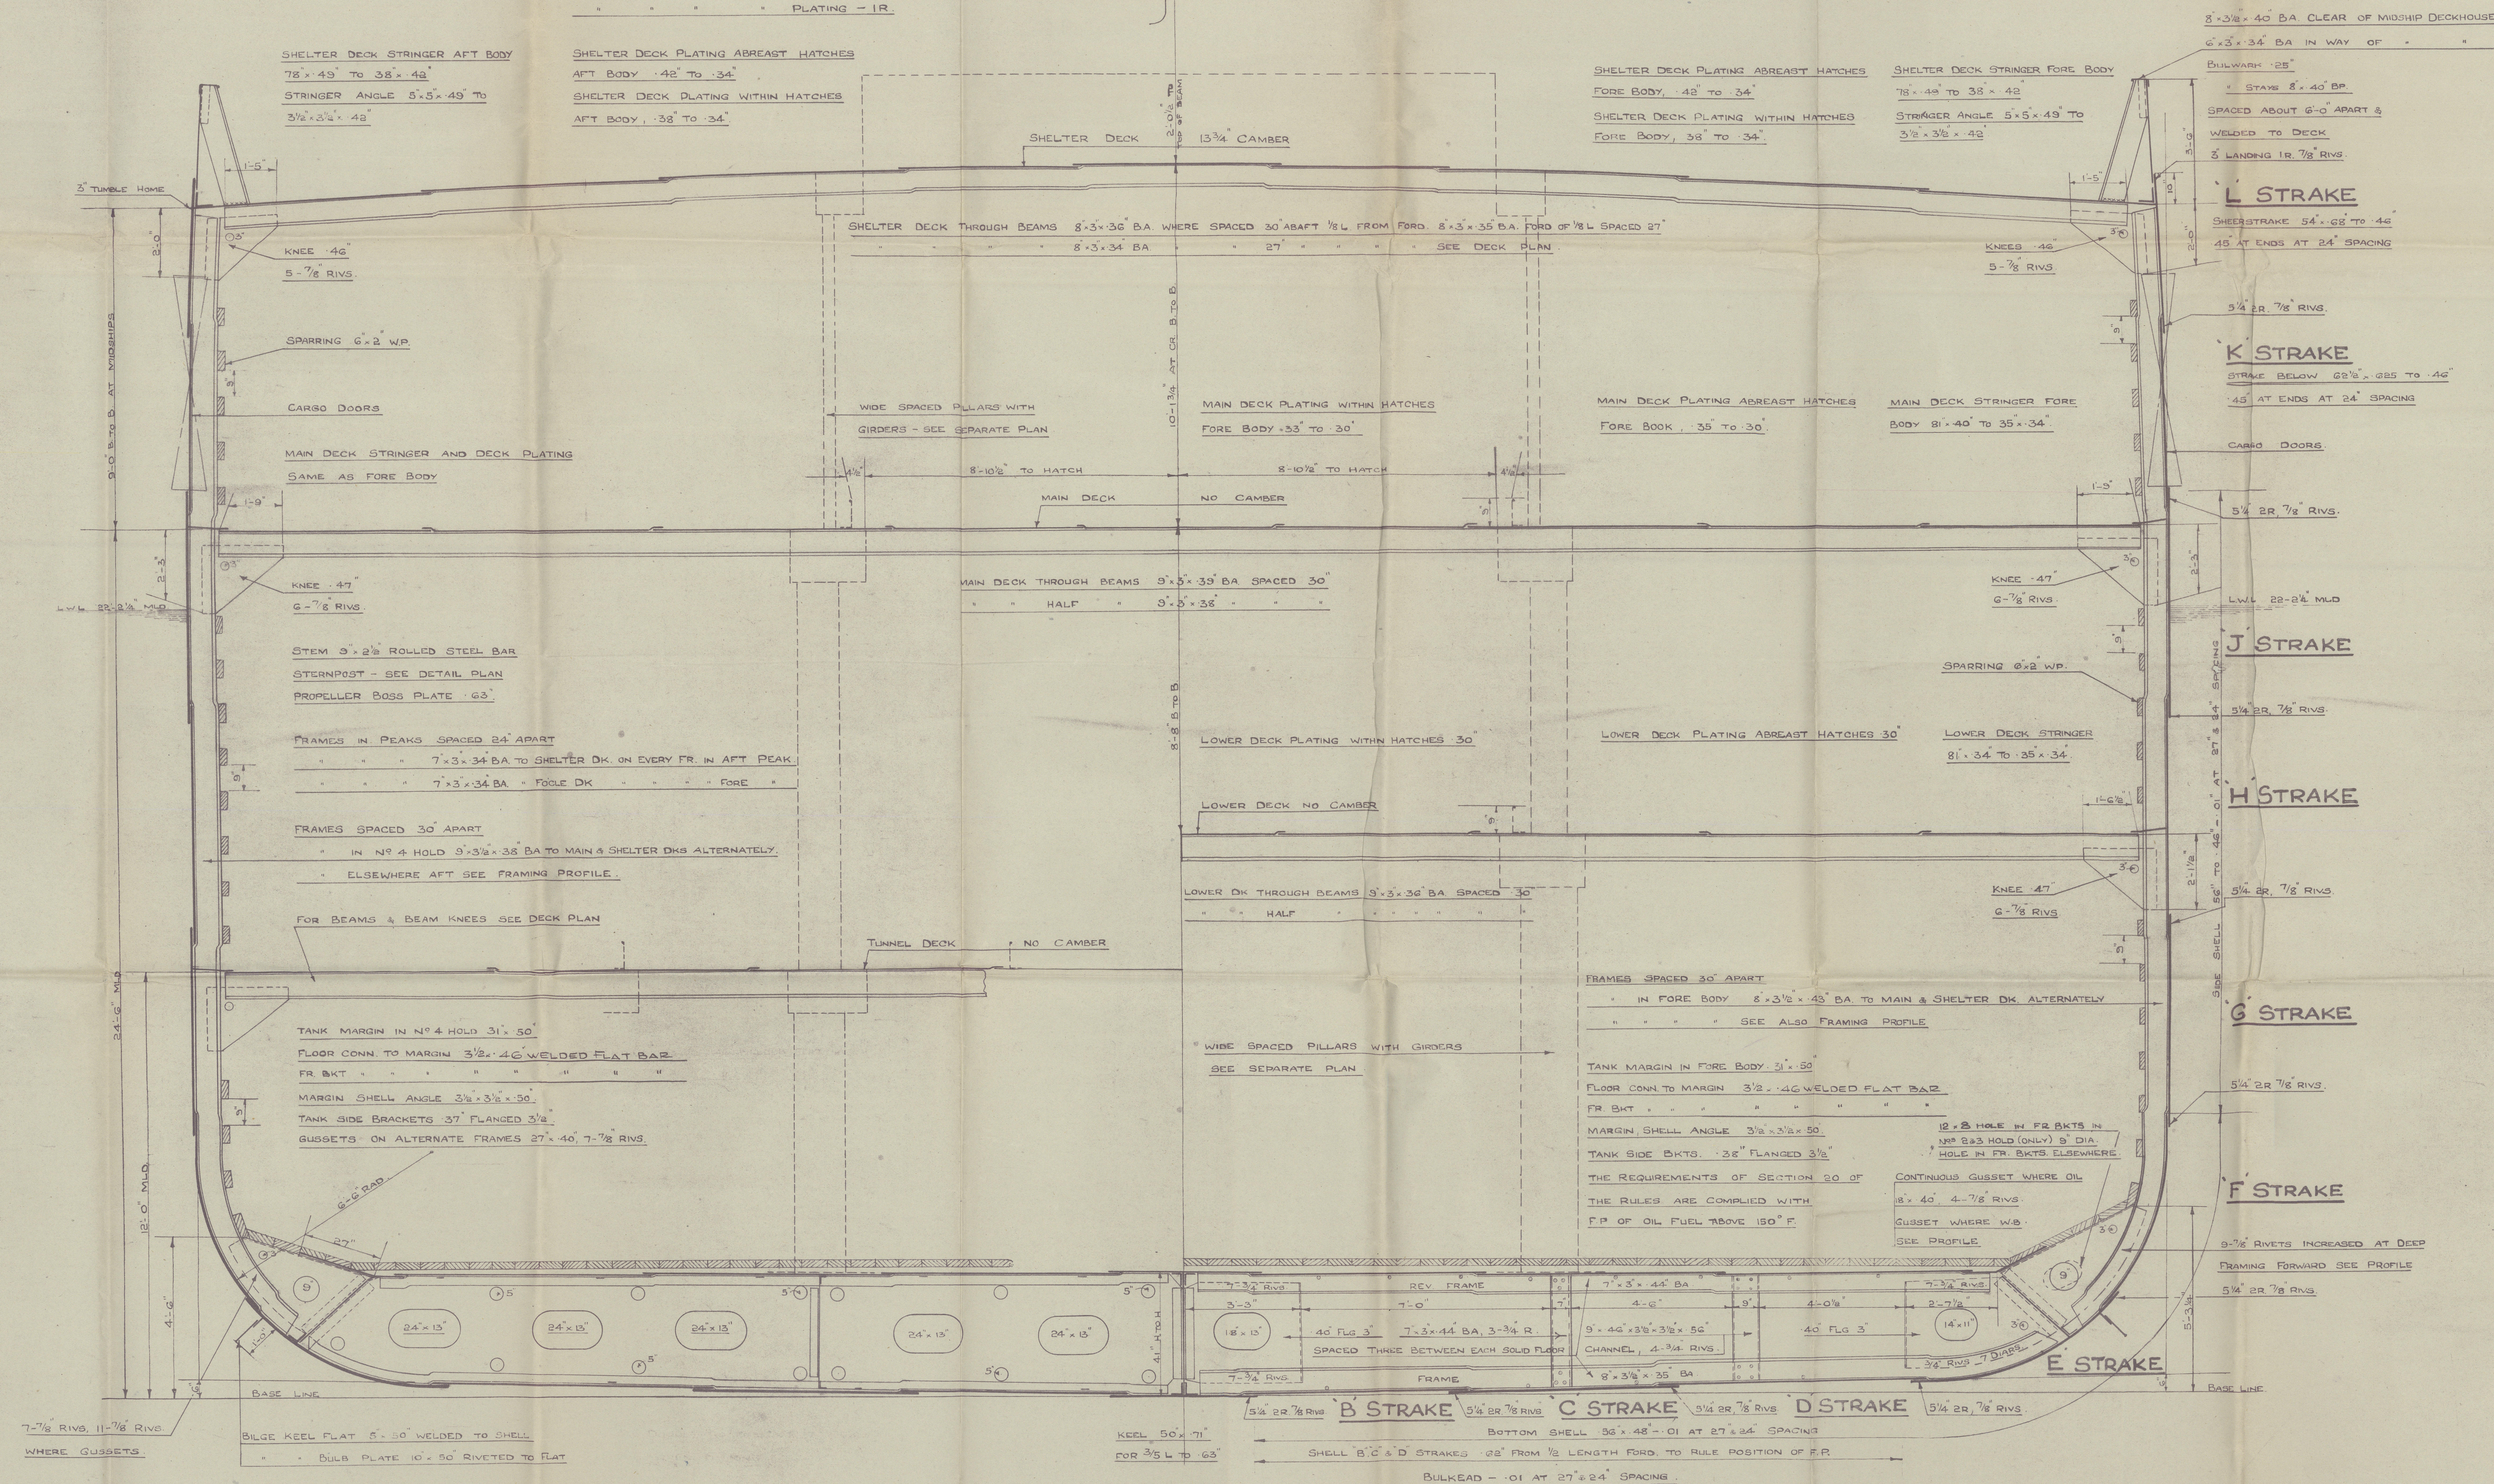

LA HEVE *

N.W. 134.56.

Gle report 6072091


Mp's in Section rebuilt



006903-

006911-

0255

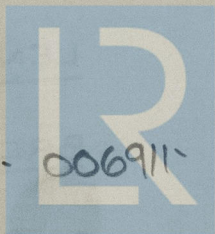

© 2021

Lloyd's Register
Foundation