

-N°131-

-MIDSHIP SECTION-

To Class 100 A1. LLOYDS COASTING CLASS.

23.7.09

- NUMERALS -

1/2 GIRTH	20.05
1/2 BREADTH	12.5
DEPTH	9.52
1 ST N°	42.07
LENGTH 148.96 x	42.07
2 ND N° =	6266.7

- DIMENSIONS -

LENGTH B.P.	150.0
BREADTH MLD:	25.0
DEPTH MLD:	9.0

SCALE 1/2" = 1 FOOT.

- EQUIPMENT -


$$6266 + 1.5 \left(\frac{14}{14} + 63 + 24 \times 71 \right) + (7 \times 7 \text{ ACCOM}) =$$

$$6266 + 1067.95 + 49 = \mathbf{7382}$$

2 BOWERS	9 CWTs (STOCKLESS)
1 STREAM ANCHOR	3 CWTs (EX STOCK)
1 KEDGE	1 1/4 " "
165 FMS	1" STUD CHAIN CABLE
45 "	2 3/4" STEEL WIRE
75 "	2 1/2" STEEL WIRE TOWLINE
90 "	5/2" HAWSER.

$\frac{L}{D} = 15.64$

$\frac{L}{B} = 5.95$

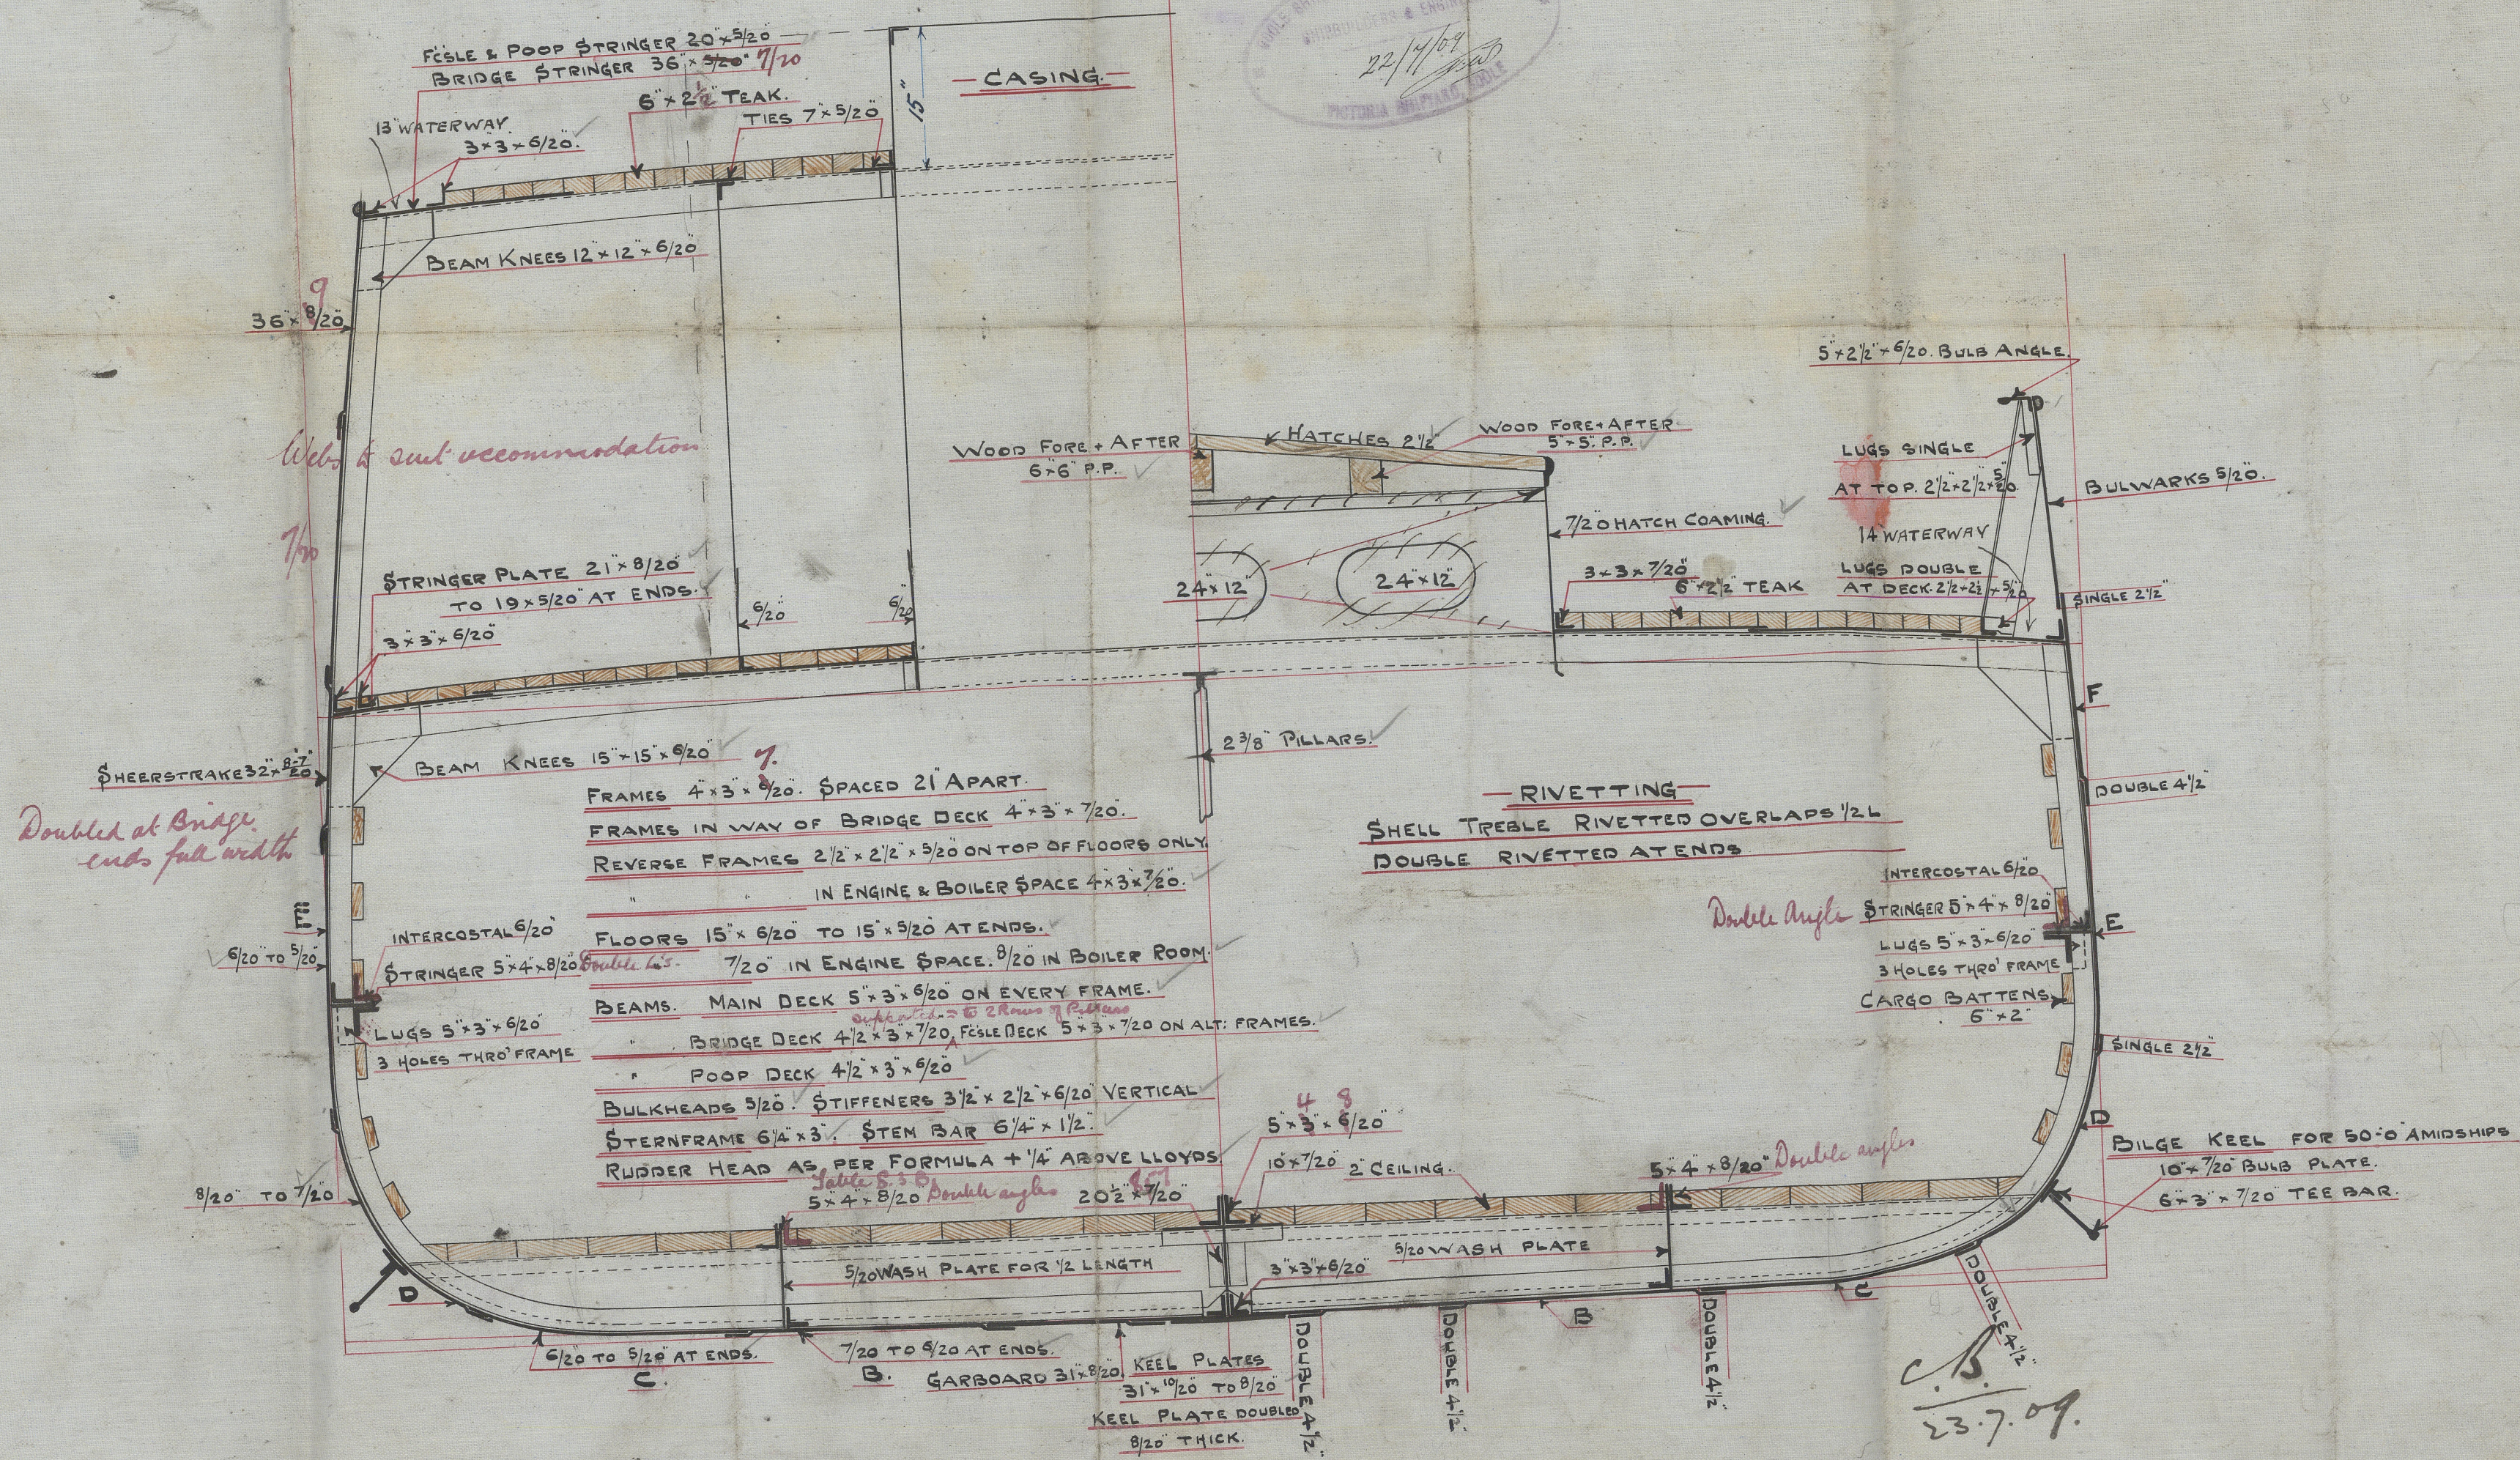

№ 131

Midships Section

Sp Gladys
Hull Report No. 22081

007008 - 007020 - 0192