


LONGITUDINAL SECTION

SCALE $\frac{1}{8}" = 1 \text{ FT.}$

MAINE SHIPBUILDING & REPAIRING CO. LTD.
SHIPBUILDERS & ENGINEERS
22/7/09
MAINE SHIPBUILDING & REPAIRING CO. LTD.


23-7-09.

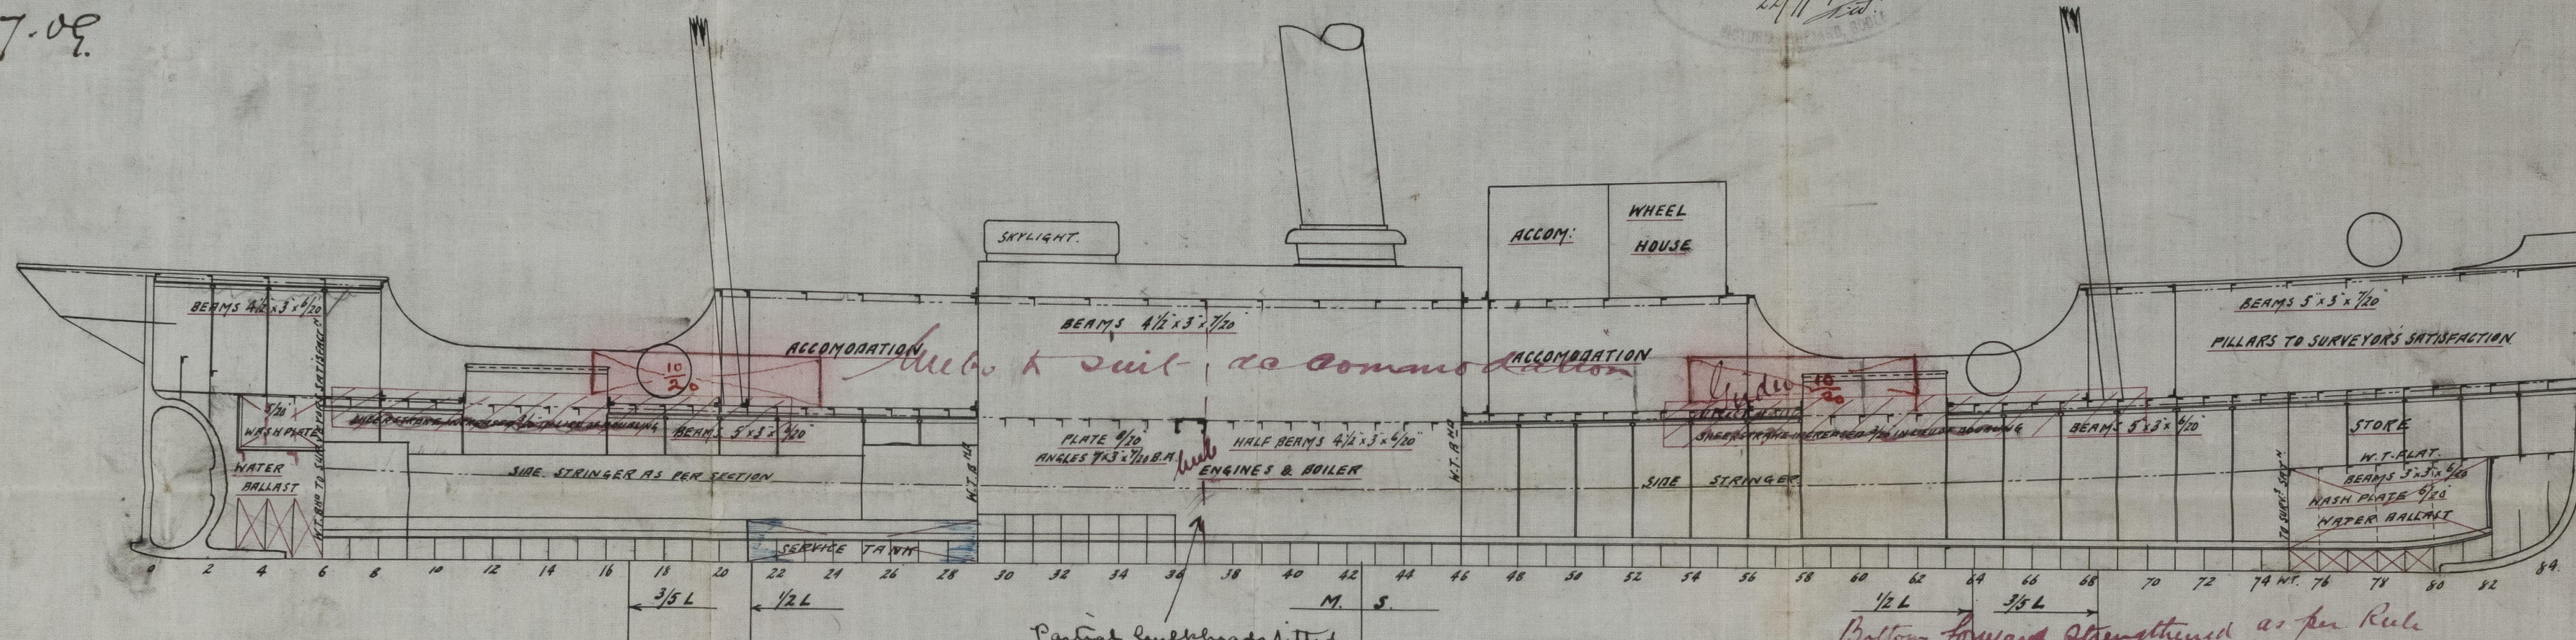

Partial bulkheads fitted
in lieu of web frames

Bottom forward strengthened as per Rule
if required

Stringer doubled at Bridge end.

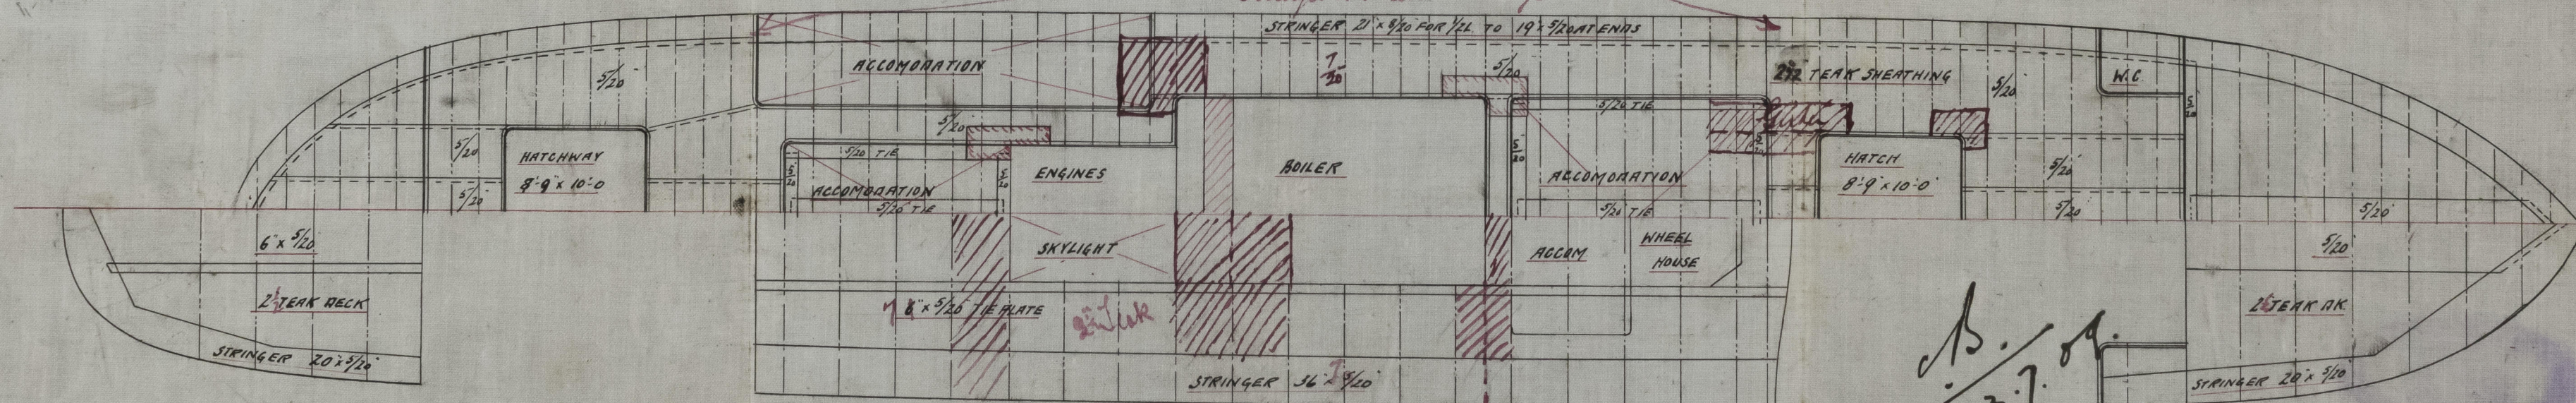

13. / 23.7. 04

Boole S.R.C. Ltd
N: 131.

Roof & Deck

3/2 Gladys

Hull Report No. 22081



© 2020

Lloyd's Register
Foundation

007008-007020-0193