

Lloyd's Register of Shipping.

(Report on Vessel No. 6712 Port Hongkong)No. 691 SHIP FORGINGS OR CASTINGS.

I have to report that the undermentioned ~~Iron or~~ Steel Forgings or Castings, manufactured by The Hongkong Whampoa Dock Co. Ltd of Hongkong for the Vessel No. 691, being built by The H.K. & Whampoa Dock Co. Ltd of Hongkong have been inspected by me as set forth below and found to be, so far as can be seen, sound & free from defects.

Forgings or Castings.

Lloyd's

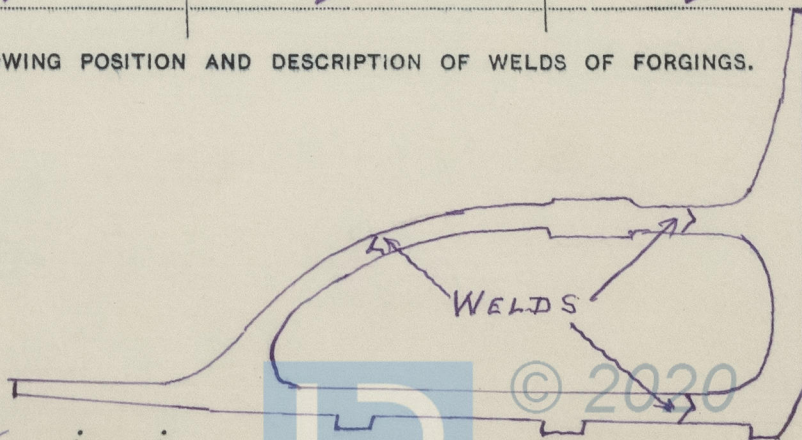
No. 691

S.M.

4-31, 29-4-31, +20-5-31.May 20th 1931, HongkongW. Morrison

	STERN FRAME.	RUDDER FRAME.	STEM.
...	<u>O. H. Steel</u>	<u>O. H. Steel</u>	<u>O. H. Steel</u>
le ...	<u>Forged</u>	<u>Forged</u>	<u>Forged</u>
ed ...	<u>Yes</u>	<u>Yes</u>	<u>Yes</u>
ns ...	<u>As per plan</u>	<u>3" dia.</u>	<u>5 1/2" x 1"</u>
on Inspection ...	<u>Finished</u>	<u>Finished</u>	<u>Finished.</u>
en Inspected	<u>April 17, 23 + 29</u>	<u>April 17, 29, May 9,</u>	<u>April 15 + 17, 1931.</u>
	<u>1931</u>	<u>16, + 20, 1931</u>	
CASTINGS.			
Standard Test Pieces.		<u>Stock</u>	<u>Overt</u>
Test—		<u>Compling</u>	
square inch ...	<u>28.8</u>	<u>32.1</u>	<u>28.8</u>
on per cent. <u>2 1/2</u> ...	<u>34.3</u>	<u>31.25</u>	<u>31.25</u>
ding Test—			
efore fracture ...	<u>180° without fracture</u>	<u>180° without fracture</u>	<u>180° without fracture</u>
t—			
from ground ...	<u>✓</u>	<u>✓</u>	<u>✓</u>
ng Test—			
according to Rules	<u>✓</u>	<u>✓</u>	<u>✓</u>
und satisfactory ...			

SKETCHES OF FRAMES SHOWING POSITION AND DESCRIPTION OF WELDS OF FORGINGS.

(if any chargeable) £ ✓ : :To be paid at ✓

Iron, state whether scrap or puddled Iron. If of Steel, state whether made on the Open Hearth process.