


RECORD
OF
CHANGES

Leola Vivian
Rpt NO Ver 5316


RUDDER

M.V. "LEOLA VIVIAN"

SCALE $1\frac{1}{2}'' = 12''$

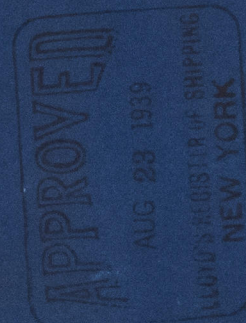

Amey

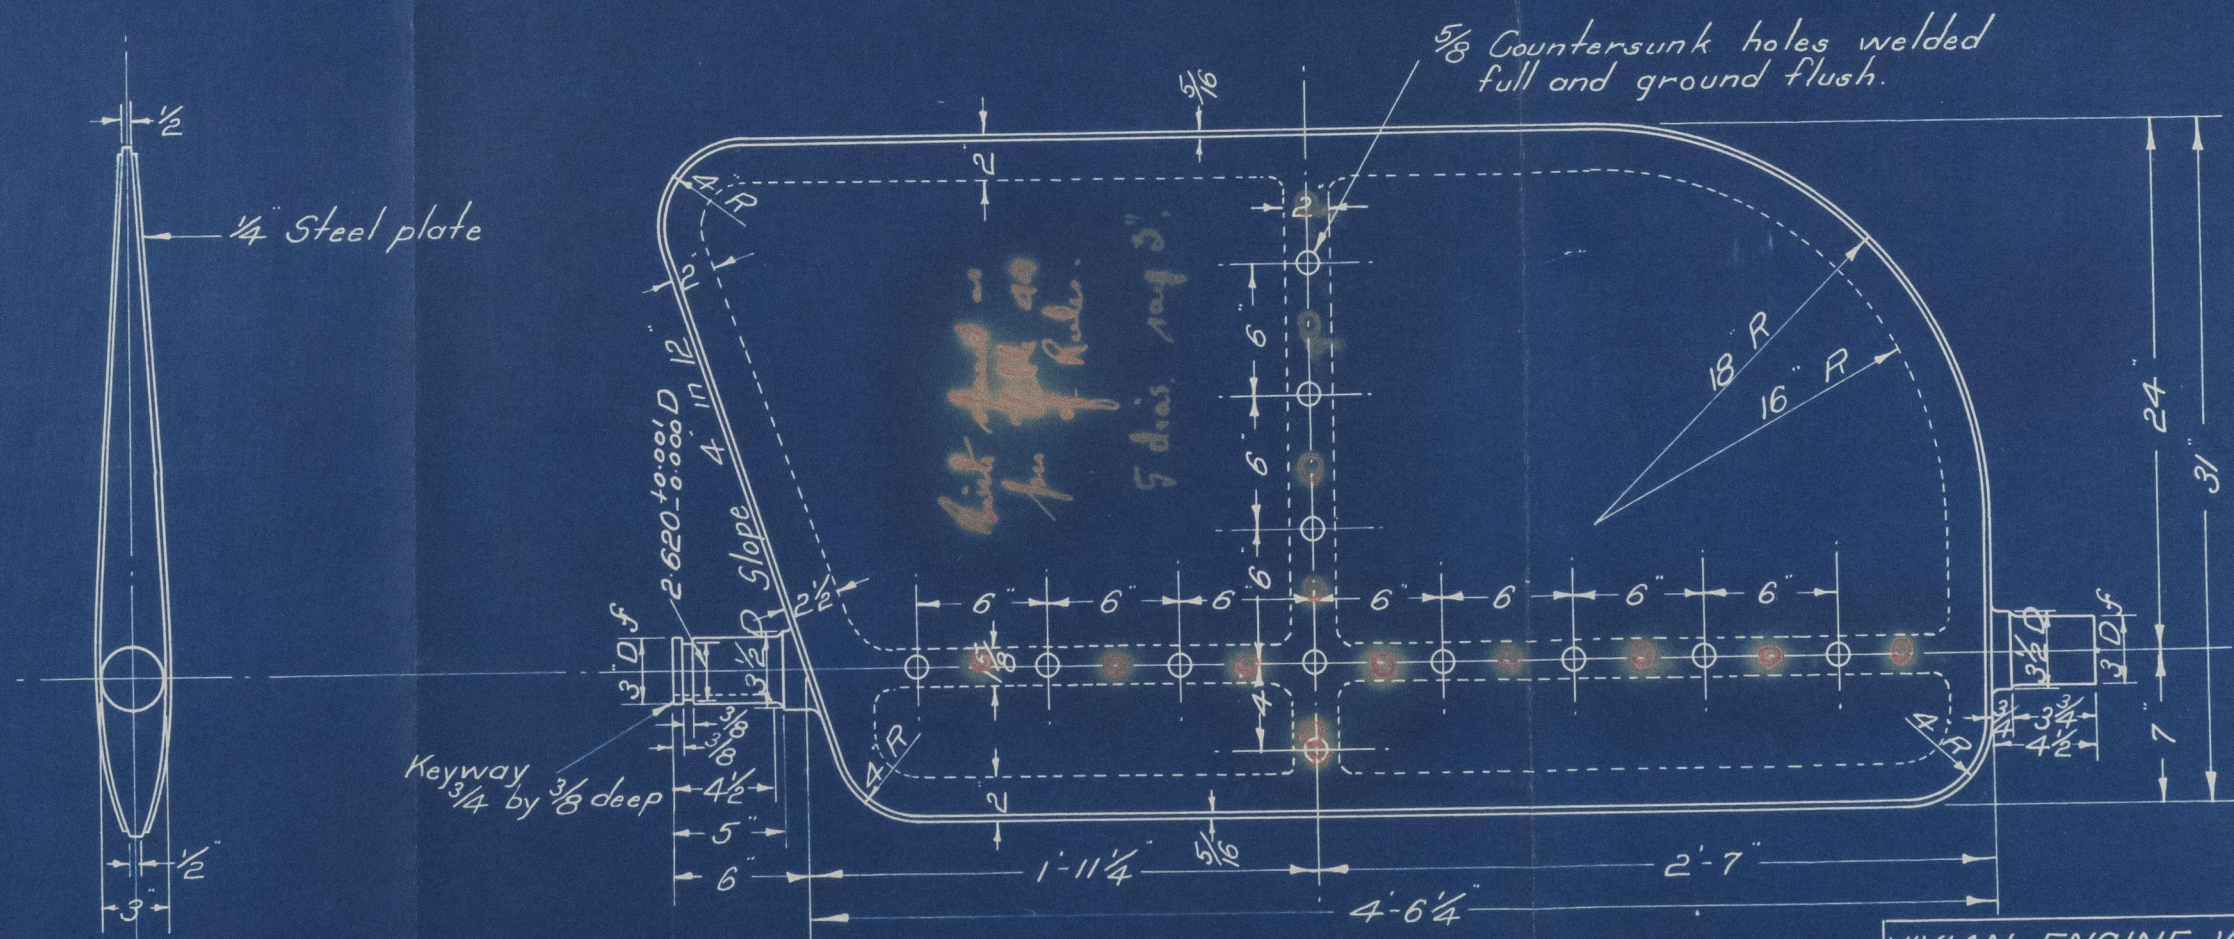

VIVIAN

| VIVIAN ENGINE WKS. LTD. | | |
|-------------------------|----------|----------|
| DWG. NO. | 6758AM14 | |
| DATE | DRN. BY | CHKD. BY |
| AUG. 4/39 | A. K. D. | |