





15.7.09.

PROFILE AND DECK PLAN

No 263 SHIP

DIMENSIONS 106 x 23 x 12.9

SCALE 1/4" = 1 FOOT

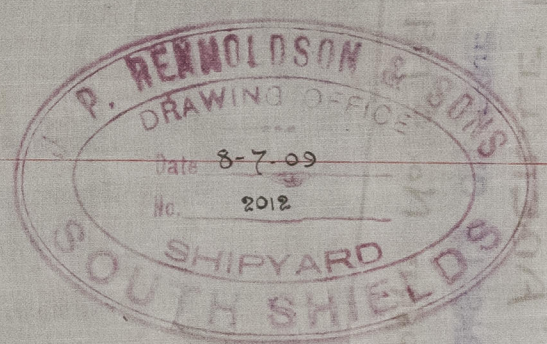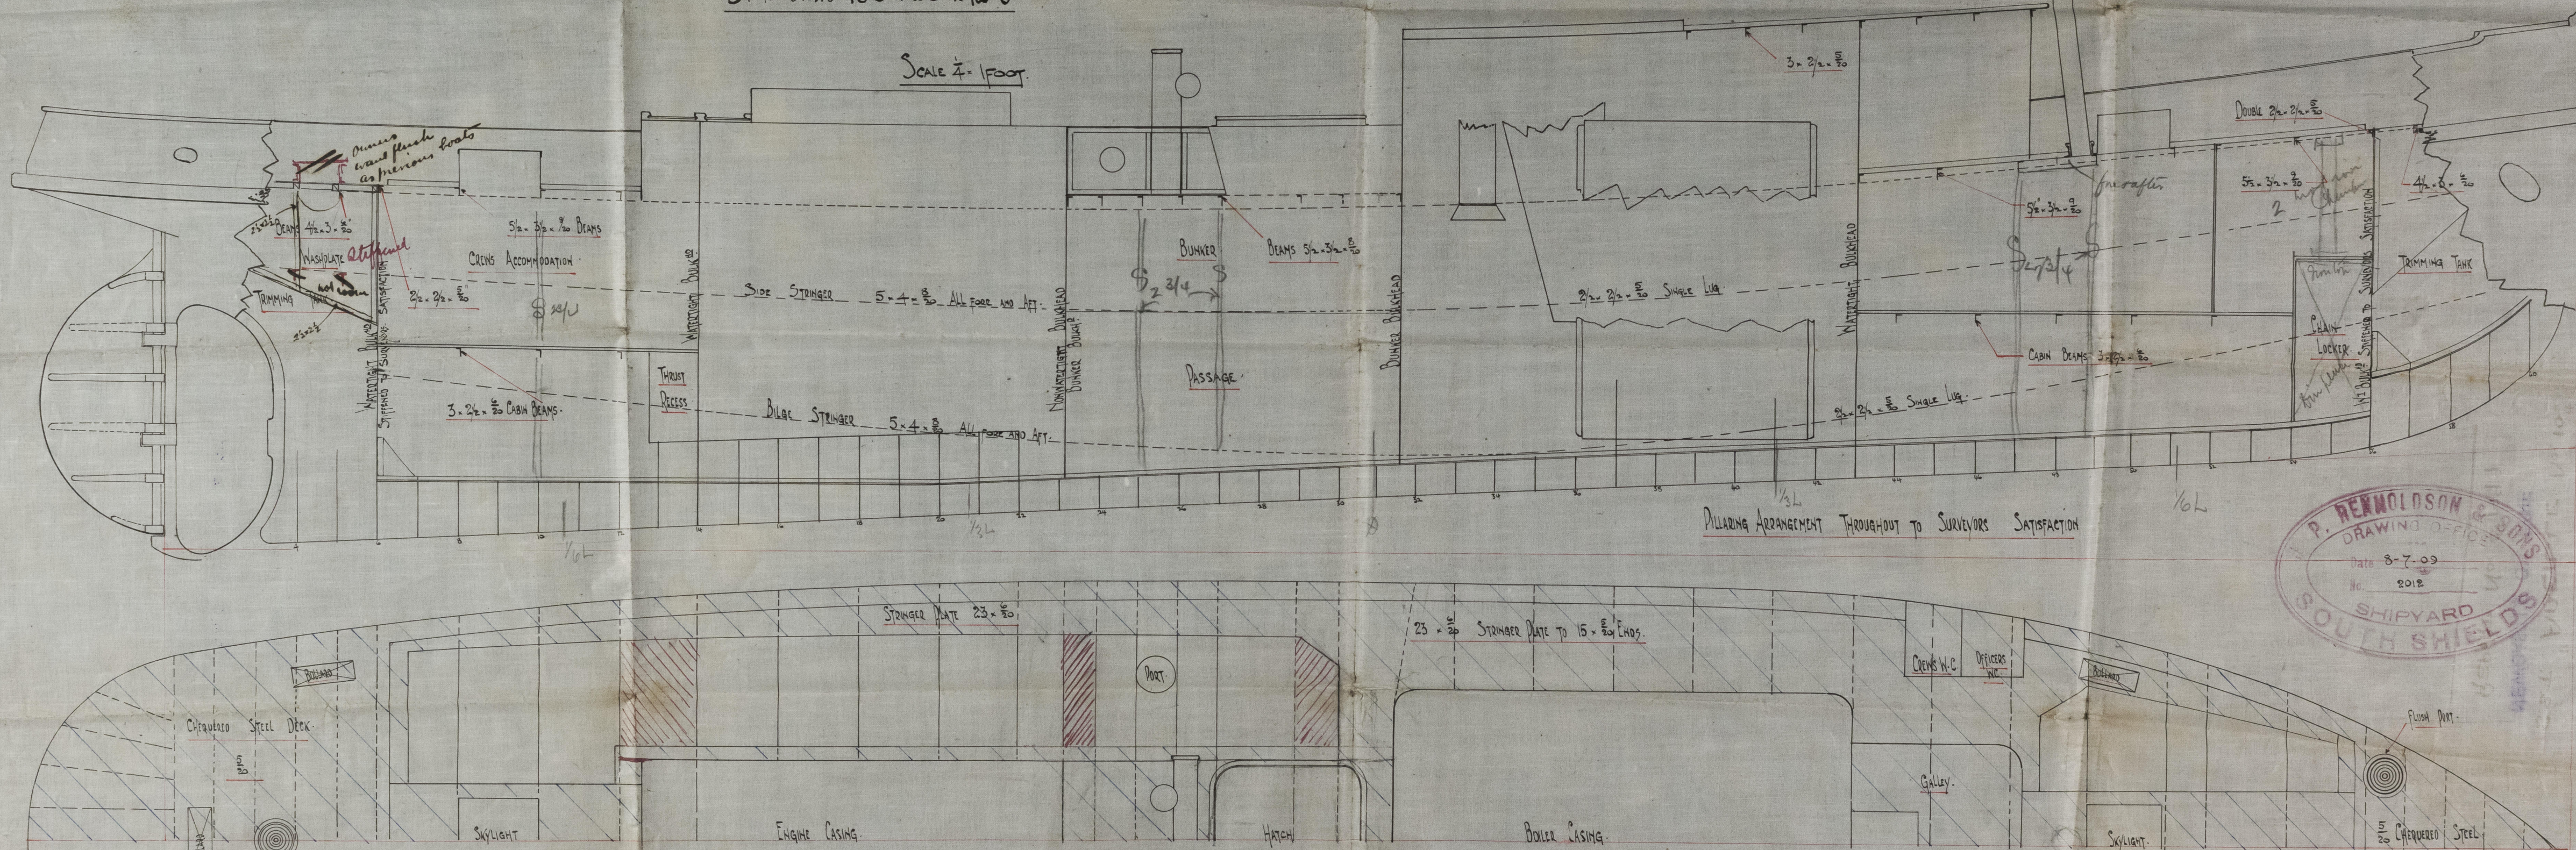

Profile & Deck
No 263
15.7.09

c.b.
15.7.09.



© 2021
Lloyd's Register
Foundation

J.P. RENNOLOSON'S
N^o 263

PROFILE + DECK.

S.S.T. "ABEILLE No. 10"
NEWCASTLE ON TYNE.

REPORT No. 57699



© 2021

Lloyd's Register
Foundation

007403-007411-0048