

MIDSHIP SECTION.

SSN° 217.

SCALE 1/2" = 1 FOOT.

LENGTH B.P. 375.0 BREADTH MLD 51.0 DEPTH MLD 26.1/2

NUMERALS


BREADTH MLD 51.0 ✓
 DEPTH MLD 26.12 ✓
 TRANSVERSE No 77.12 ✓
 LENGTH 374.6 ✓
 LONGITUDINAL No 28890 ✓
 ERECTIONS 2510 ✓
 EQUIPMENT No 31400 ✓
 L TO SHELTER DK 10.95 ✓
 C = 22.7 ✓

2.2.14

EQUIPMENT

2 BOWER ANCHORS 50 ACWT. STOCKLESS ✓
 1 STREAM 15 EX STOCK ✓
 1 KEDGE 6 1/2 ✓
 270 FATHOMS 2 1/2" JUD CHAIN CABLE ✓
 90 4 1/2 STEEL WIRE STREAM ✓
 120 TOWLINE ✓
 2.90 3 HANSEN'S OWNER ✓
 2.90 2 1/2 1. HANSEN'S OWNER ✓

may be 2 1/2"

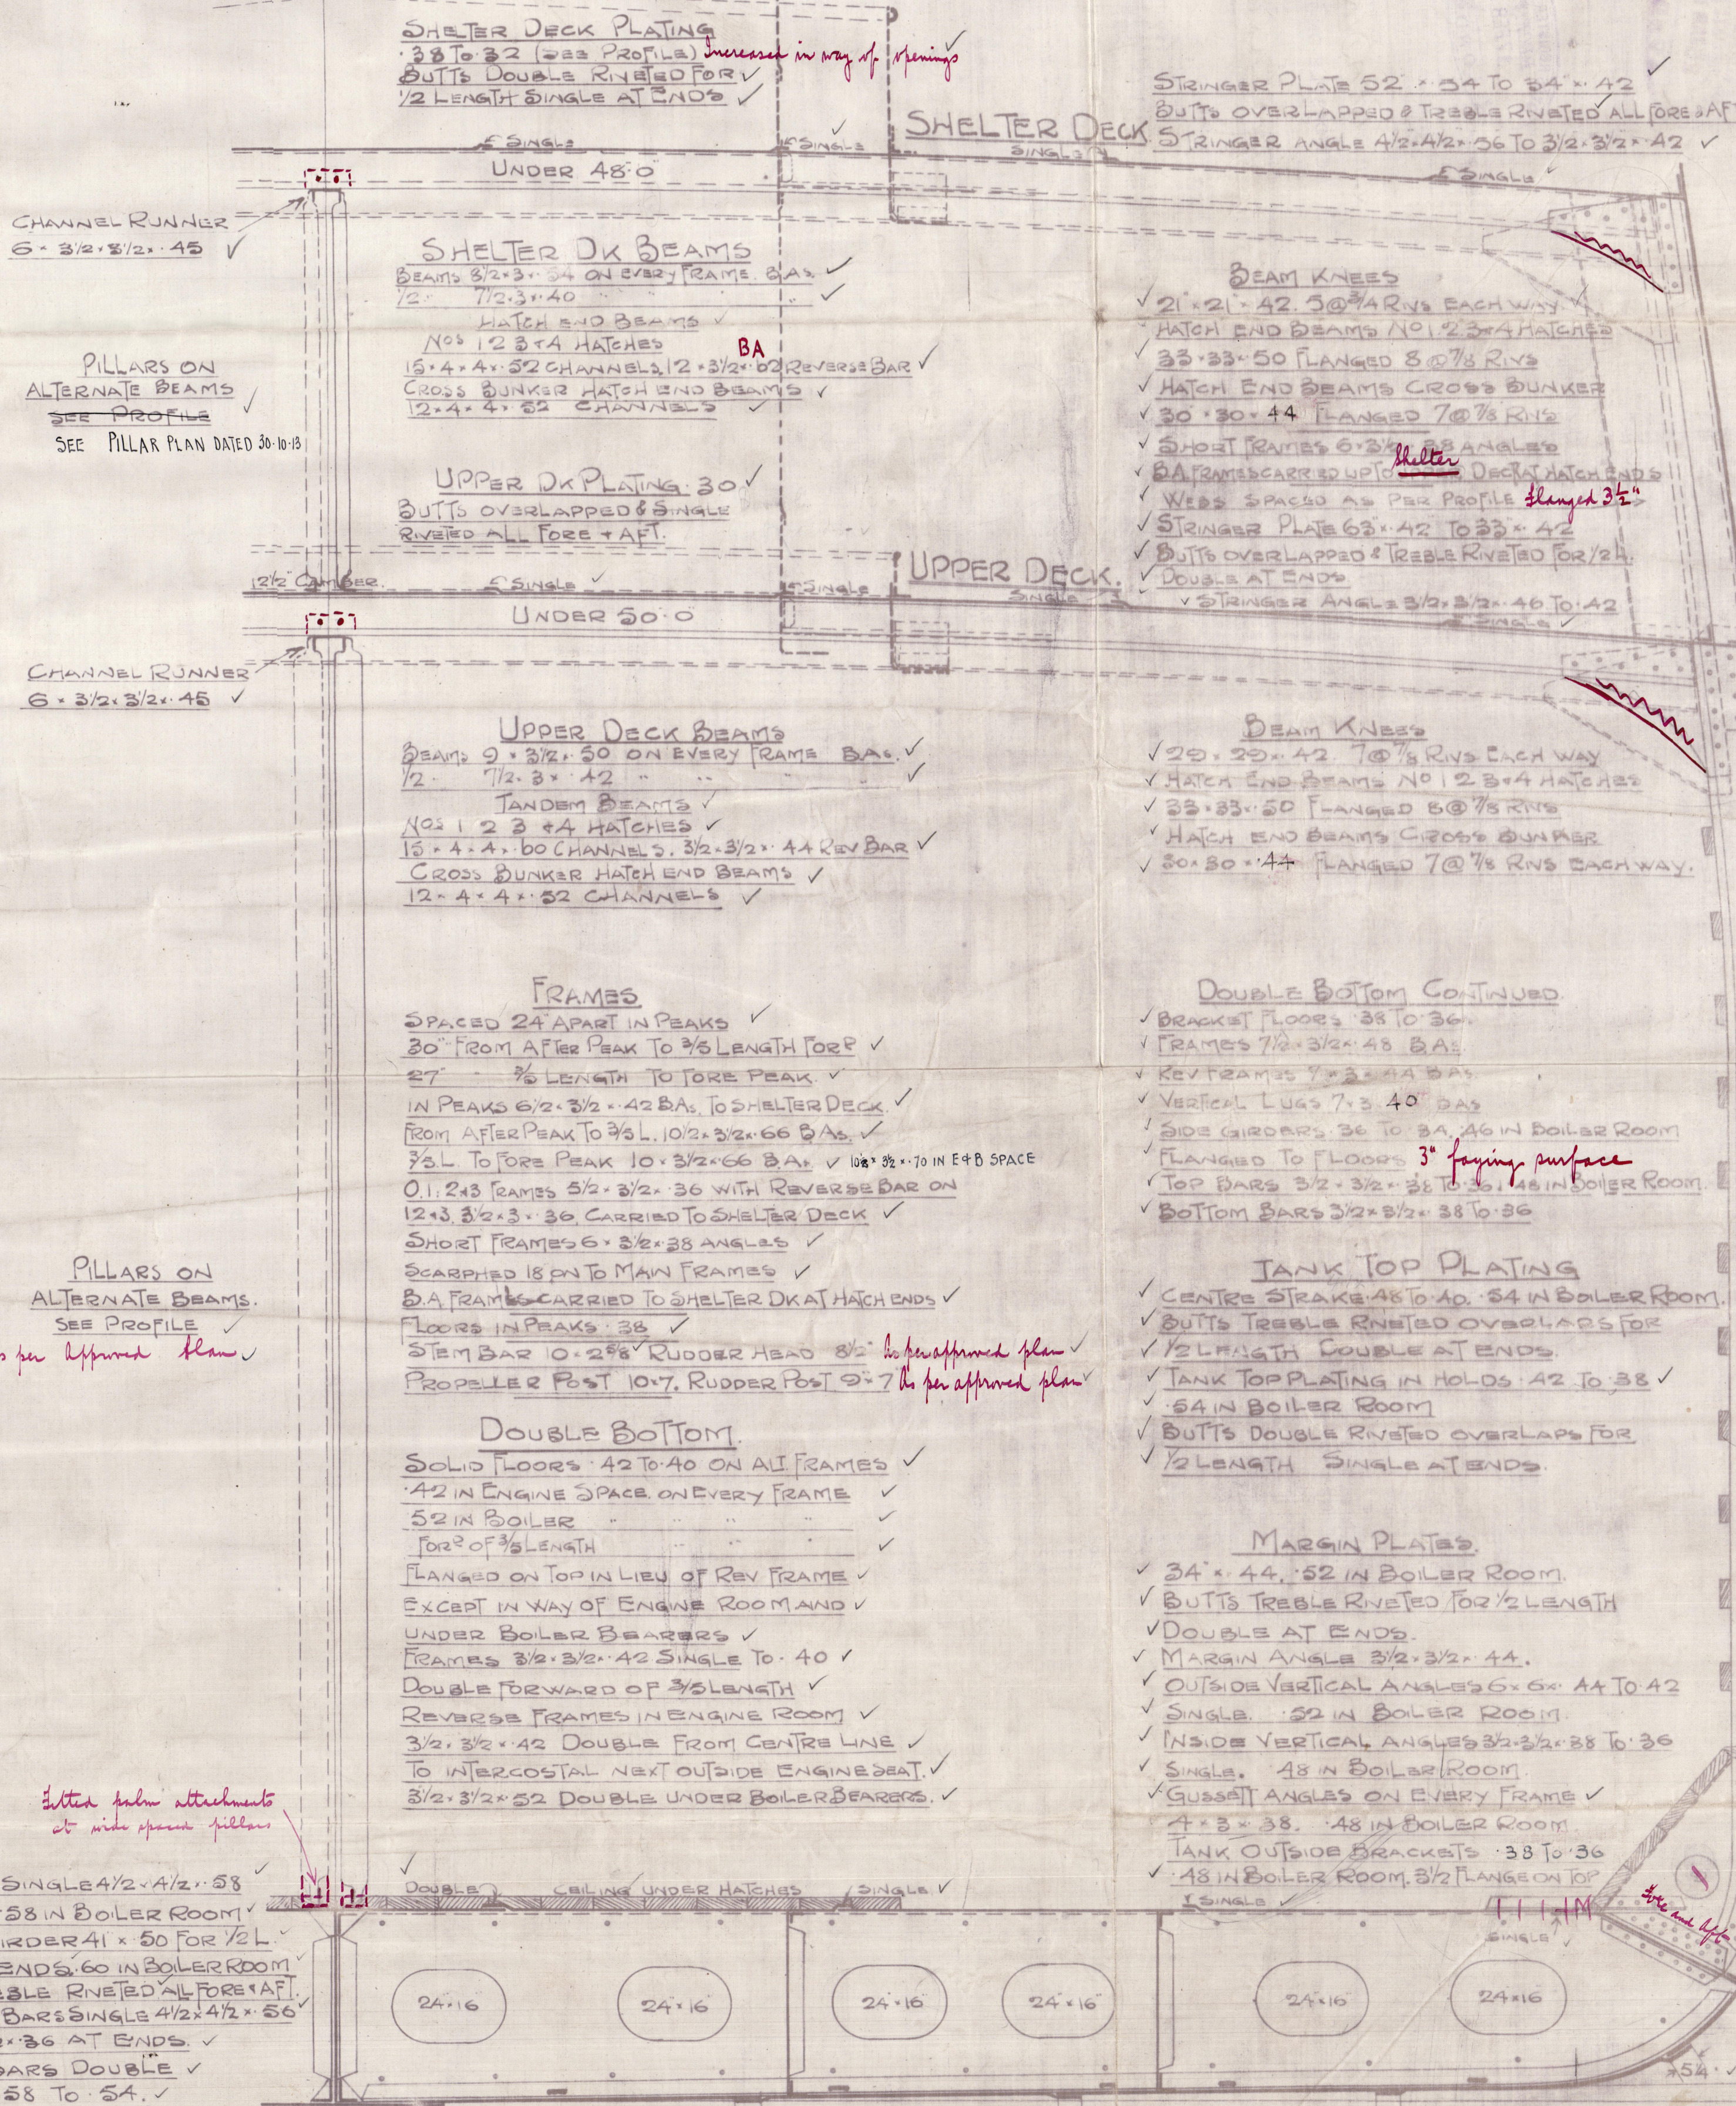

L STRAKE OUT

82 x 66 TO 44 ✓
 BUTTS QUADRUPL RIVETED ✓
 FOR 1/2 LENGTH TREBLE AT ENDS.

K STRAKE IN

75 x 60 TO 44 ✓
 BUTTS QUADRUPL RIVETED ✓
 FOR 1/2 LENGTH TREBLE AT ENDS.

J STRAKE OUT

71 x 68 TO 52. 44 IN PEAKS ✓
 BUTTS QUADRUPL RIVETED ✓
 FOR 1/2 LENGTH TREBLE AT ENDS.

H STRAKE IN

72 1/4 x 68 TO 52. 44 IN PEAKS ✓
 BUTTS QUADRUPL RIVETED ✓
 FOR 1/2 LENGTH TREBLE AT ENDS.

G STRAKE OUT

71 x 68 TO 52. 44 IN PEAKS ✓
 BUTTS QUADRUPL RIVETED ✓
 FOR 1/2 LENGTH TREBLE AT ENDS.

F STRAKE IN

68 1/4 x 66 TO 50 ✓
 BUTTS QUADRUPL RIVETED ✓
 FOR 1/2 LENGTH TREBLE AT ENDS.

1" rivets in frames, butts and seams

riveting to Surveyors satisfaction.

bottom strengthened forward as per rule




34 J. N. Oates

Northumberland S.B. Co.
No 217.

Amended plan of Midship Section
brought up to date for 30" frame spacing

FEB 6 1914

Stamos

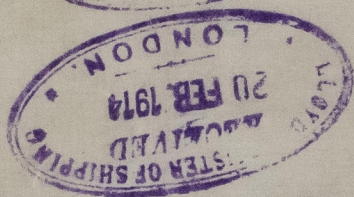

S.S. READING
NEWCASTLE-ON-TYNE.

Report No. 67082

cl
il
7

007412-007421-0217



© 2020

Lloyd's Register
Foundation