

MIDSHIP SECTION

P. S. N° 292.

DIMENSIONS


LENGTH OVERALL 154'-0", LENGTH B.P. 150'-0"
BREADTH MLD 30'-0", BREADTH OVER SPONSONS 48'-4"

DEPTH MLD 7'-8" SCALE 1/2" = 1 FOOT

CLASS. LLOYDS SPECIAL SURVEY FOR RIVER SERVICE ON
THE TAY WITH B.O.T. PASSENGER CERT. N° 4.5

NUMERALS		
DEPTH "D"		7.66
1 ST LONGITUDINAL N°	1149	
2 ND " " N°	5649	
0 TH	19.58	
1	7.00	

EQUIPMENT		
1 ANCHOR	6 1/4 cwt	STOCKLESS
60 FATHOMS	3/8" STUD	LINK CABLE
120 "	5/4" MANILLA	
10 "	HEAVING LINE	

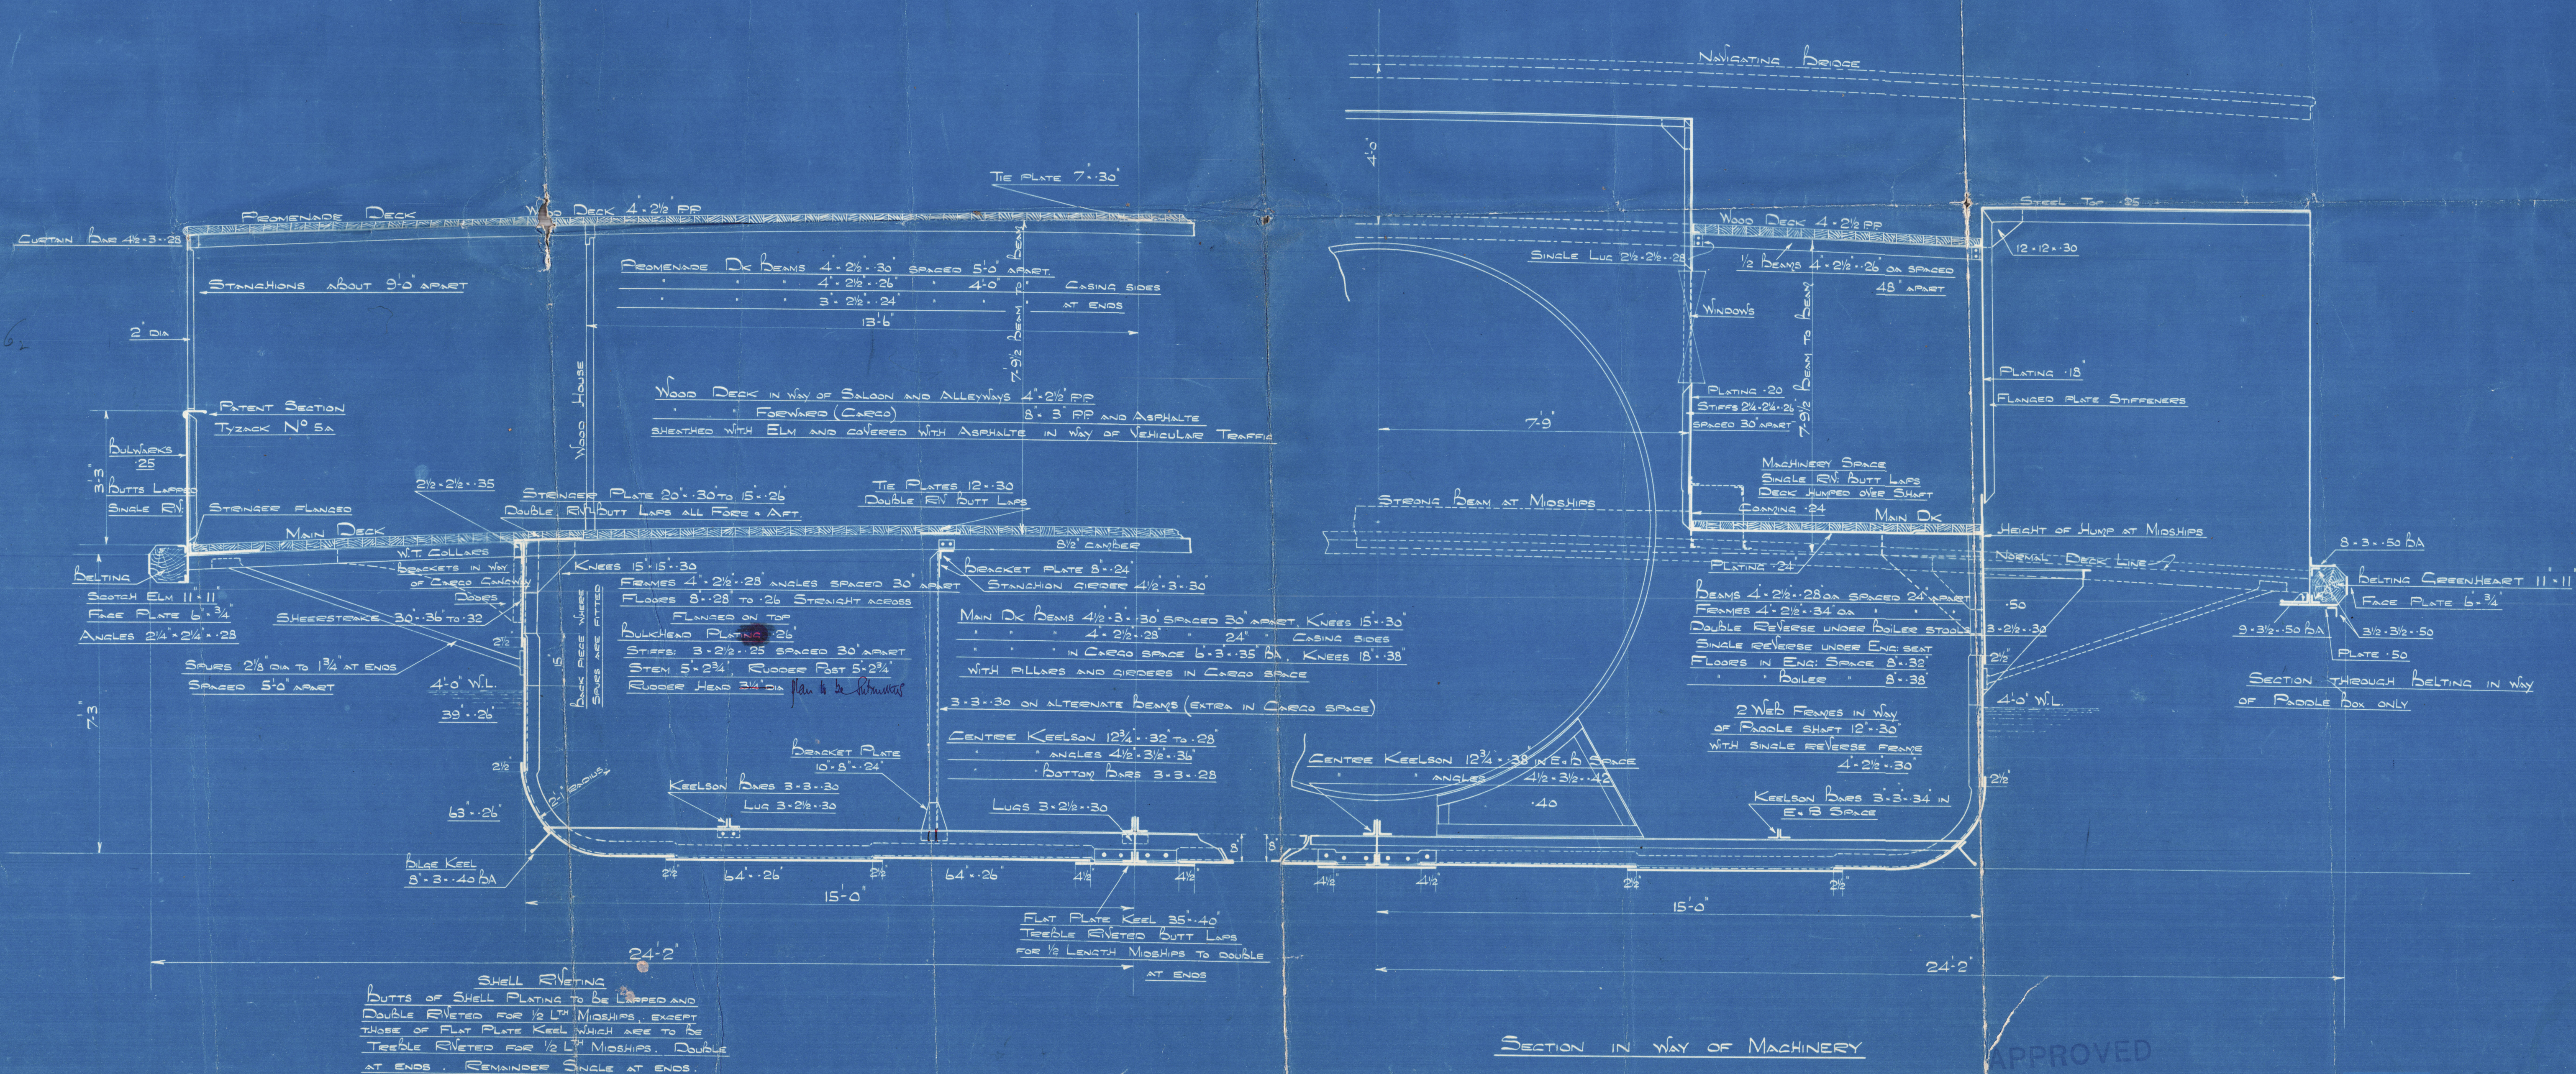

SECTION IN WAY OF MACHINERY

APPROVED
LLOYD'S REGISTER OF SHIPPING
14.11.23

Caledon S.B. & L. Co

P. S. 292

Midship Section

"William High"

Dumdee Rpt. No. 8495.

