


CLASS "100A" ~~WITH DEEP KEEL~~ OF HULL  
DRAFT NOT LESS THAN 18'-6" MLD.

APPROVED

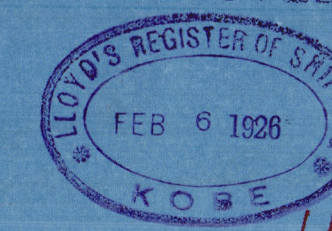



*hmdm*

S.S. "TSUKUSHI MARU NO.2"

YKA. 3845.

Ship's Name or No. <b>316</b>	
Name	<b>MIDSHIP SECTION</b>
of	
Drawing	<b>( Altered )</b>
Drawing No.	Sending No.

**GEN. BOX NO** *855*



*Kali*



© 2021

Lloyd's Register  
Foundation

007456-007464-0172