

Nº	ORDS	SM	PRODUCT	½ ORDS	PRODUCT
1	16	60	960	8	480
2	2	14	28	1	14
3	3	30	90	1 1/2	45
4	4	00	00	2	00
4 1/2	4	00	00	2	00
5	1	75	75	0 1/2	37 1/2
			4040		73 59 1/2
			145		
			20200		
			16160		7359
			4040		4040
			585800		

$1.82' + .375' = 2.195'$
 $58.58 \times 2.195 = 128.583$

AREA OF RUDDER = 58.58 SQUARE FEET

DISTANCE OF C.G. OF RUDDER AFT OF CENTRE LINE OF PINTLES = 2.195'

SPEED UNDER 10 KNOTS

RUDDER STOPPERS A & B

SCALE 1/4" = 1'


TEMPLATES FOR STOPPERS WILL BE SENT

COUPLING


SCALE 1/4" = 1'

RUDDER PLAN. Nº 306.

SCALE 1/2" = 1 FOOT

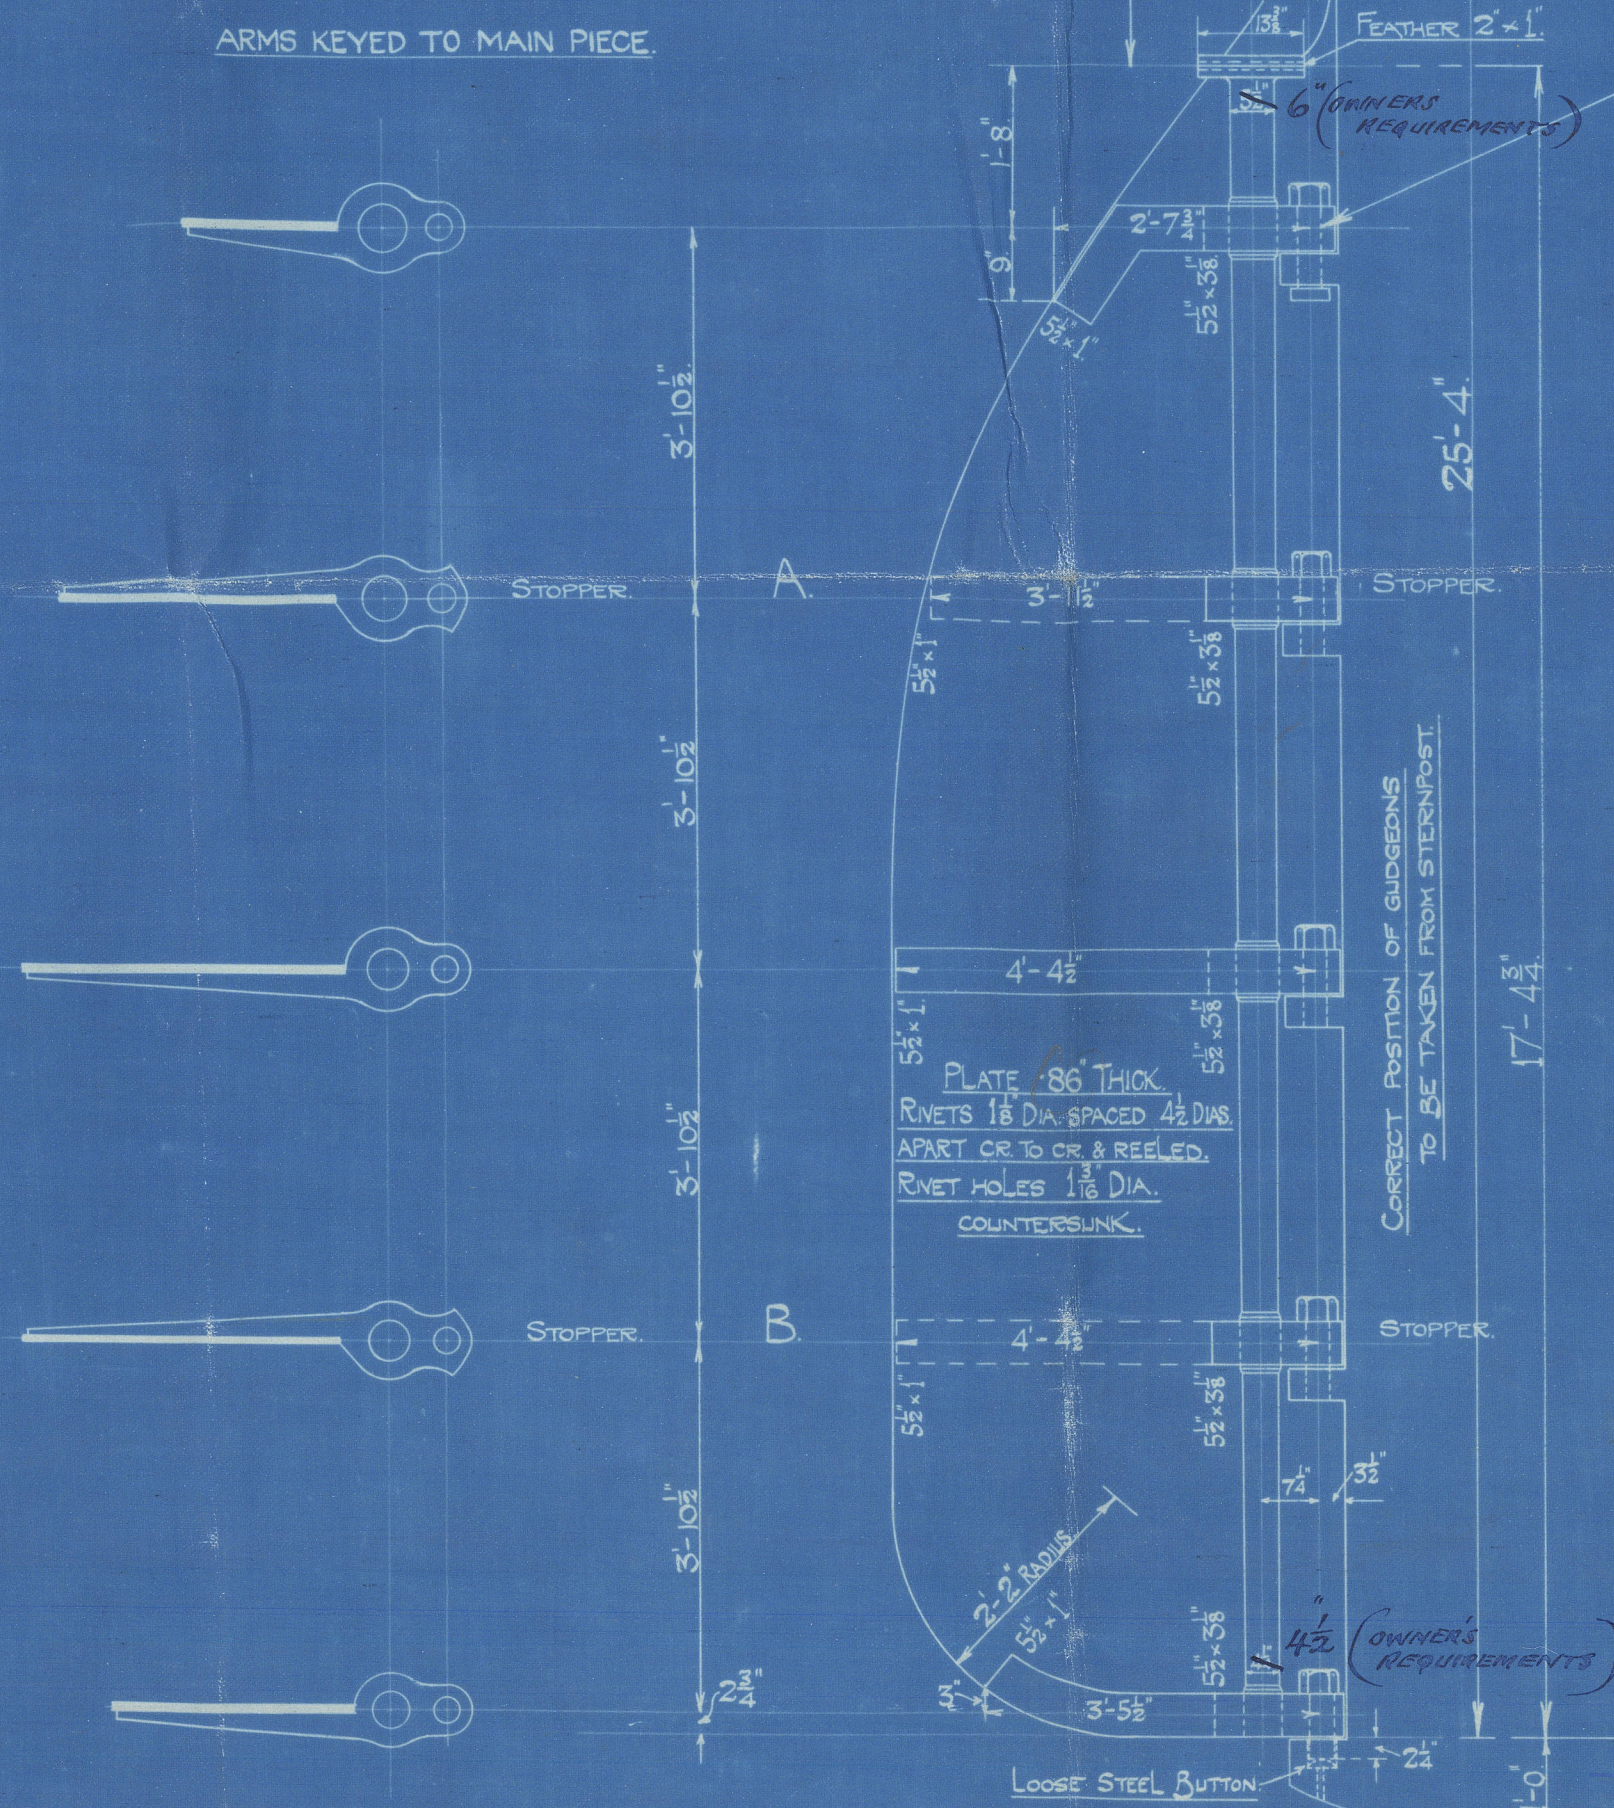

S. P. AUSTIN & SON, LTD.
 SHIPBUILDERS & REPAIRERS,
 WEAR DOCK YARD,
 SUNDERLAND.
 Date 29/12/23
 Reference No. 40396

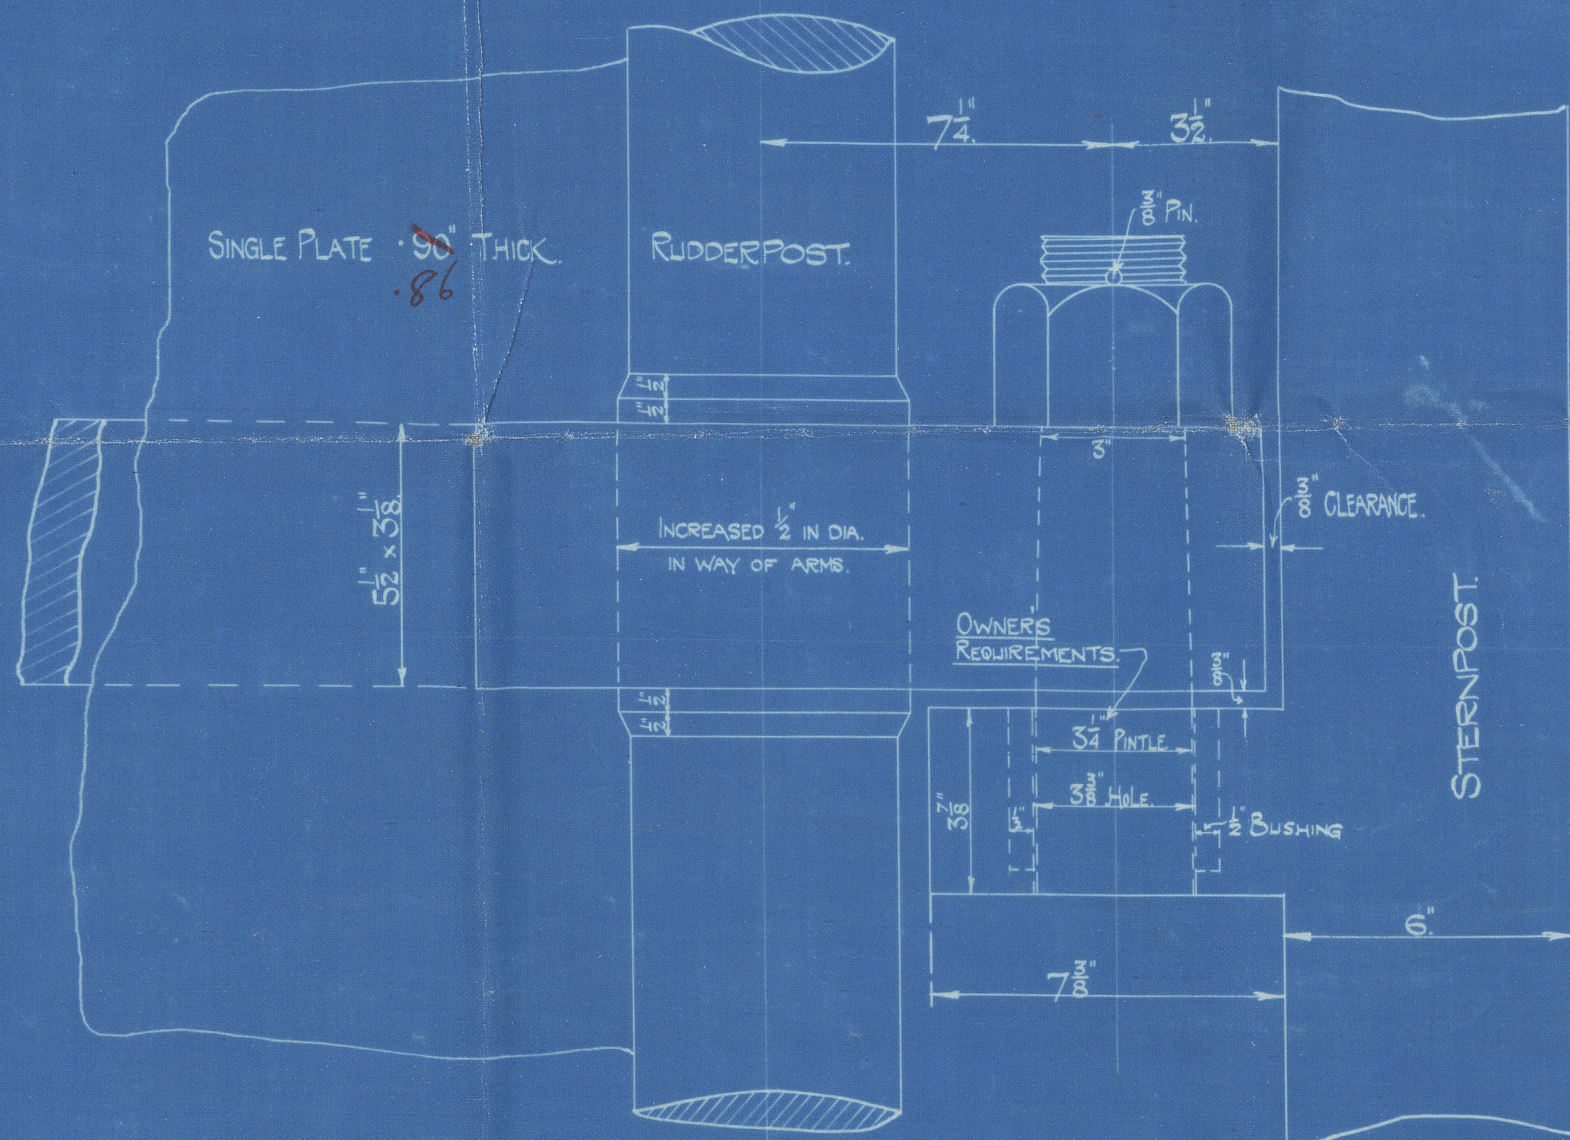

S.D.
 29/12/23

Sundland.

S. J. Austin & Son

— N^o 306 —

Kudde Flare.

(Duplicate).

Eastern Trader
S.S. TAMWORTH^{ex}

SLDRPT N^o 28883



© 2020

Lloyd's Register

Foundation

007620-007625-0039