

舵

第百七拾番船

縮尺二分一吋トス

御承認用




563

S. No 170

RUDDER.

SCALE 1/2" TO A FT.

DETAILS 1" TO A FT.

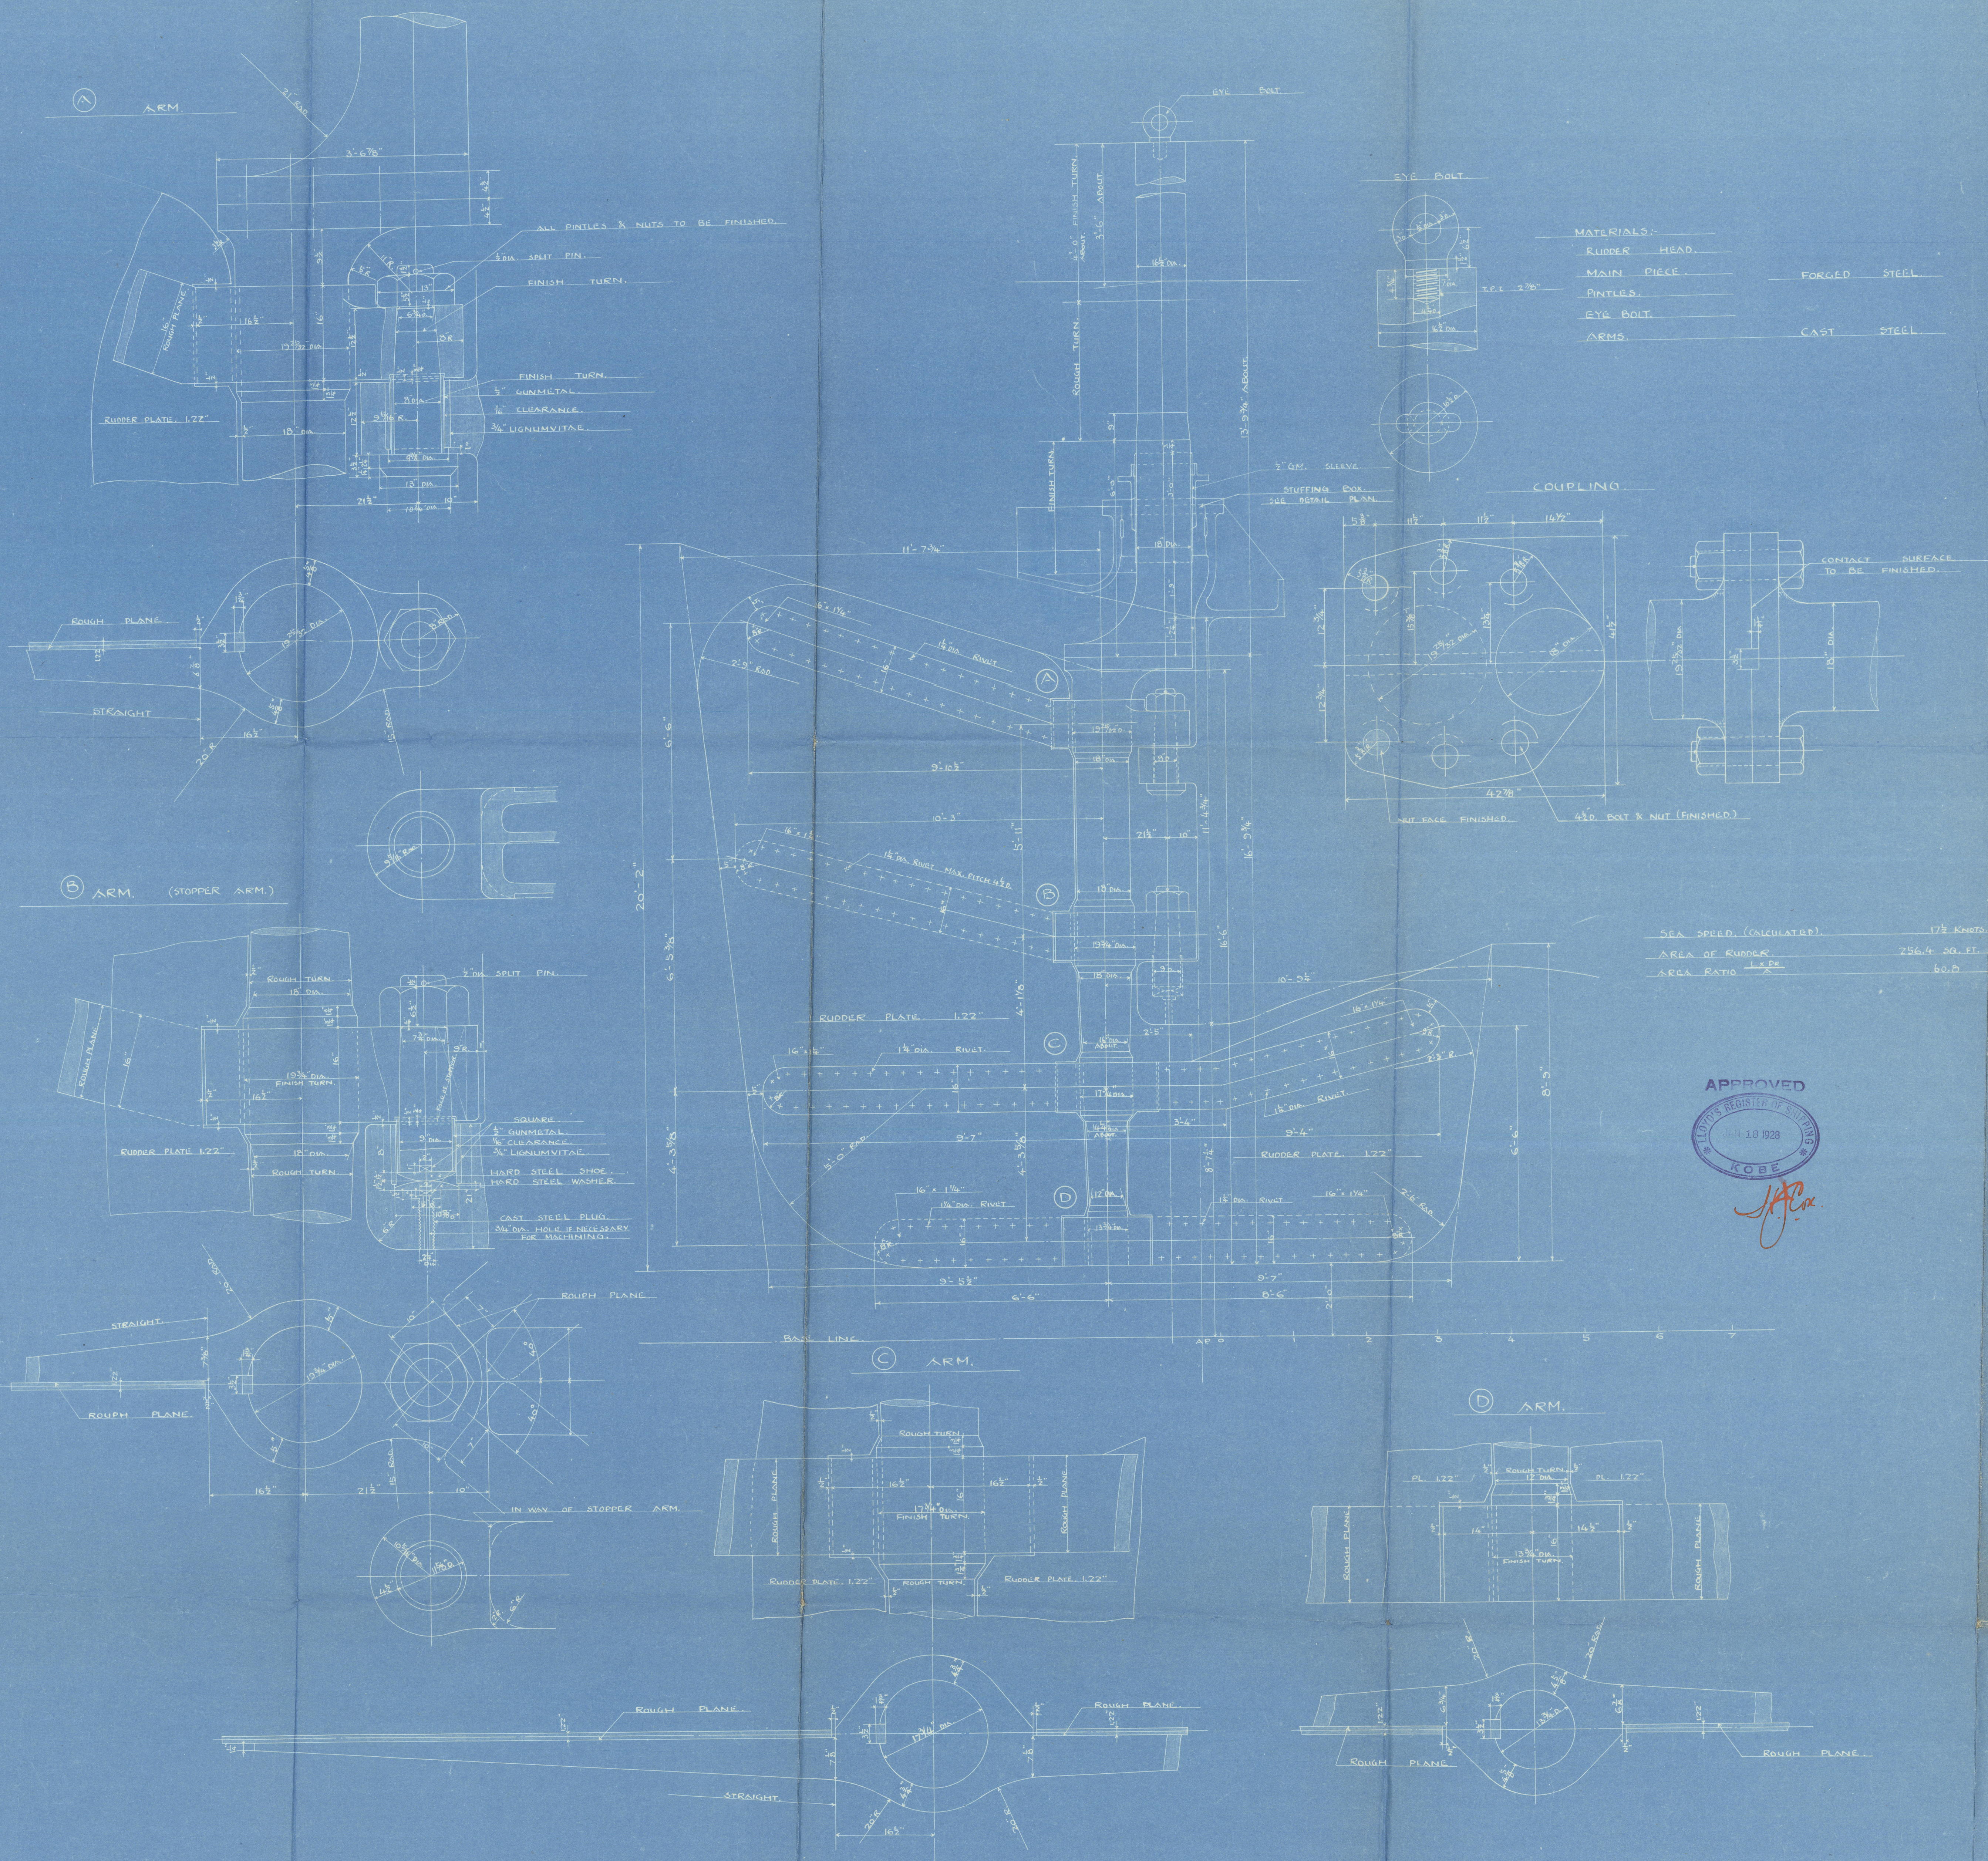

舵

第百七拾番船

縮尺二分一吋ヲ以テス

御承認用



503

S. No 170.

RUDDER.

SCALE 1/2" TO A FT.


DETAILS 1" TO A FT.

Lloyd's

"Kamakura Maru"

ex
"Chichibu Maru"
yka. 4500

GEN. BOX NO 351

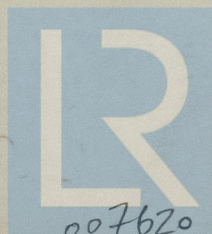

© 2020

Lloyd's Register
Foundation

007620 - 007625 - 0087