


Nº 591 SHIP.


ALTERNATIVE STERNFRAMES

SCALE 1" = 1 FOOT

OUTLINE OF FORGED STEEL STERNFRAME

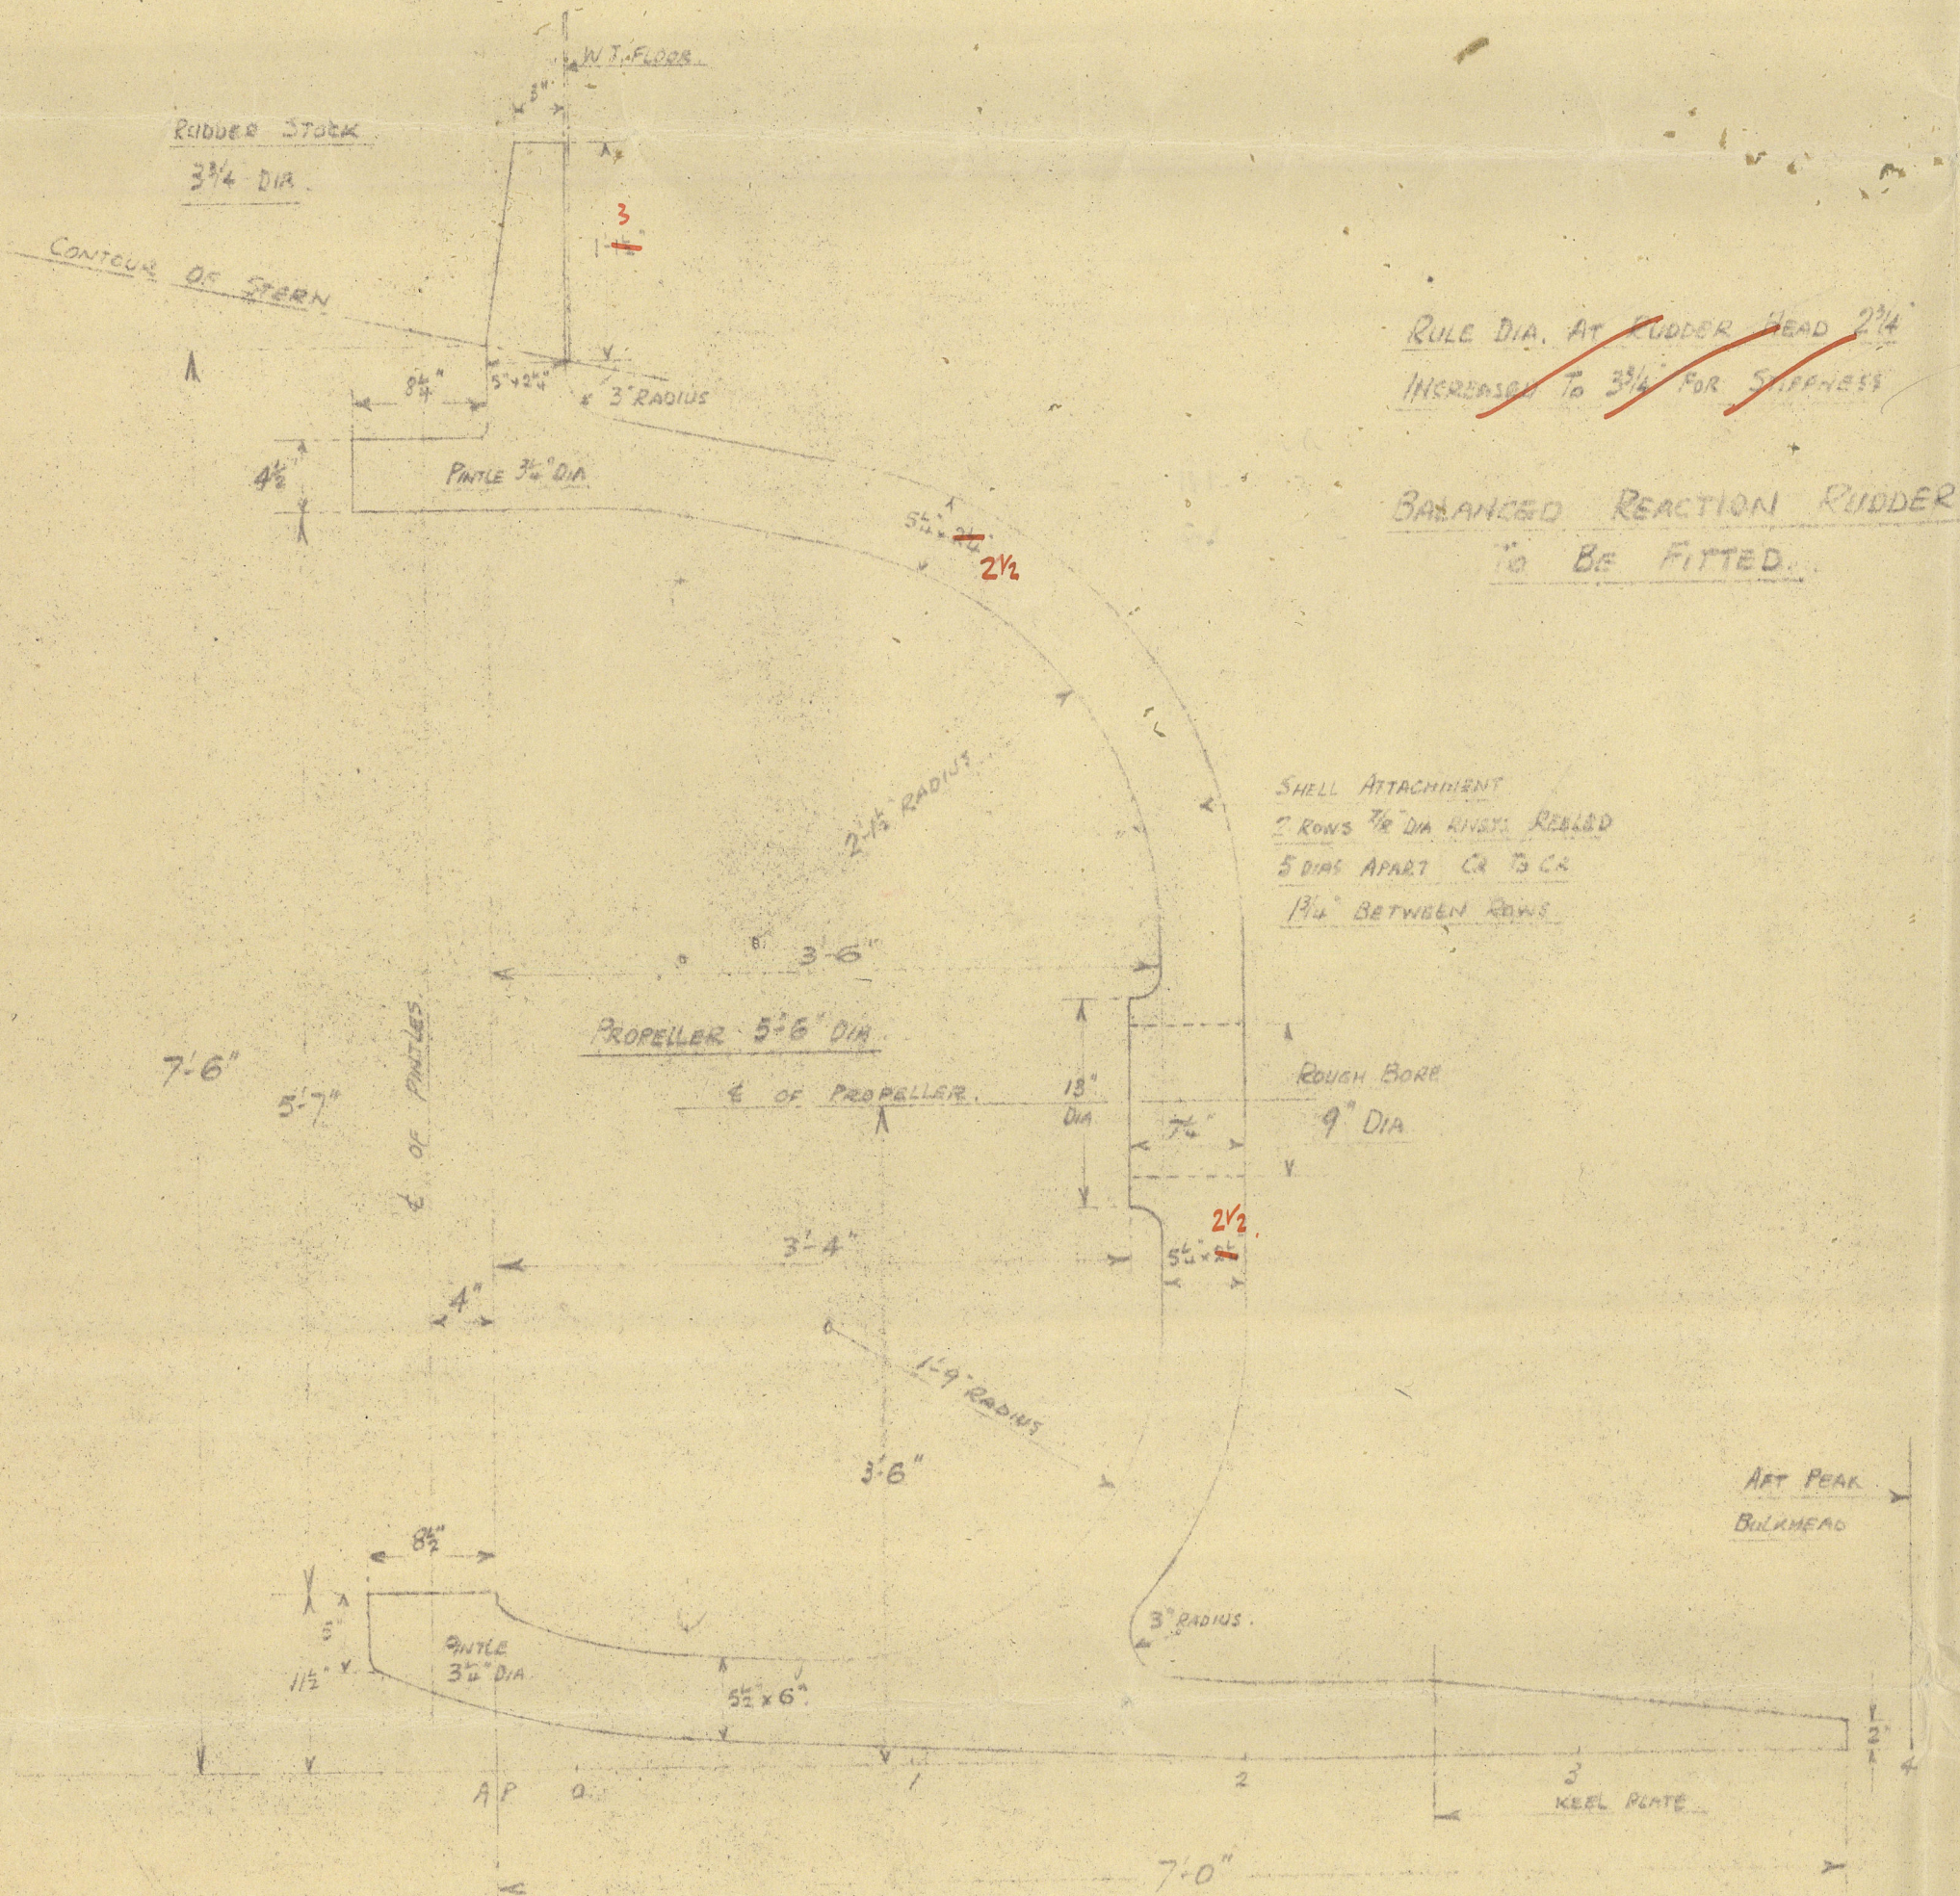

OUTLINE OF CAST STEEL STERNFRAME

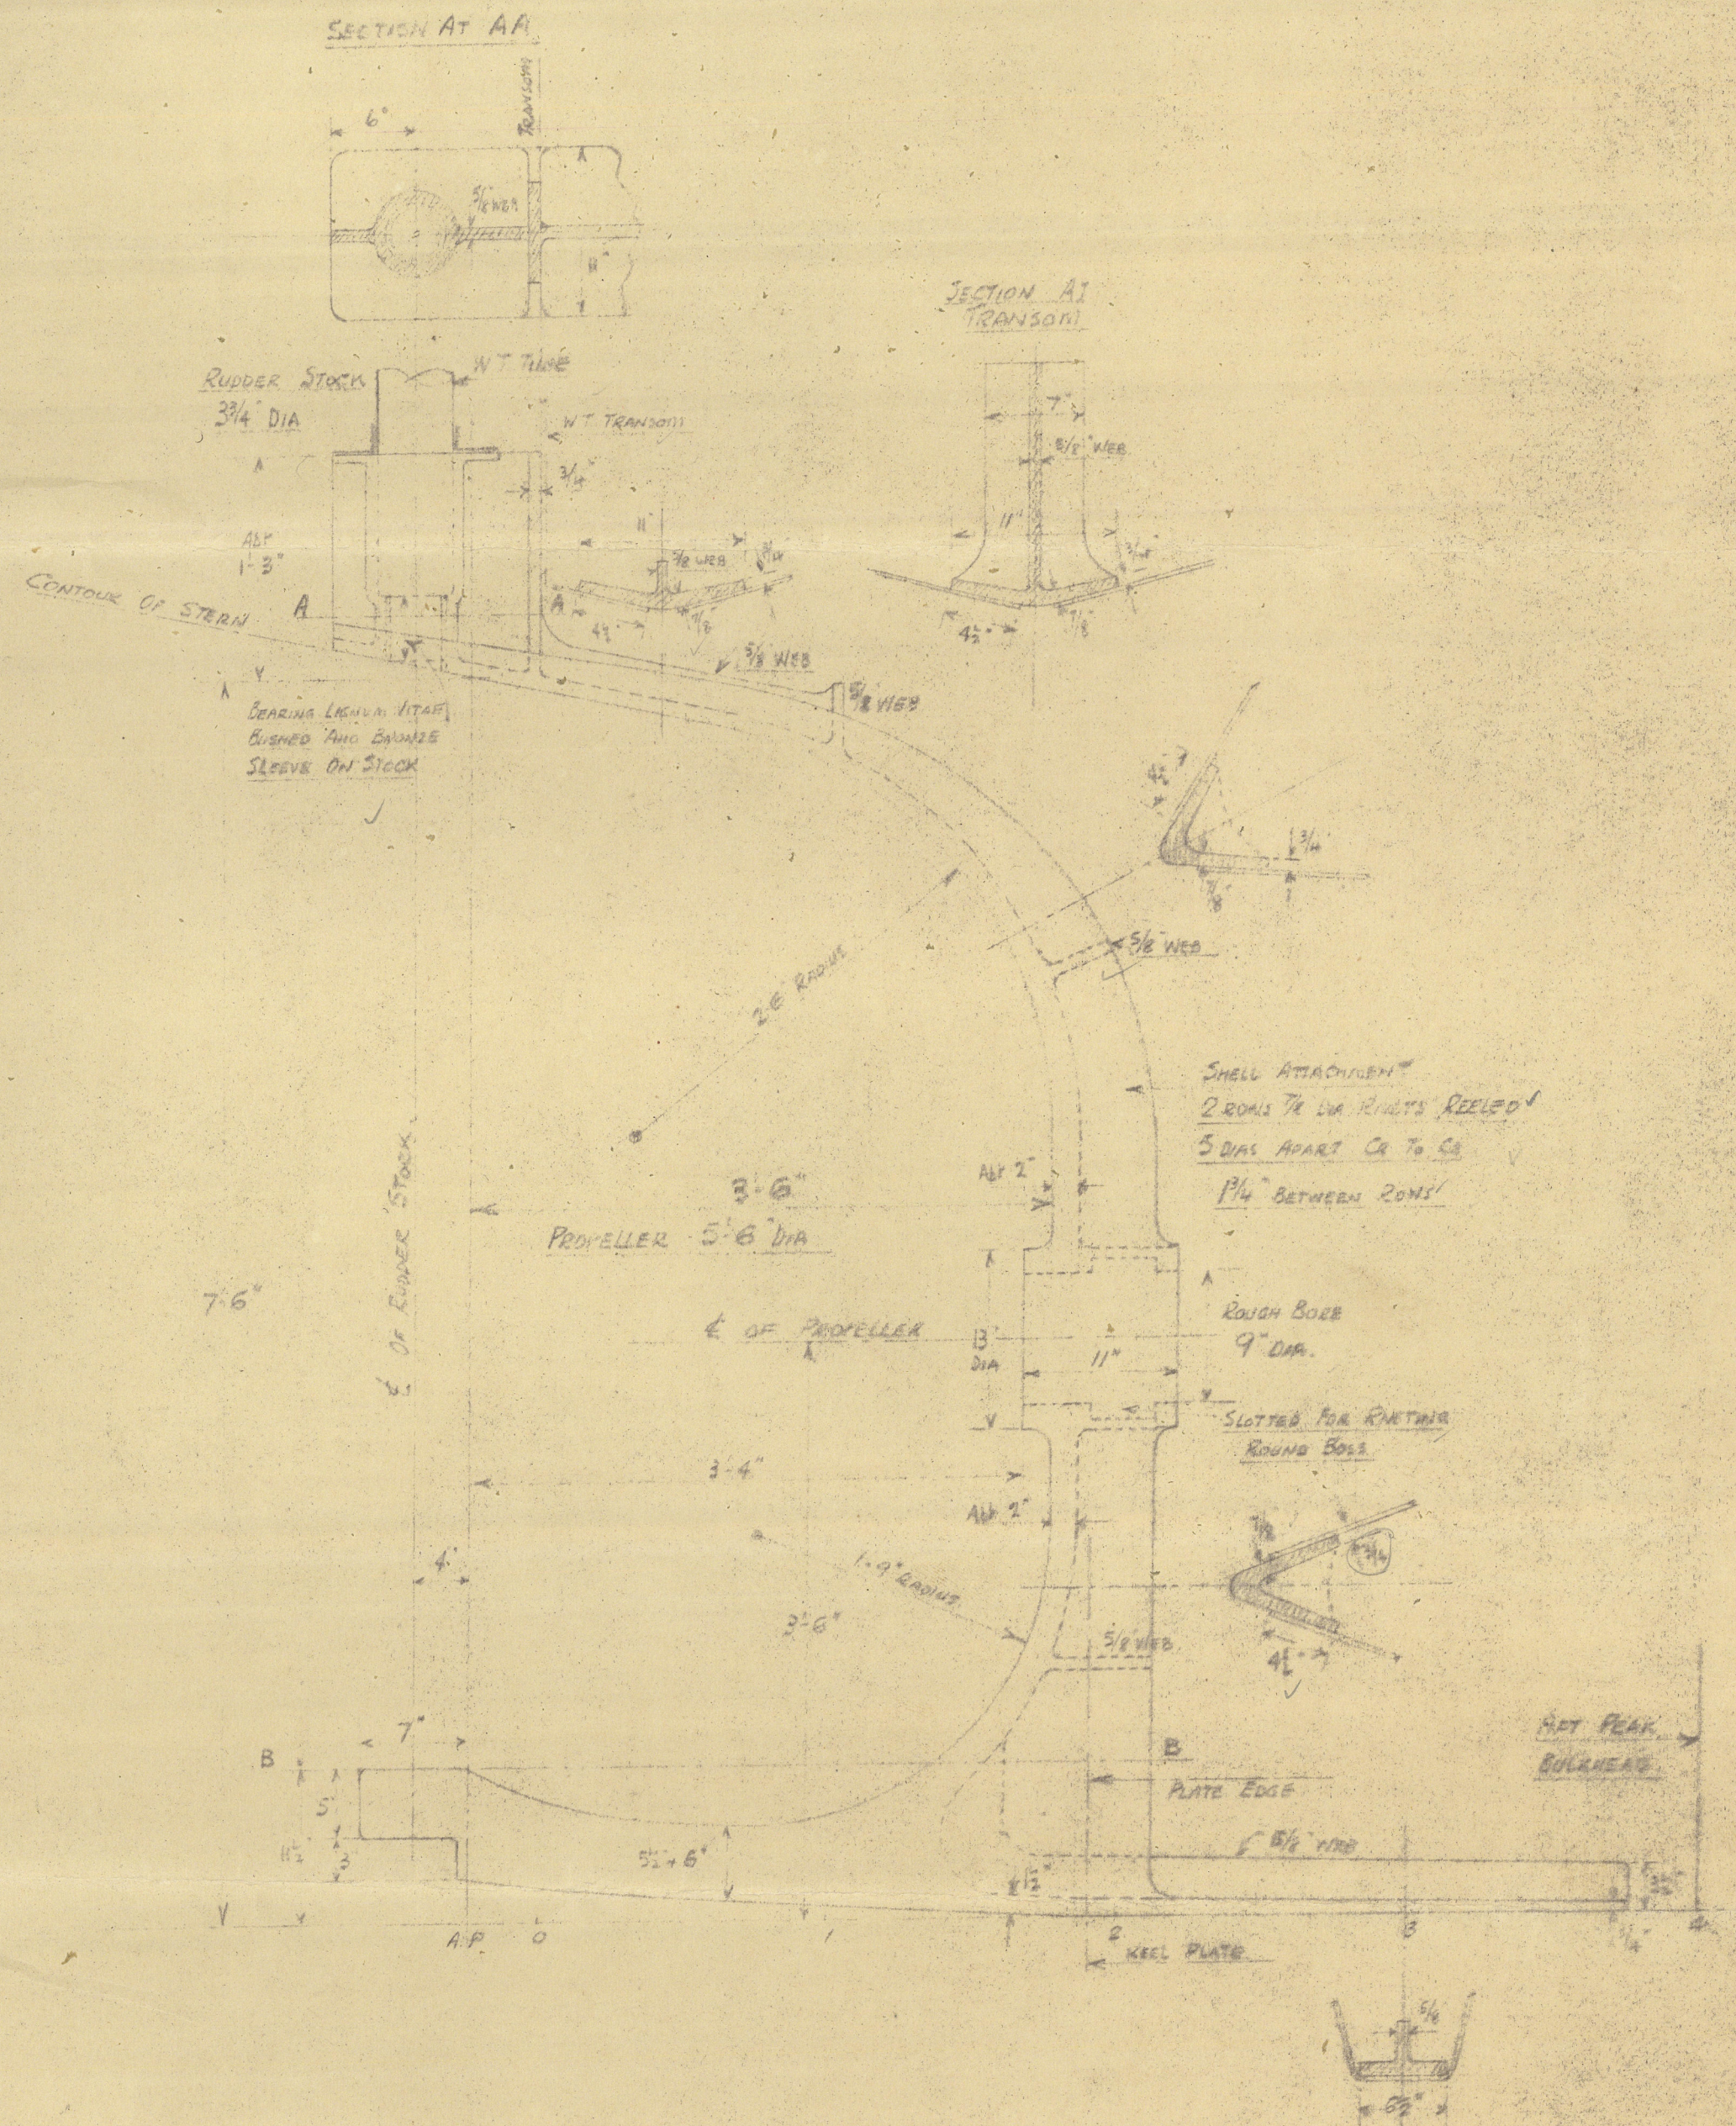

~~GEN. BOX NO~~ 90

3

HAWTHORN LESLIE'S

Nº 591

Rock. Nuc. 90909

ALTERNATIVE STERFRAMES



© 2020

Lloyd's Register
Foundation

007714-007721-0231