

For the information of Surveyors and the Committee only.

Received at _____ Office _____ 19__

Lloyd's Register of Shipping.

(Report on Vessel No. 90909 Port Newcastle)

No. _____ SHIP FORGINGS ~~OR~~ CASTINGS.

I have to report that the undermentioned ^{Scrap} ~~Iron~~ or Steel Forgings ~~or~~ Castings, manufactured by Messrs J.S. Forster & Son Ltd. of Sunderland for the Vessel No. 591, being built by Messrs Harthorn Leslie Ltd of Webburn-on-Tyne have been inspected by me as set forth below and found to be, so far as can be seen, Sound.


Report on Forgings or Castings.

Lloyd's
No. 7036
JD.28.9.33

J Dale
Sunderland

	STERN FRAME.	RUDDER FRAME.	STEM.
Material	<i>Scrap Steel</i>		
How made	<i>Forged & Smithed</i>		
Annealed			
Dimensions	<i>5 1/4 x 2 1/2</i>		
Process on Inspection	<i>Forging & Smithing</i>		
Date when Inspected	<i>28.9.33</i>		
CASTINGS.			
Tests on Standard Test Pieces.			
Tensile Test—			
Tons per square inch			
Extension per cent.			
90° Bending Test—			
Angle before fracture			
Drop Test—			
Height from ground			
Numbering Test—			
If made according to Rules and found satisfactory			

SKETCHES OF FRAMES SHOWING POSITION AND DESCRIPTION OF WELDS OF FORGINGS.

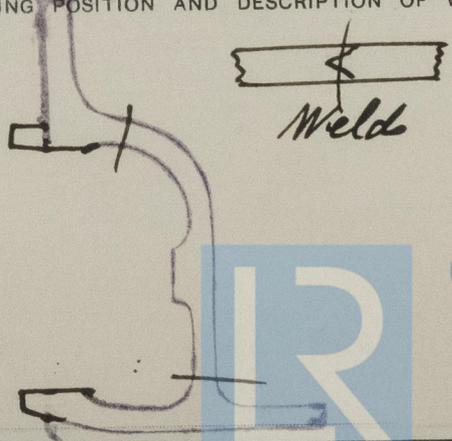

Fee (if any chargeable) £
To be paid at _____

© 2020
Lloyd's Register
Foundation

If of Iron, state whether scrap or puddled Iron. If of Steel, state whether made on the Open Hearth process.

120121-0219