

STANDARD STEAMER TYPE C. MIDSHIP SECTION.

Nº 284.

SCALE $\frac{1}{2}$ = 1 FOOT.

DIMENSIONS 331'-0" B.P. x 46'-6" MLD x 25'-6" MLD.

CLASS: 100.A.1.LLOYDS.

	POOP	FORECASTLE
SIDE PLATING	36"	38"
STRINGER PLT.	32" x 32"	32" x 32"
" ANGLE	3 1/2" x 3 1/2" x 32"	3 1/2" x 3 1/2" x 32"
DECK PLATING	32"	32"
BEAMS	7" x 3" x 36" B.A.	8" x 3" x 44" B.A.
BEAM KNEES	20" x 40"	20" x 40"
PILLARS	2 1/4"	2 1/4"

LLOYDS NUMERALS.

MOULDED BREADTH (B) = 46.5
 " DEPTH (D) = 25.5
 B + D = 72.0 = 1ST Nº
 LENGTH (L) = 331
 L x (B + D) = 23832 = 2ND Nº
 LENGTHS TO DEPTH B.D. = 10.03
 " " " U.D. = 12.98
 d = 22.25
 d WITH INCREASED BRACKETS = 20.70
 SHEER FOR 8'-6" LEN. FOR 4'-8"
 " AFT 4'-3" " " AFT 2'-4"


EQUIPMENT NUMERAL.

L x (B + D)
 = 331 x (46.5 + 25.5) 23832.00
 ERECTIONS:
 BRIDGE = 32.92
 FORECL. = 98.00
 POOP = 28.58
 159.5 x 75.75 = 897.19

CASING & HOUSES = 252.40
 EQUIPMENT Nº 24981.59

EQUIPMENT.

2 BOWER ANCHORS STOCKLESS 45 CENTS } 128 CENTS TOTAL
 1 " " " 38 " }
 1 STREAM ANCHOR EX. STOCK 12 "
 1 KEDGE " " " 5 1/2 "
 270 FATHOMS 1 1/2" STUD CHAIN CABLE
 90 " 4 1/2" STEEL WIRE
 100 FMS 4" STEEL WIRE STREAM
 1-90 FMS 7" HAWSER - 81-90 FMS 2 1/2" STEEL WIRE.
 1-90 FMS 6" HAWSER - 81-90 FMS 2 1/2" STEEL WIRE.

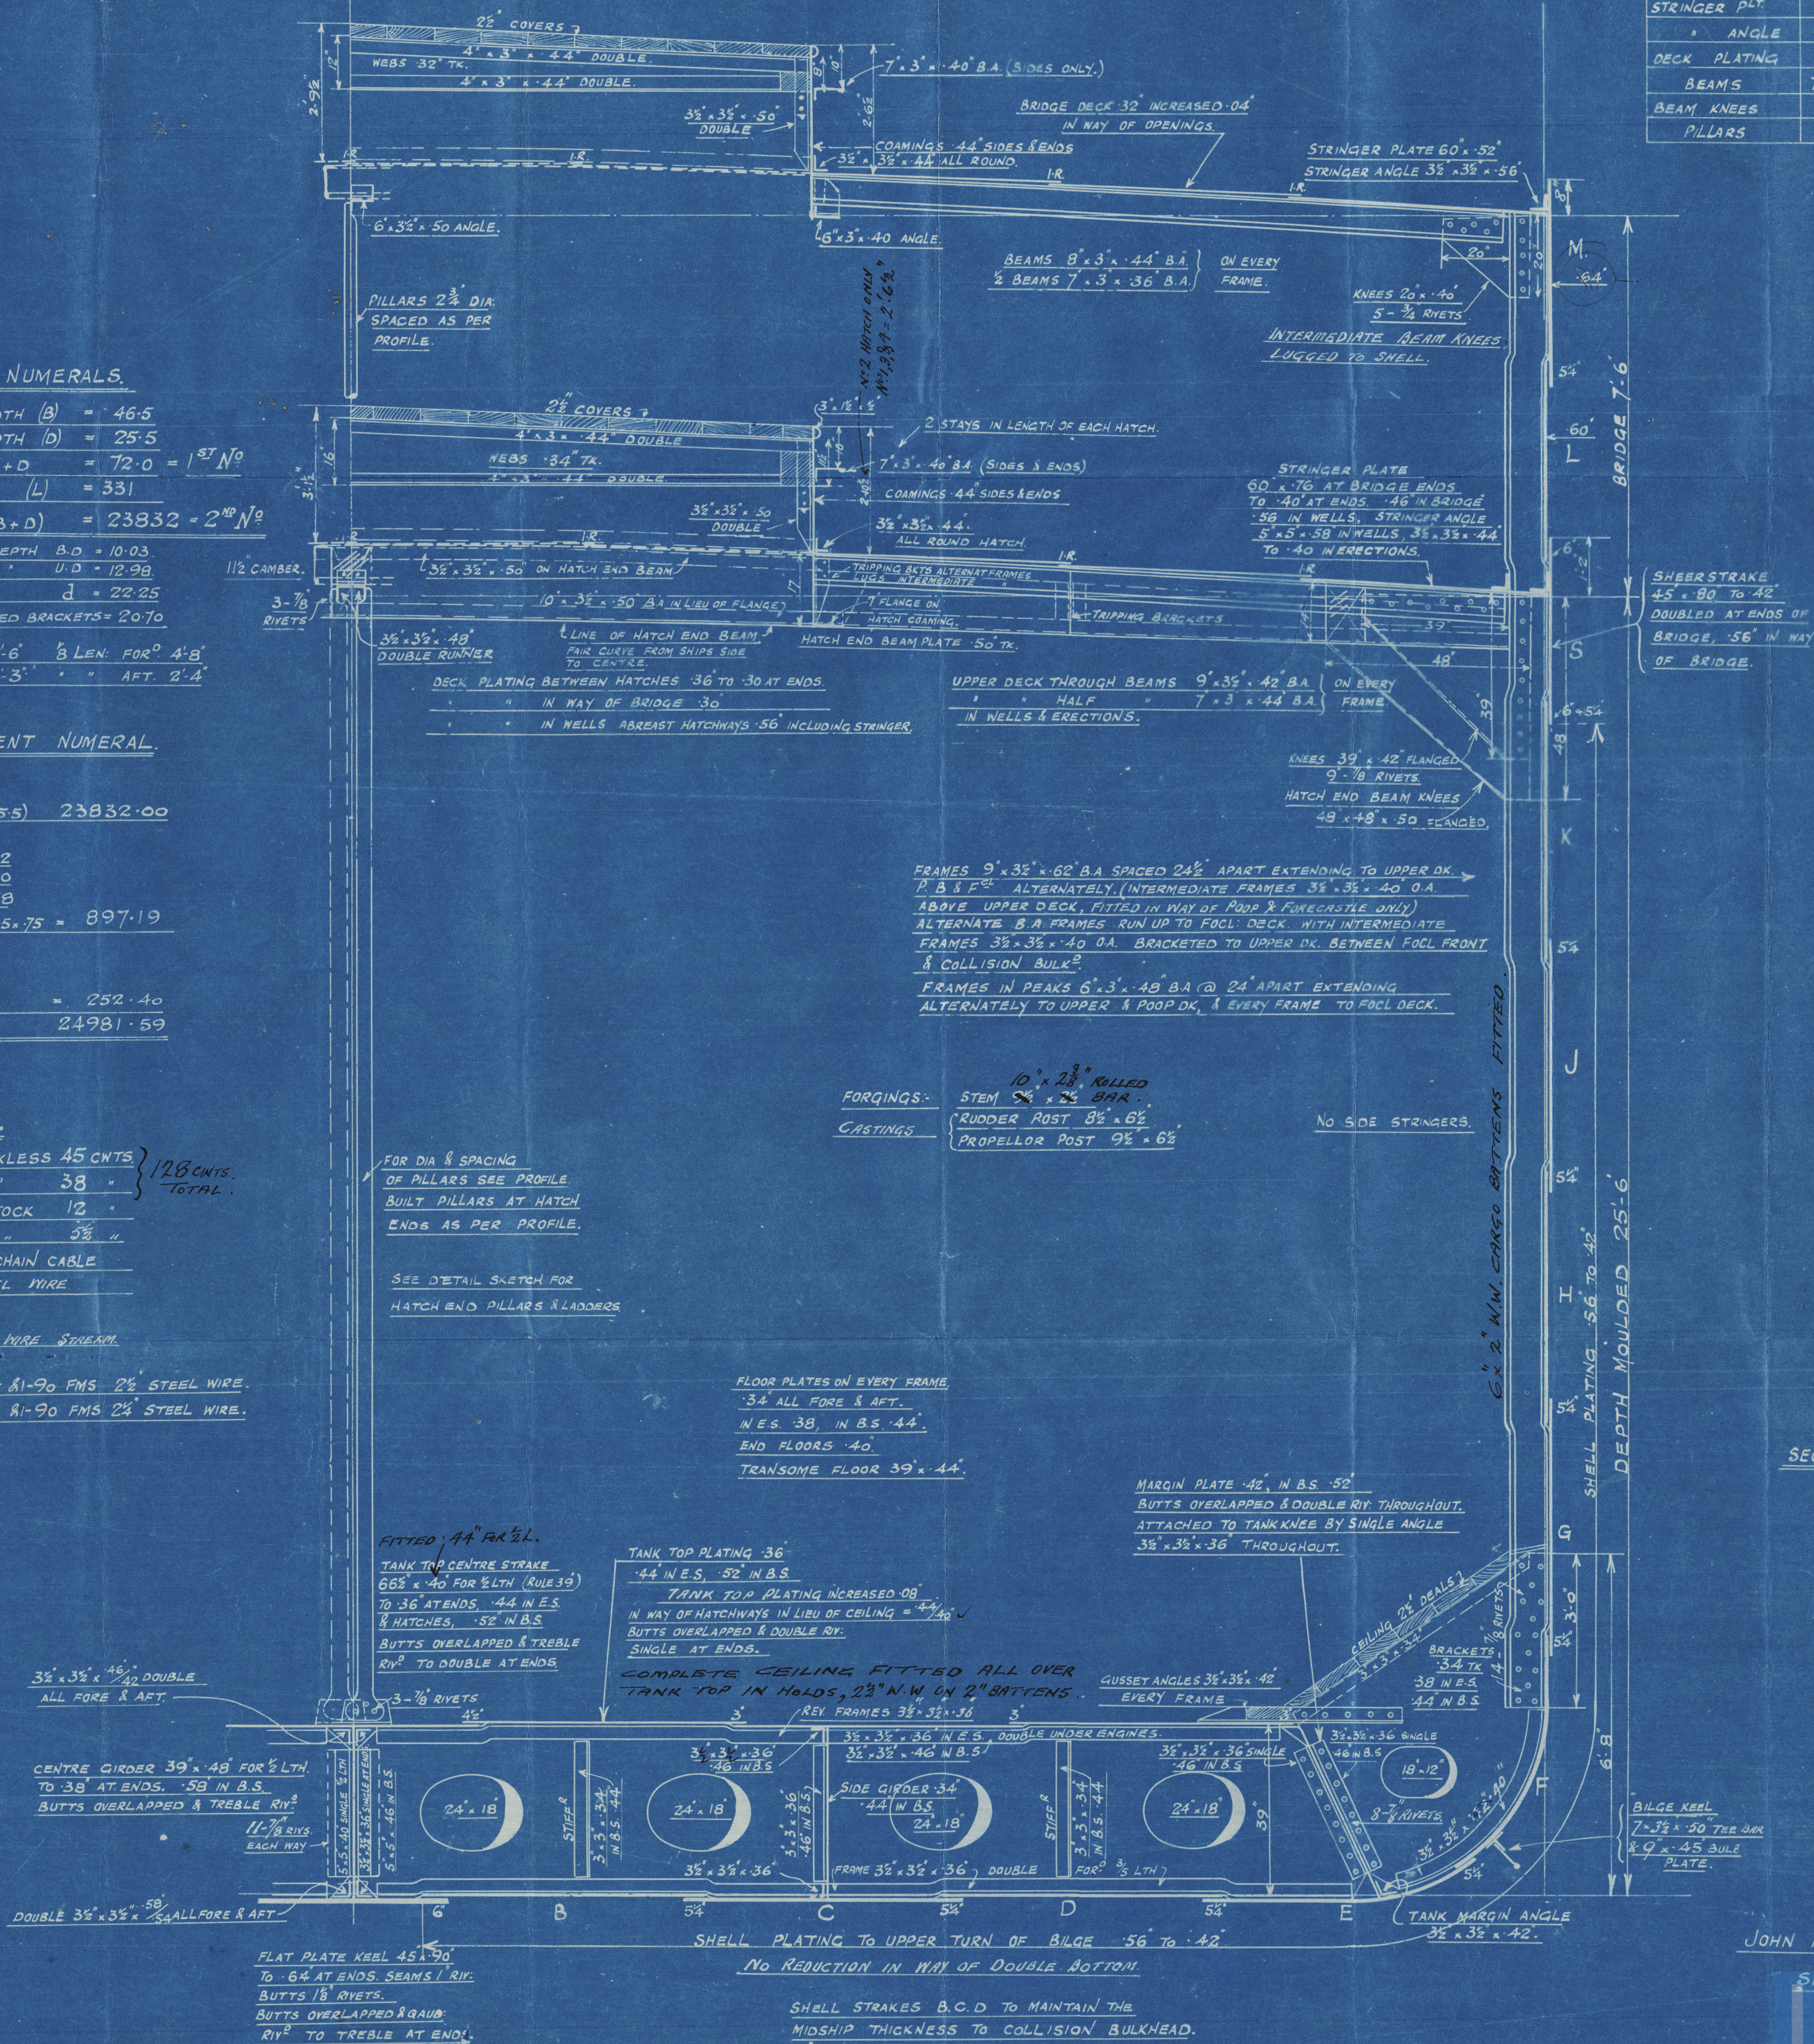

JOHN PRIESTMAN & CO.

SHIPBUILDERS,

SUNDERLAND.

Lloyds Register

Foundation

Mess^{rs} John Priestman Es^{rs}
Sunderland.

S.S. Muristan, No 284
Midship Section
as fitted
on "Takao Maru".

SUNDERLAND RPT. NO. 27715



© 2020

Lloyd's Register
Foundation

007746-007753-0073