


$\frac{7}{10}$   
 $\frac{9}{10}$   

14 Jm

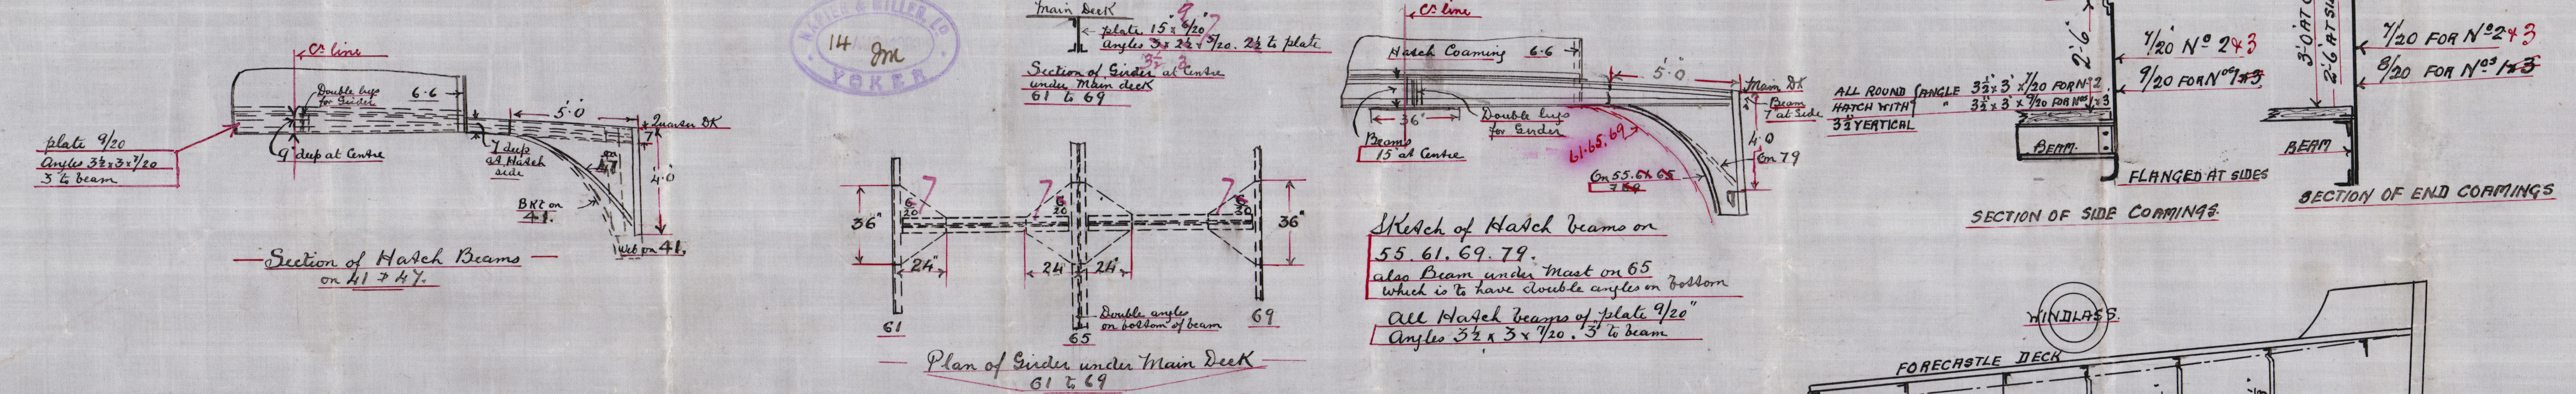

<u>FREEDBOARD PARTICULARS</u>	
LENGTH ON LOAD LINE	164- $\frac{3}{4}$ "
DEPTH MOULDED TO MAIN DECK	12'-6"
ESTIMATED TONNAGE COEFF. (UNCORRECTED)	.40 { QUARTER IN 9'-6" FORECASTLE 22'-0"
LENGTH OF ERECTIONS	116'-6"
SHEER FOR " "	66'
-1- AFT	36'
-1- AT $\frac{1}{2}$ LENGTH FROM STEM	36'-30"
-1- " " " " STERN	19'-80"
+ MEAN AT $\frac{1}{8}$ LENGTH	28'-05"

C.P.  
17. 8. 03.



Profile

No. 132

1/2 Lady Tennant  
Glasgow N<sup>o</sup> 2145-4

KILKENNY

007762-007769-0206



© 2020

Lloyd's Register  
Foundation