

*Lady Tennant*  
For the information of Surveyors and the Committee only.

Received at \_\_\_\_\_ Office \_\_\_\_\_ 190

# Lloyd's Register of British and Foreign Shipping.

(Report on Vessel No. *21457* Port *Glasgow*)

## No. *9437* SHIP FORGINGS ~~OR CASTINGS~~.

The words FORGINGS or CASTINGS, IRON or STEEL, should be struck out as may be required.

I have to report that the undermentioned Iron ~~or Steel~~ Forgings or Castings, manufactured by *Mess Robt Kerr & Sons* of *London* for the Vessel No. *132*, being built by *Mess Napier & Miller* of *Glasgow* have been inspected by me as set forth below and found to be, so far as can be seen, *Sound & efficient*


Mark on Forgings.

Lloyd's  
No. *9437*  
V.H.

*William Hamilton*  
*Glasgow*

	STERN FRAME.	RUDDER FRAME.	STEM.
Material* ...	<i>Scrap iron</i>		
How made ...	<i>Forged</i>		
Dimensions ...	<i>6 1/2 x 4 3/4</i>		
Progress on Inspection	<i>Forging &amp; smithing</i>		
Date when Inspected	<i>10/8/03 to 1/2/03</i>		

SKETCHES OF FRAMES SHOWING POSITION AND DESCRIPTION OF WELDS OF FORGINGS, OR PARTICULARS OF TESTS APPLIED TO CASTINGS.

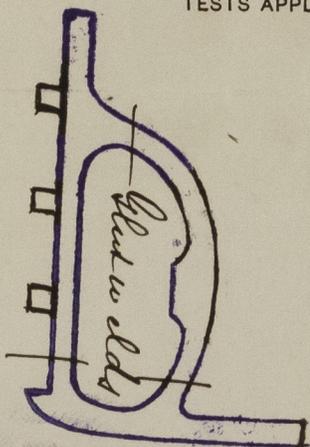

Fee (if any chargeable) £

To be paid at \_\_\_\_\_



© 2020

Lloyd's Register  
Foundation

\* If of Iron, state whether scrap or puddled Iron.


N<sup>o</sup> 132



*[Faint handwritten notes, possibly describing the drawing or related specifications.]*

*[Extensive, very faint handwritten text, likely a detailed report or specification, covering the right page of the document.]*



© 2020

Lloyd's Register  
Foundation