


3-4-19.



WILLIAM BEARDMORE & CO., LTD.,
DESIGNING DEPT.
NUMBER 3360.
DATE 21/3/19.
EXAMINED BY J.D.
NAVAL CONSTRUCTION WORKS,
DALMUIR, N.B.

S.S. N° 613.
245'-0" B.P. x 34'-0" x 16'-6" MLD.
LLOYDS PROFILE & STEEL DECKS
SCALE $\frac{1}{8}$ " = 1 FT.

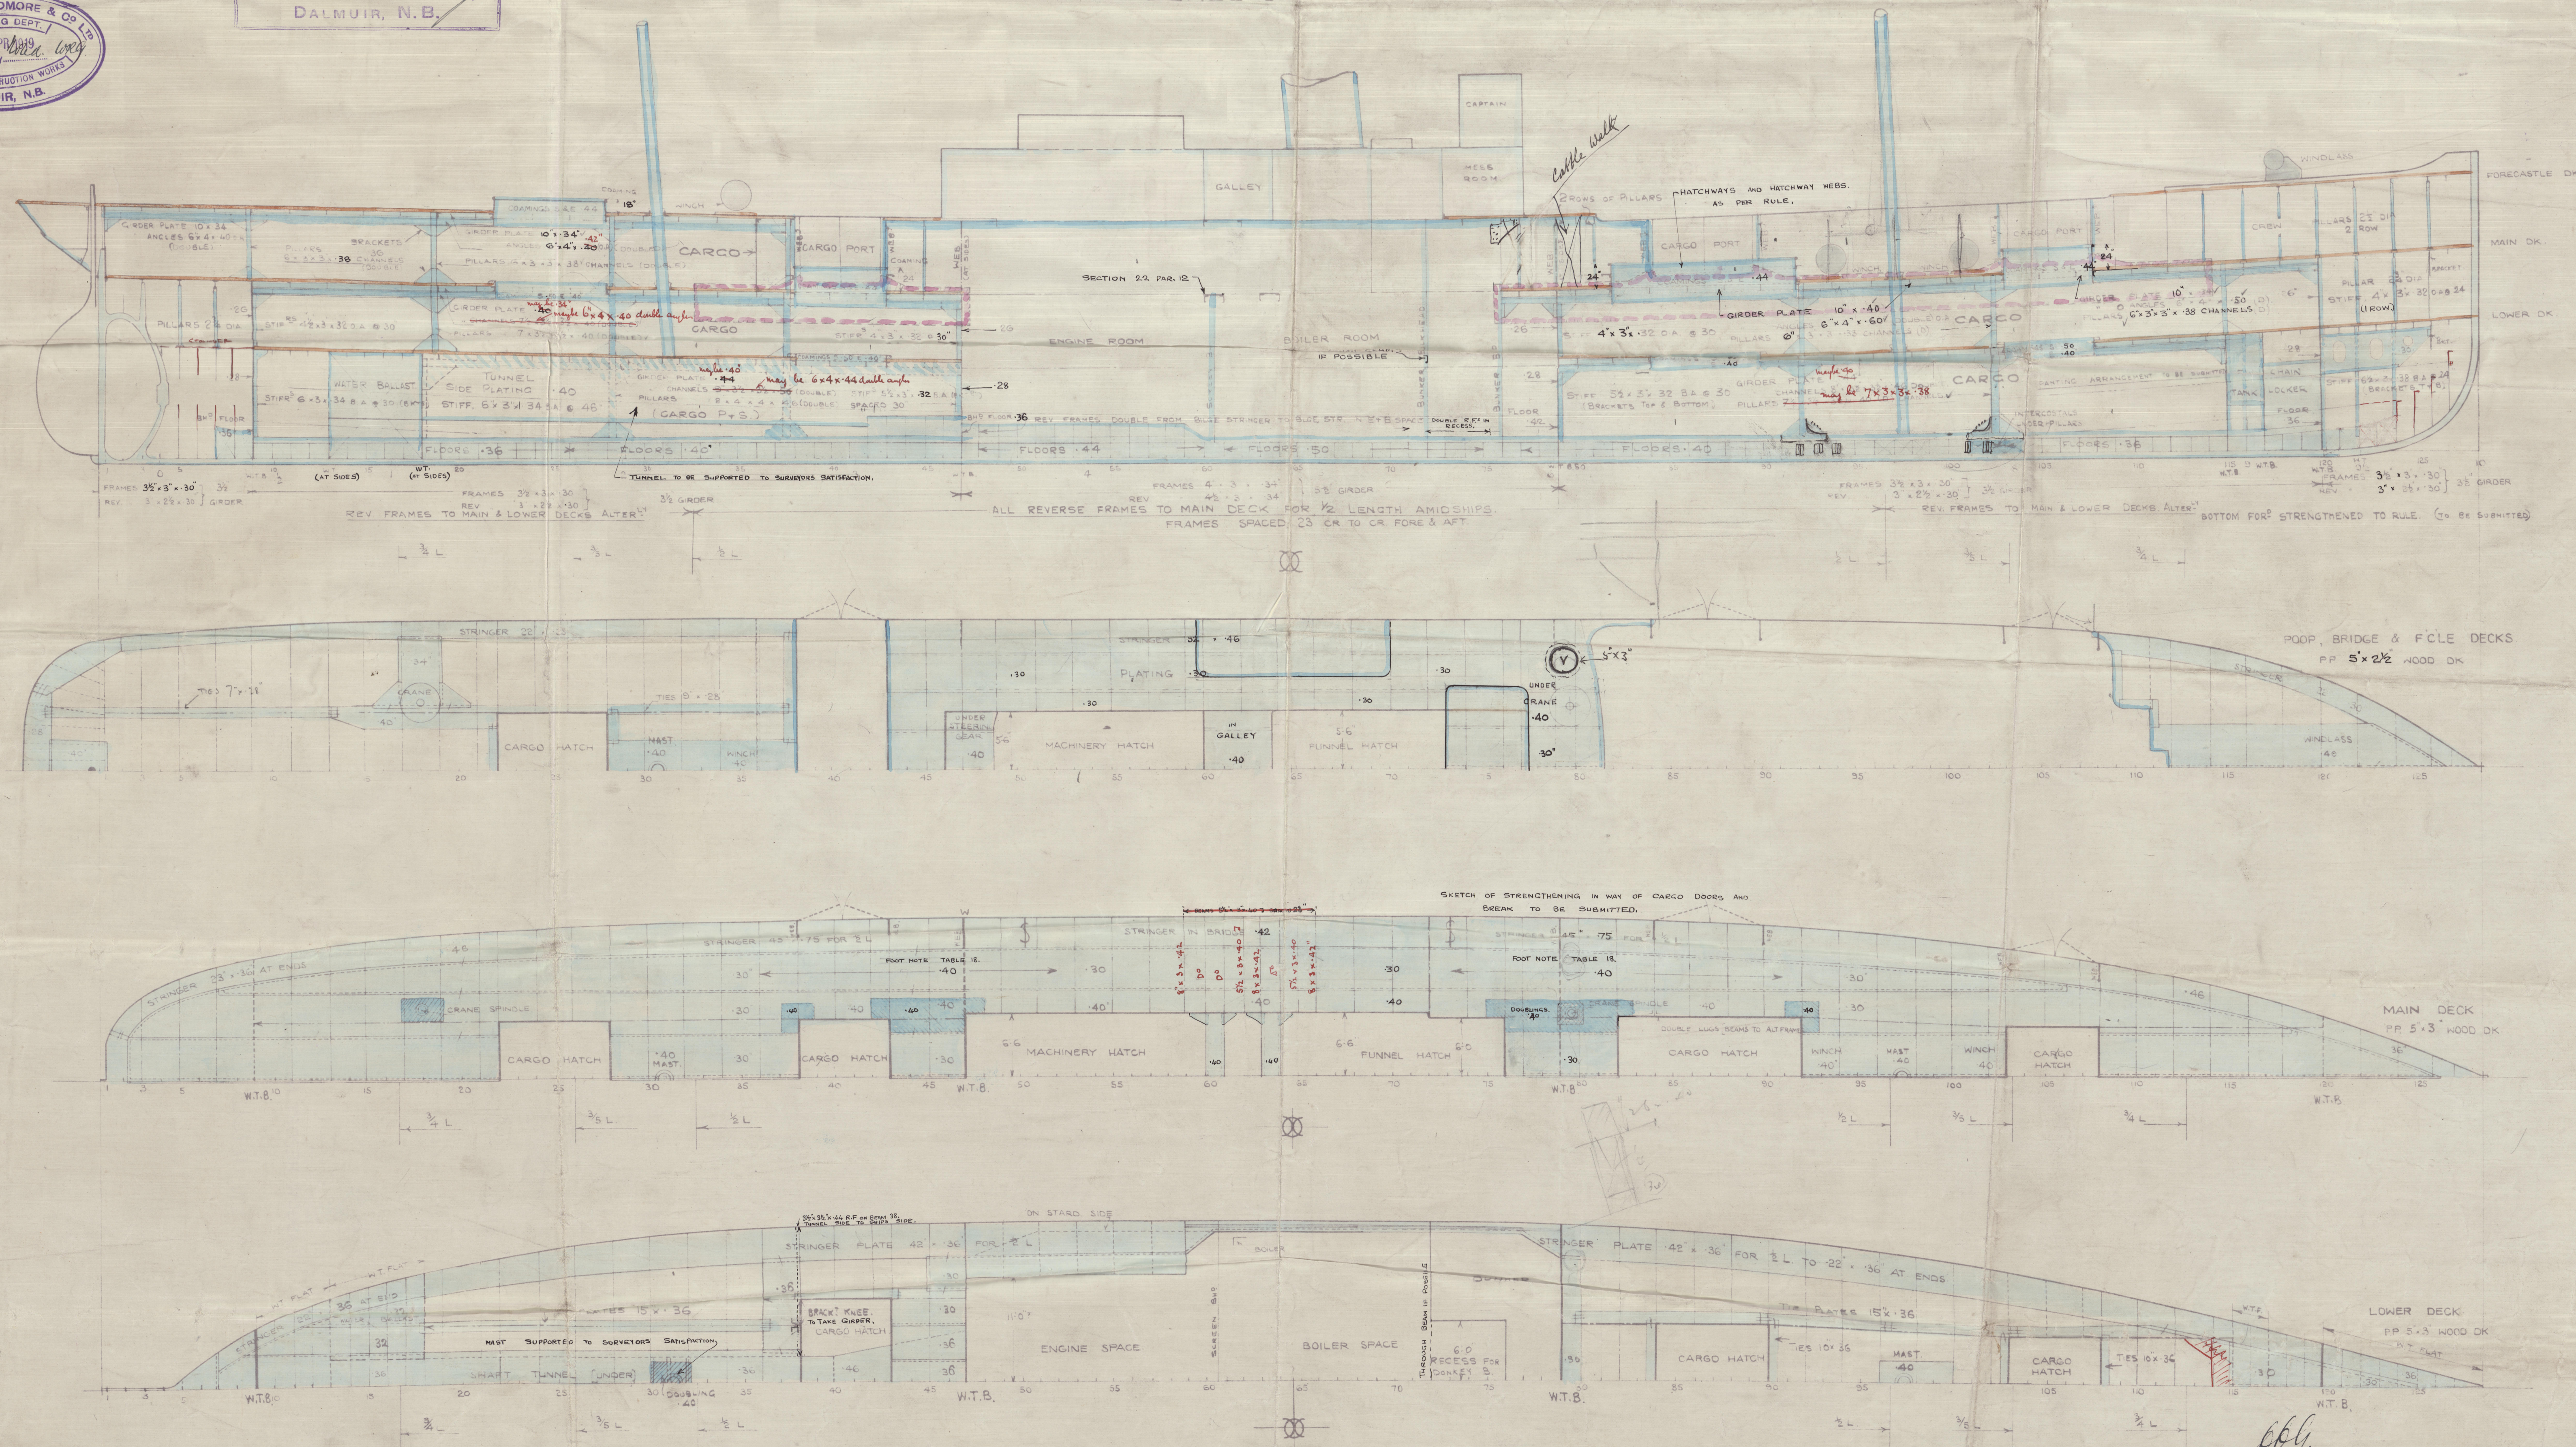

Amended Project & Dates

Reundura B. 45

No. 613

S/s Setter

GLASGOW REPORT No. 39941

NW Ulster Castle



© 2020

Lloyd's Register
Foundation

007865-007873-0018