



COSTRUZIONE N 159
PIANO CORBAME E PARATIE
SCALA 1:100

PARATIE STAGNE									
Numero dell'ordale	8	36	58	79	99	121	145	169	

Stiffeners to continue bulkhead to be bracketed top and bottom at water ends.

Intermediate beams to be lagged to continue bulkhead plating.

Hold ribs as per Table A all fore and aft.

 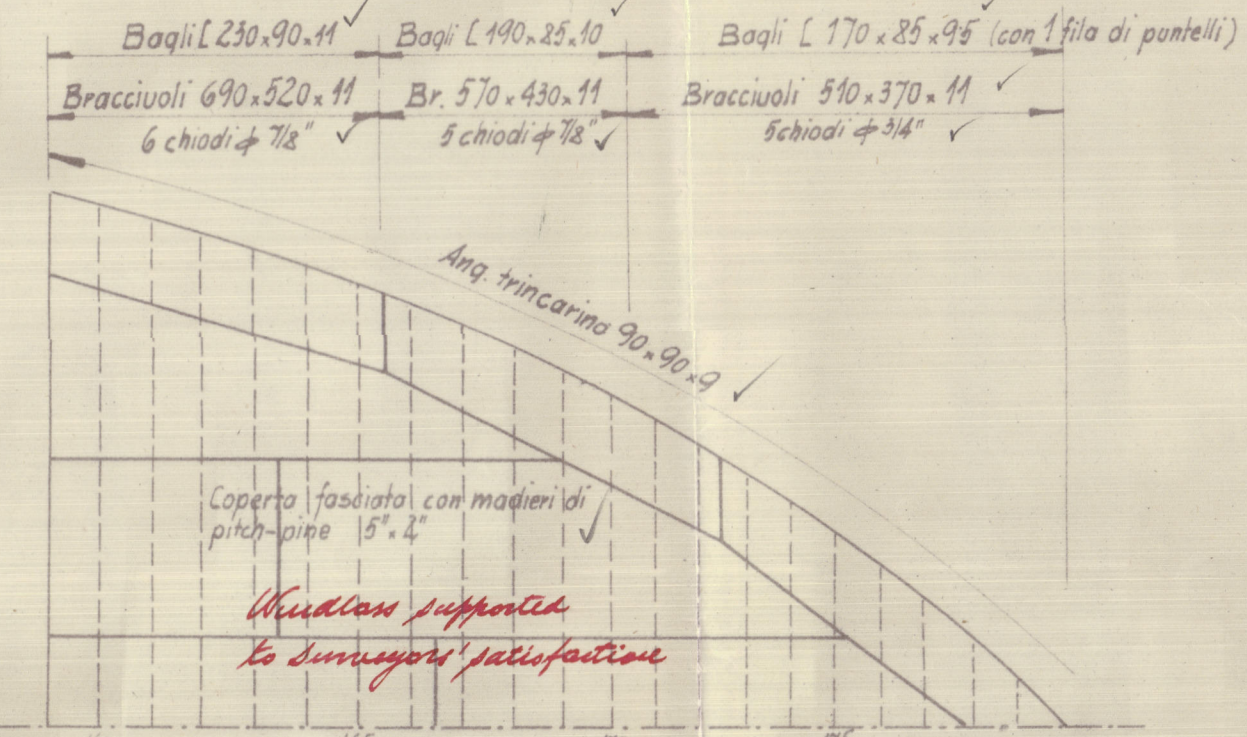

APPROVATO
6-7-1925
LLOYD'S REGISTER OF SHIPPING
TRIESTE

C.N.T. N° 159

Approved plan of Profile & Deck

M. V. Maria

TRIESTE Rpt 7361



© 2020

Lloyd's Register
Foundation

007865-007873-0148