


Lloyd's Register of Shipping.
SURVEYS FOR FREEBOARD.
(CONDITIONS OF ASSIGNMENT.)

Index No. 39142
(For London Office only.)
Gron. Apt. No. 204
24 JUN 1947

Ship's Name FEROCIA Port of Survey GRONINGEN
Official Number Surveyor's Signature R. H. W. Kruysen
Nationality and Port of Registry NETHERLAND, OVERSCHIE Date of Survey 20-6-47

Disposition and dimensions of superstructures, trunks, deckhouses and machinery casings to be inserted in the diagrams and tabular statement :-

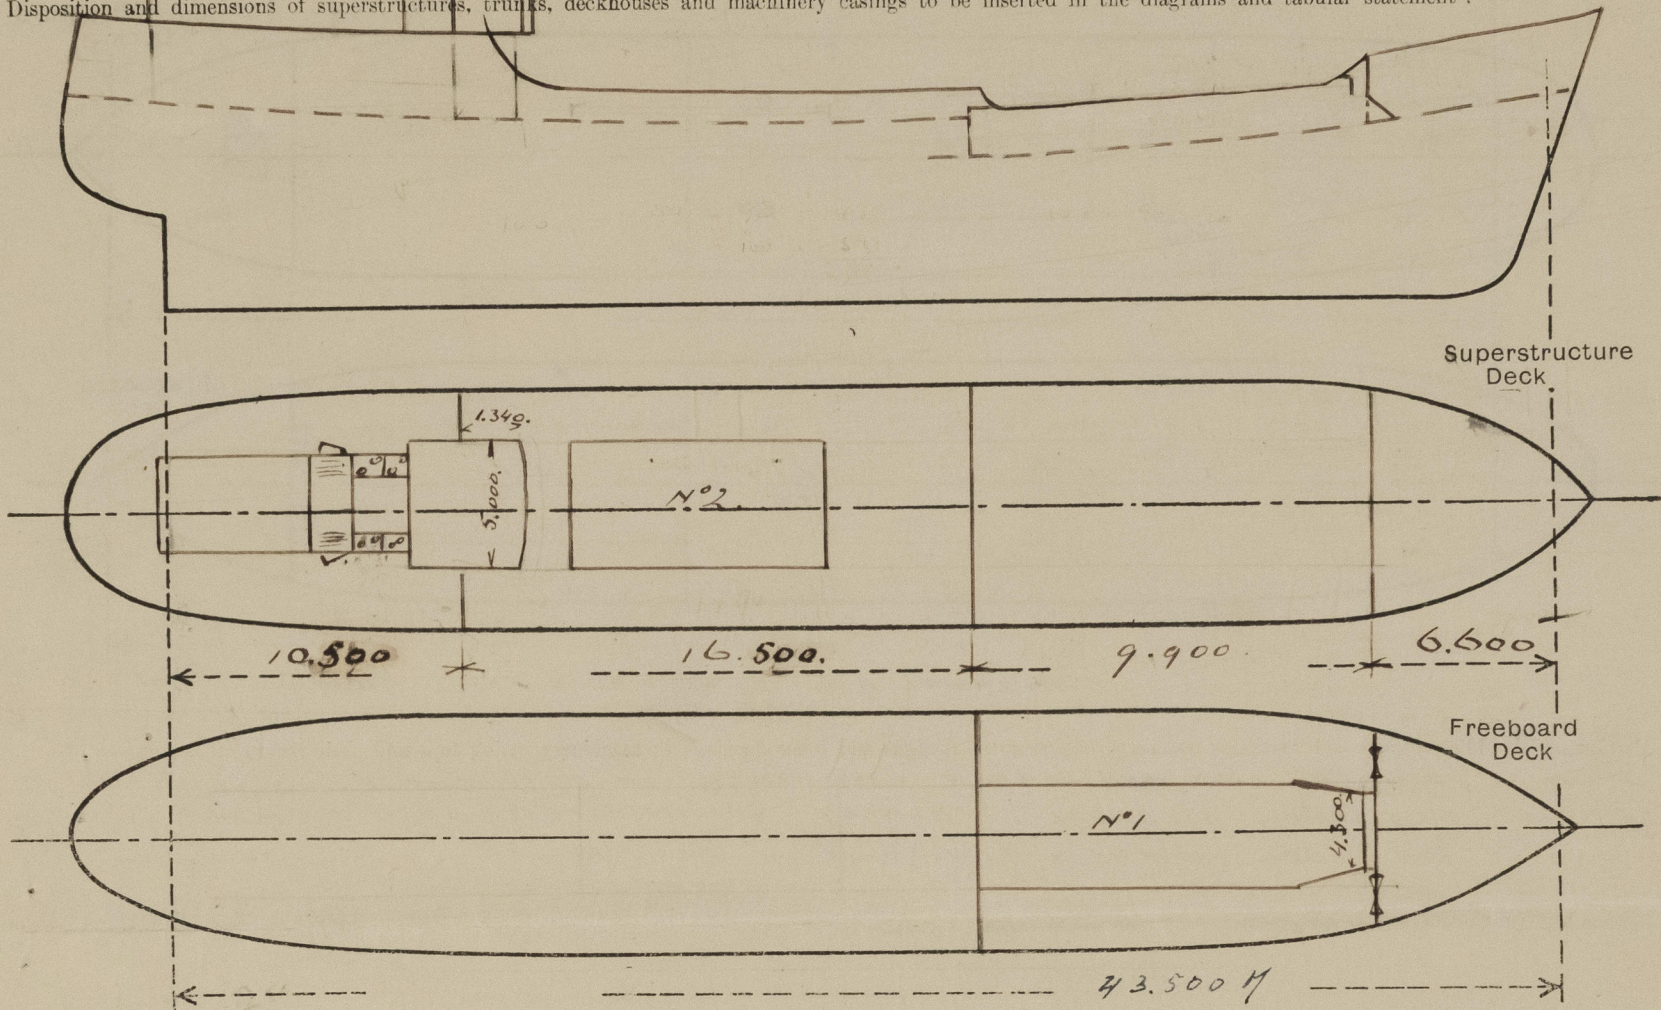

Particulars of Superstructures, Trunks, Casings, Deckhouses.								
	Coaming	Plating	Stiffeners	Spacing	End Attachments of Stiffeners	Size of Openings	Height of Sills	Height of Casings
Poop Bulkhead	✓	6 ✓	1.75 x 8 ✓	850 ✓	EL. WELDED ✓	✓	✓	2.083 ✓
Raised Quarter Deck Bulkhead ...		7 1/2 ✓	1.120 x 7 ✓	500 ✓	EL. WELDED ✓	NONE ✓	✓	800 ✓
Bridge, After Bulkhead	✓	✓	✓	✓	✓	✓	✓	✓
Bridge, Forward Bulkhead	✓	✓	✓	✓	✓	✓	✓	✓
Forecastle Bulkhead	✓	7 ✓	1.100 x 8 ✓	940 ✓	NONE ✓	1.260 x 950 ✓	510 ✓	2.000 ✓
Trunk, Aft	✓	✓	✓	✓	✓	✓	✓	✓
Trunk, Forward	✓	✓	✓	✓	✓	✓	✓	✓
Exposed Machinery Casings on Freeboard or Raised Quarter Decks ...	✓	✓	✓	✓	✓	✓	✓	✓
Exposed Machinery Casings on Superstructure Decks	✓	6 ✓	1.75 x 6 ✓	550 ✓	✓	1.510 x 610 ✓	400 ✓	2.200 ✓
Machinery Casings within Superstructures not fitted with Class I Closing Appliances	✓	✓	✓	✓	✓	✓	✓	✓
Deckhouses on Flush Deck Ships ...	✓	✓	✓	✓	✓	✓	✓	✓
Particulars of Closing Appliances (state if capable of being manipulated from both sides).								
Poop Bulkhead	✓							
Raised Quarter Deck Bulkhead ...	✓							
Bridge, After Bulkhead	✓							
Bridge, Forward Bulkhead	✓							
Forecastle Bulkhead								
Exposed Machinery Casings on Freeboard or Raised Quarter Decks ...	✓							
Exposed Machinery Casings on Superstructure Decks								
Machinery Casings within Superstructures not fitted with Class I Closing Appliances	✓							
Deckhouses on Flush Deck Ships ...	✓							

PARTICULARS OF PROTECTION TO OPENINGS, ETC.

HATCHWAYS ON FREEBOARD AND SUPERSTRUCTURE DECKS.									
Description of Hatchway			Nº1.		Nº2				
Dimensions of Hatchway			9.600x 5.000		9.600x5.000				
COAMINGS	Height above Deck	...	1050	✓	1050	✓			
	Thickness	Sides	10	✓	10	✓			
		Ends	10	✓	10	✓			
	Stiffeners	SEE SKETCH	✓	SEE SKETCH	✓		
Brackets, Stays			3 BRACKETS		3 BRACKETS				
HATCH BEAMS	Number	...	5	✓	5	✓			
	Spacing	...	EQUAL	✓	EQUAL	✓			
	Scantling and Sketch	...	PLATE	✓	PLATE	✓			
		...	360x10	✓	360x10	✓			
Bearing Surface	100	✓	100	✓			
	100x75x11	✓	100x75x11	✓			
FORE AND AFTERS	Number	...							
	Spacing	...							
	Unsupported Lengths	...							
	Scantling* and Sketch	...							
Bearing Surface									
HATCH COVERS	Material	...	PINE	✓	PINE	✓			
	Thickness	...	65	✓	65	✓			
	How fitted	...	LONGITUDINAL	✓	LONGITUDINAL	✓			
	Bearing Surface	...	75	✓	75	✓			
Spacing of Cleats			600x150		600x150				
Number of Tarpaulins			2		2				
<p>*Are wood fore and afters steel shod at all bearing surfaces? ✓</p> <p>Are battens and wedges efficient and in good condition? YES ✓</p> <p>Are tarpaulins in good condition and in accordance with rule requirements? YES ✓</p> <p>Are lashings provided in accordance with rule requirements? YES. ADDITIONAL LASHINGS ARE FITTED BREADTH OF HATCHWAY BEING OVER 60% SHIP'S BREADTH ✓</p>									

Particulars of any special features:—