



Office ✓



 

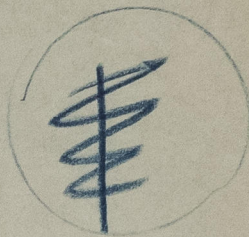

2

Bakke Bay.

Ex

"VAGAN" \*

Tri rept No. 13076.

CANTIERI RIUNITI DELL'ADRIATICO

YARD NOS 1727-8.

MIDSHIP SECTION

© 2021

Lloyd's Register  
Foundation