

SECTIONS

S.S. No 185.

150'0" B.P. x 25'6" M.L. x 12'9" M.H.

SCALE 1/2" = 1 FT.


EQUIPMENT

- 2 STOCKLESS BOWER ANCHORS 10 1/4 CWT.
- 1 " " " 8 3/4 " "
- 1 STREAM ANCHOR 7 1/2 " EX STOCK
- 1 KEDGE 1/2 " "
- 150 FATHOMS 1 1/16" STUO CHAIN CABLE
- 60 " 1/16" STREAM CHAIN
- 75 " 2 1/2" STEEL WIRE
- 90 " 5 1/2" MANILLA HAWSER.

CEMENTING

BOTTOM OF VESSEL TO BE CEMENTED 3" THICK
WORKED OVER FRAMES & WELL UP FLOOR.
50% BEST PORTLAND CEMENT & 50% SHARP RIVER SAND.

FOR DETAIL OF RIVETING SEE SEPARATE SHEET.

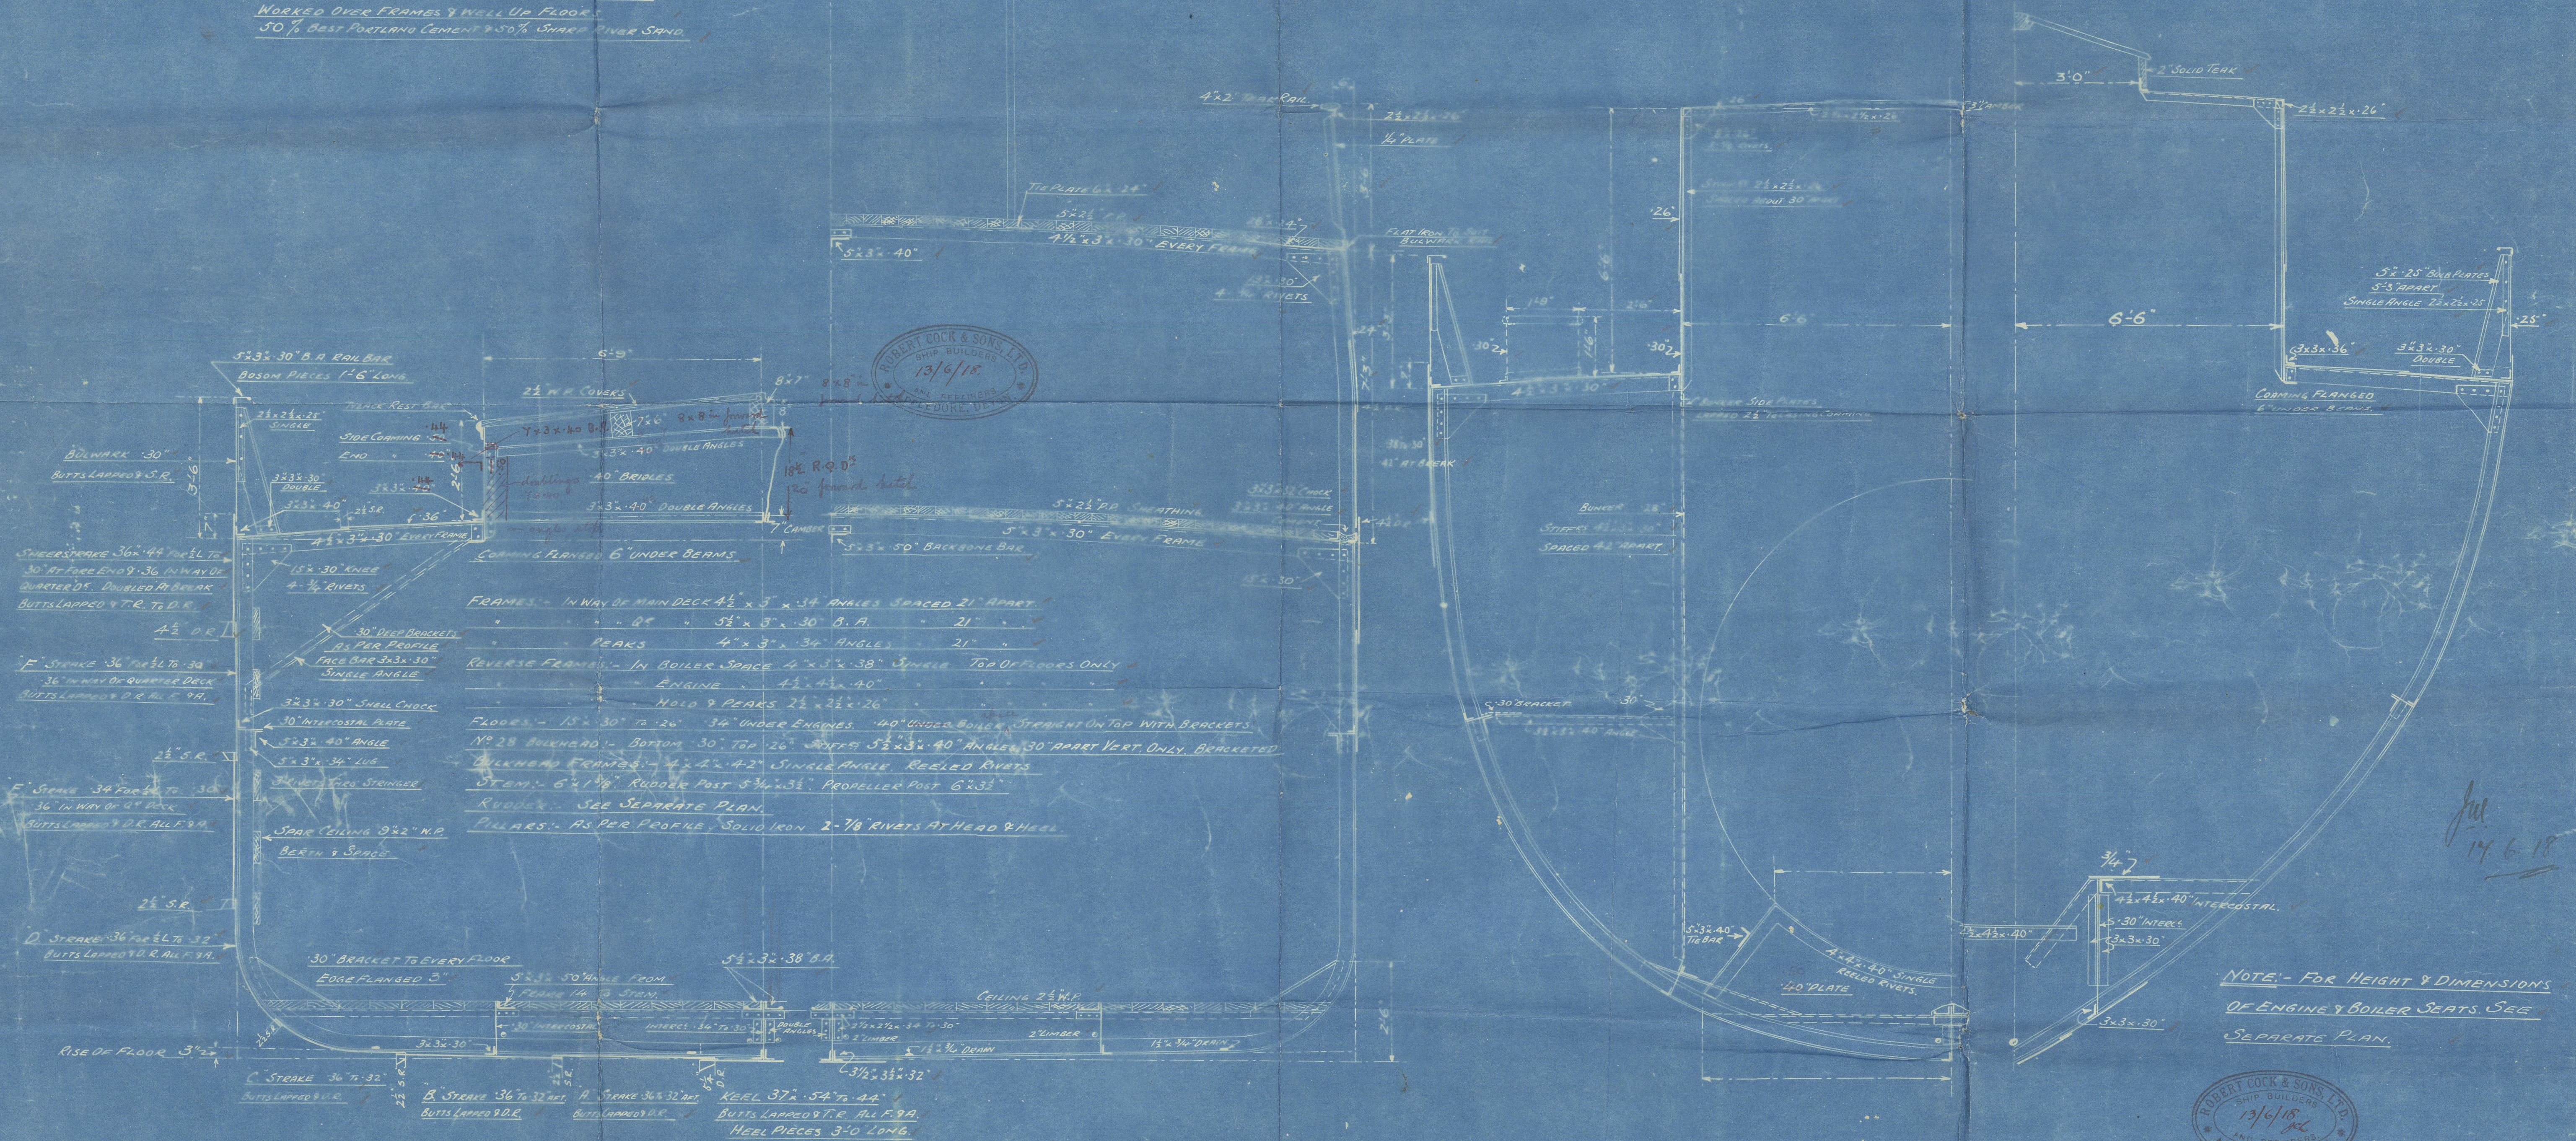


SECTION THRO' FORE HATCH

SECTION THRO' BRIDGE

SECTION THRO' BOILER SPACE

SECTION THRO' ENGINE ROOM

NOTE:- FOR HEIGHT & DIMENSIONS OF ENGINE & BOILER SEATS SEE SEPARATE PLAN.

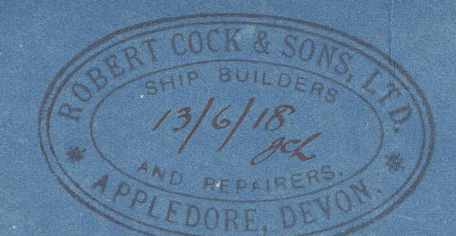

JUNE 1918.

Orleigh
Cock 185



Midship Section

Guarahu
H. Orleigh ex
apl 3206
Appl. 11328

Guarahu



© 2021

Lloyd's Register
Foundation

008040-008048-0159