

S.S. Nos. 343-4.

To Class 100 a.1. at Lloyds Shelter Deck.
 Dims. 450'-0" B.P. \times 57'-11" E. \times 37'-4 1/4" Mtd to Shelter Lk.
 Scale 1/2" = 1 Foot.

ROBERT DUNCAN & CO.
LIMITED
21 NOV 18
SHIPBUILDERS
PORT GLASGOW

$B = 57.65$
 $D = 29.18$
 For 8'2" shelter Sta. }
 Lower side } $= 0.17$
 } $87.00 = \text{Trans. No.}$

 748.12
 313684

 358496
 $3898644 = \text{Long. No.}$

Proportions
Length to Depth

7 35 1448 12 11 9

3735

7462

3735

37270

33615

36550

33615

2935

Equipment Number

Rule Equipment

1 Lower Stordale 7 1/2" cuts
1 " " 7 1/2"
1 " " 6 1/2"
Collected Wt = 207
Stream ex stock 20 1/2"
1 Judge " 9"
300 Cations 2 1/2" steel chain cable 8 1/2" cuts
120 " 5" stream wire
100/100 5 1/2" towline wire with 30 fath 12" manilla
100 " 2 1/2" wire hawser 12" with
100 " 2 3/4" wire warp 20 fathoms cement to steel wire

Forgings & Castings

Stem $10\frac{1}{2} \times 27^0$ mild steel ✓
or 11×2^{30}
P. Post $9 \times 8\frac{1}{2}$ ✓ P. Post $10\frac{1}{2} \times 8\frac{1}{2}$ Cast steel ✓ Reader post increased for owner

Transom Floor 51 x ~~46~~ .50

Main Frames all to 2nd Bld. in between Oak Sheds 10 3 3/4 2 3/4
 Frames in Sides to 3rd Bld. all to Slaten note Dates made 8 x 2 1/2 x 40 X
 Main Frames 2nd Bld. between Oak Sheds all 6 3 3/4 28 wide -
 Slaten 3rd Bld. 3 1/2 3 1/2 40 wide -
 Frames 28 space from top Oak Shed to 1st Bld. shed
 27 1st Bld. shed to 3rd Oak Shed -
 24 in Ashes




Engine Seat Plate 1" Thick
 of order Bottom Angle $3\frac{1}{2} \times 3\frac{1}{2} \times 60"$ to .56 at Ends
 " " Top " $52"$ " .48 " " 62 B.S.

[illegible]

Cap. border 1/2" deep 5-5 1/2" Sample 60 in 50 3 1/2 x 3 1/2 x 4 1/2 at ends 6 x 6 x 56-52

[illegible]

Increases over Rules by Specification

[illegible]

Scantings marked in Blue
are as actually fitted in shop

Alternative Arrangement of
Beams in Forecastle.

Beams $10\frac{1}{2} \times 3\frac{1}{2} \times 56$ B.A. on alt. Frames (2 Row Size)
For Beams at Extreme End (See Profile)
Steel Deck 34' Heatherol with 5' B.P.P.
Beam Knees $29" \times 5\frac{1}{2}"$

This arg
in ship

Strengthening of Bottom Fore End





$\frac{1}{2}$ Bolt 25-3 3-2"

Shaving Edge Keel inside of Tank Margins

Midships Section
Kusps Duncan & Co No 343/4.
S. S. "Amou de Larrinaga"
S. S. "Elisfora de Larrinaga"
Greenock Rpt No 17626.

Greenock Rpt. No 17651.

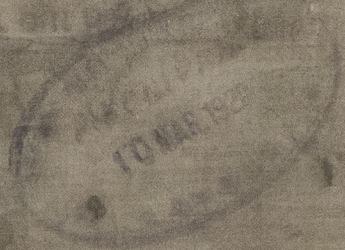 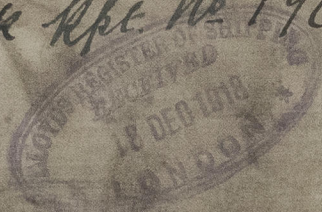

© 2020

Lloyd's Register
Foundation

Drawing Office



© 2020

Lloyd's Register
Foundation