

24/2/8

Stock increased 1" over Plate diameter by Owners Agent.

Steering Gear of  
Wilson. Pirrie Type.

Upper deck.

1/4" Dia Holes for 7/8 Rivets

1/8" Dia Holes for 7/8 Rivets

Main deck.

Watertight Deck

Interlocked in Centre

Interlocked in Centre

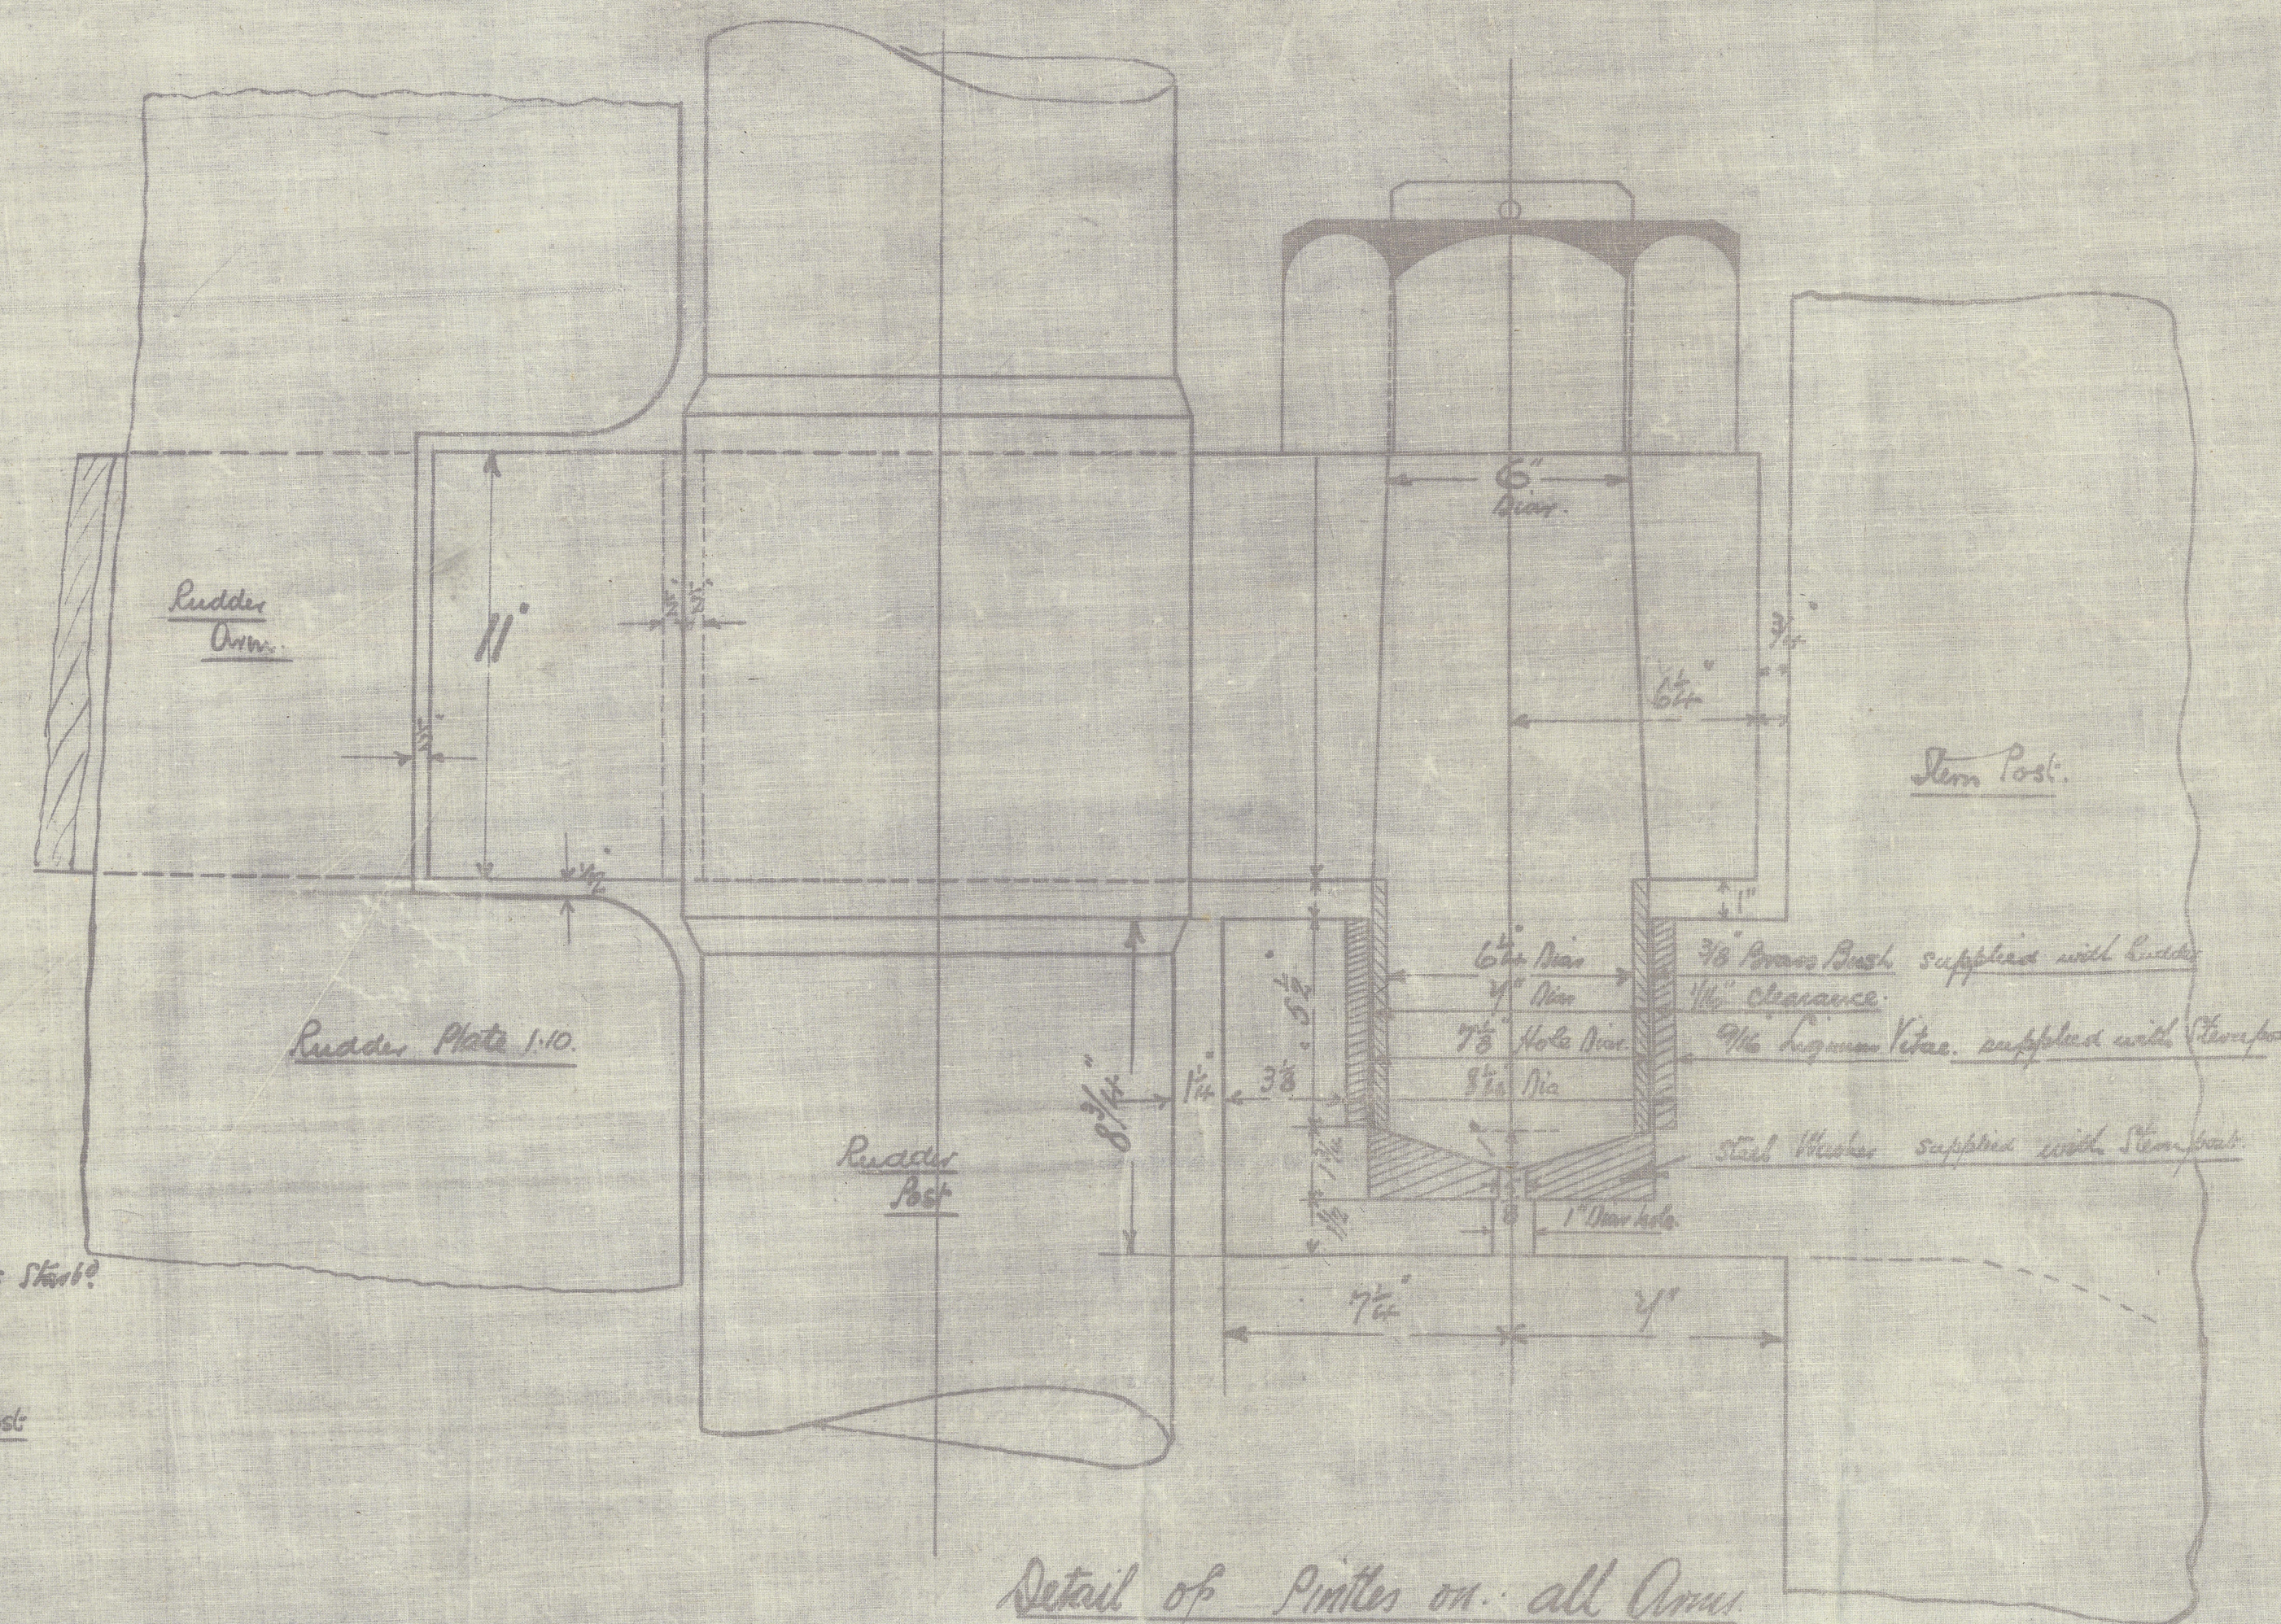

Detail of Pintles on all Arms  
Scale 3" = 1 foot.

Detail of Rudder Arms  
Scale 1" = 1 foot.

Detail of Stopper on Top Arm  
Scale 1" = 1 foot.

N<sup>o</sup> 343-A4

Plan of Rudder and Sternpost.

Scale 1/2" = 1 foot.

Rudder Frame and Stock a Forging  
Stern Frame Casting  
A x D = 627. Speed 10-12 knots  
Rule Stock 11" Pintles 5 1/2"

Note. Rudder post & stock  
forged ingot steel.  
Arms forged iron



Special Notes: Increases to Upper Part  
of Stock and to Pintles  
are to Specification.




Plan of stern frame & rudder

Messrs Robt Duncan & Co. Ld.

No. 34 3/4.


S.S. "Kamou de Larrinaga"

S.S. "Telesfora de Larrinaga" 

Glasgow Rpt. No. 14626.

Glasgow Rpt. No. 14651

*5-4-20*  
*5-4-20*

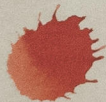

*Lloyd*



© 2020

Lloyd's Register  
Foundation



~~44~~



© 2020

Lloyd's Register  
Foundation