


WOOD SKINNER & CO. LTD.  
SHIPBUILDERS  
NEWCASTLE ON TYNE

PROPOSED LONGITUDINAL ELEVATION  
OF A STEEL SCREW STEAMER TO CLASS 100 A1 AT LLOYDS ✓

PRINCIPAL DIMENSIONS 232'-0" x 34'-10" x 18'-10" ✓

SCALE  $\frac{1''}{8} = 1 \text{ FOOT}$

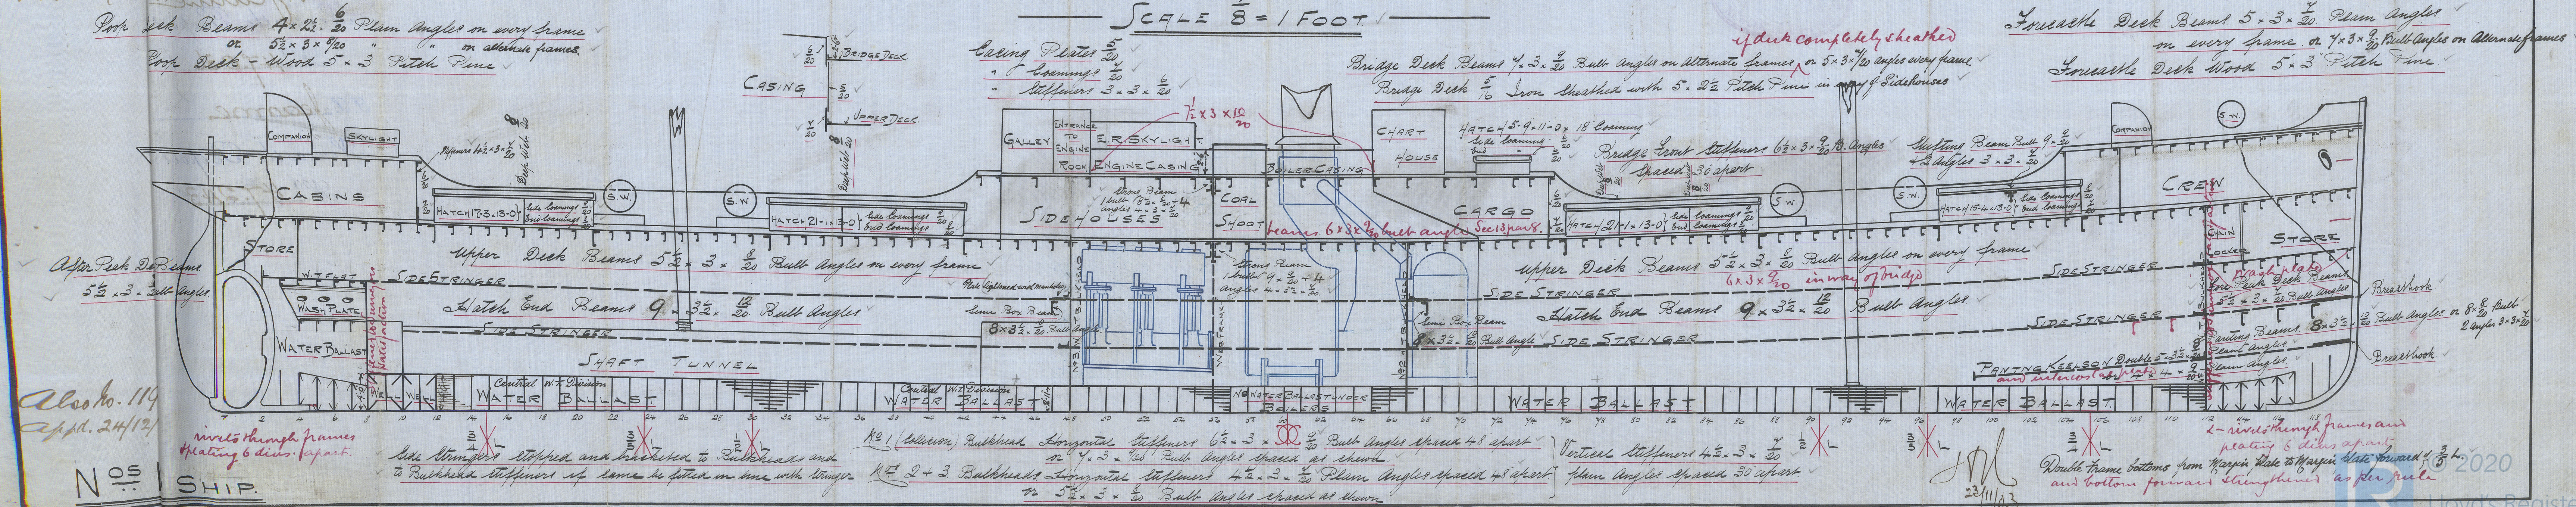



Newcastle-on-Tyne  
Messrs. Wood, Skinner's  
No 118  
Profile

Also No. 119  
OTAVA  
E+  
S.S. Simone  
S.S. Jeanne

#7.036

~~S. Jeanne~~ X

Newcastle Report

No. #7.2431

© 2020

Lloyd's Register  
Foundation

008061-008067-0132