
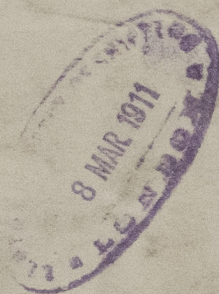





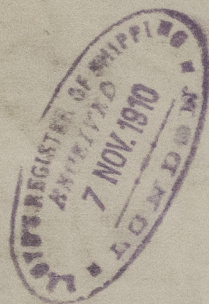

J L Thompson & Son L^{rs}

No 483.

Profile & decks

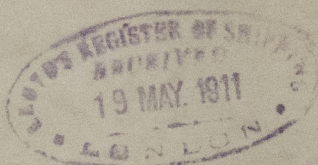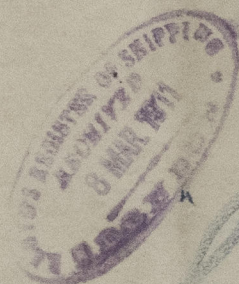

Bento

Sld Hld Rpt 25029

Sld F.E. Rpt 25058

HAMMERLAND

1911

Aino Hurminen

008068-008078-0190



© 2020

Lloyd's Register
Foundation

0310-240800-890800



© 2020

Lloyd's Register
Foundation