



Nº 117

PROPELLER SHAFT BRACKETS

SCALE 1" = 1 FOOT.

BRACKETS, CAST STEEL

QUALITY TO MEET LLOYDS TESTS FOR CASTINGS

DRAWN FOR STARBOARDSIDE

PORT-SIDE SIMILAR (BUT TO REVERSE HAND)

MOULDS SHOWING SIZES AND

CONSTRUCTION OF BRACKETS

SUPPLIED BY SHIPYARD

PATTERN BY FOUNDRY

MACHINING SHOWN TINTED RED

DONE BY FOUNDRY

CENTRE LINE OF SHAFT

	AT FRAME 1	AT FRAME 37
DISTANCE FROM M.L.	5'-3"	3'-9"
HEIGHT ABOVE BASE LINE	2'-11"	3'-8"


DIAMETER OF PROPELLER 7' 0"

" " TAIL SHAFT 6"

SHAFT HORSE POWER 450 EACH SHAFT

REVOLUTIONS 180


SPEED 13 1/2 KNOTS

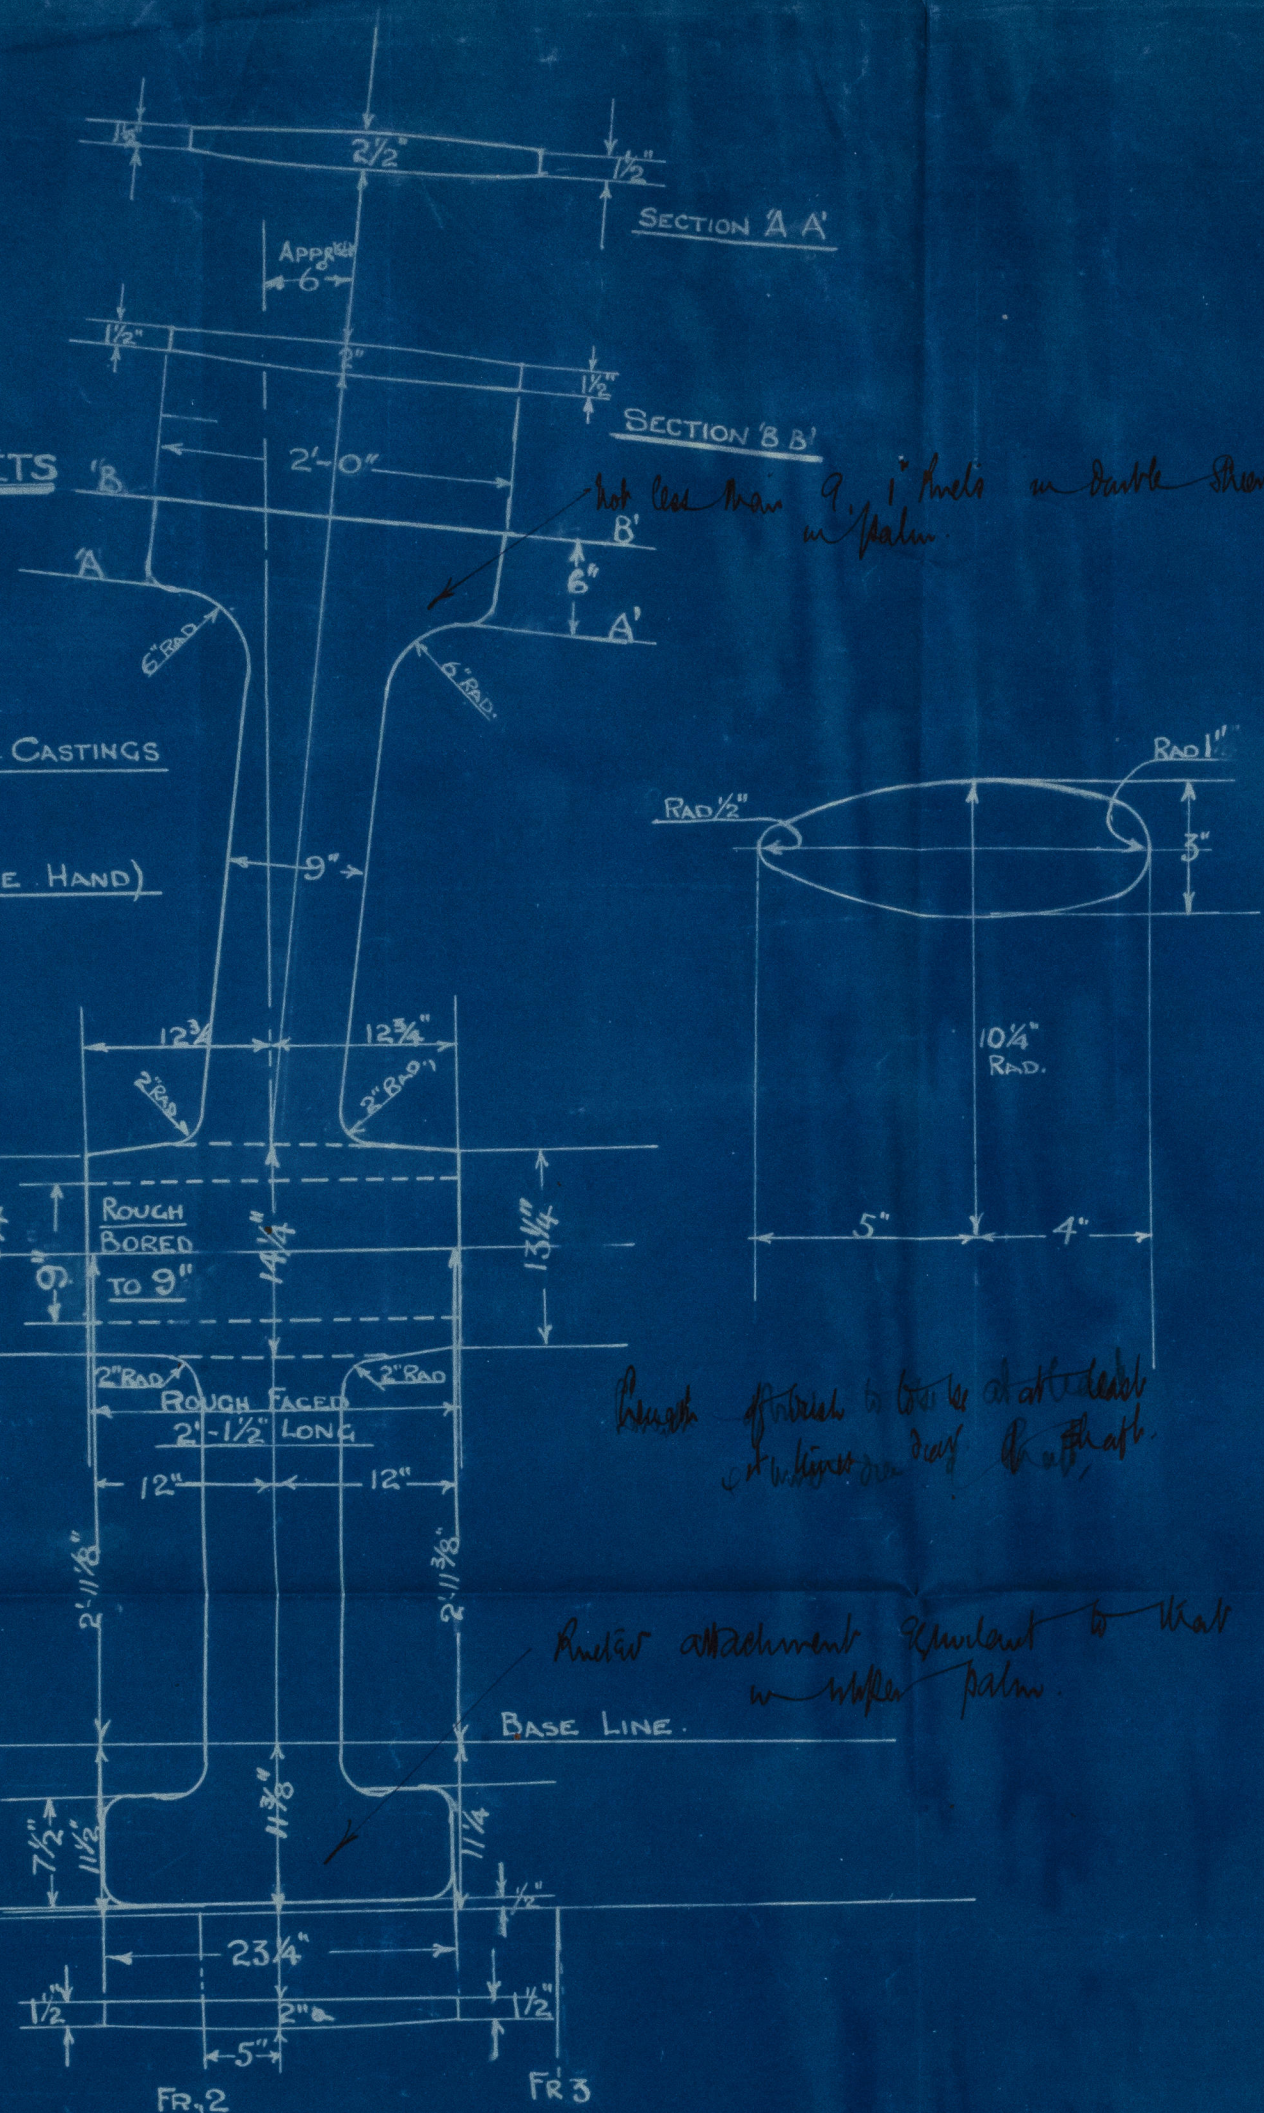

— FORE AND AFT VIEW OF ARM. —

additional internal fillet in way of washers to prevent fatigue.

PALM TO RUN PARALLEL WITH LANDING

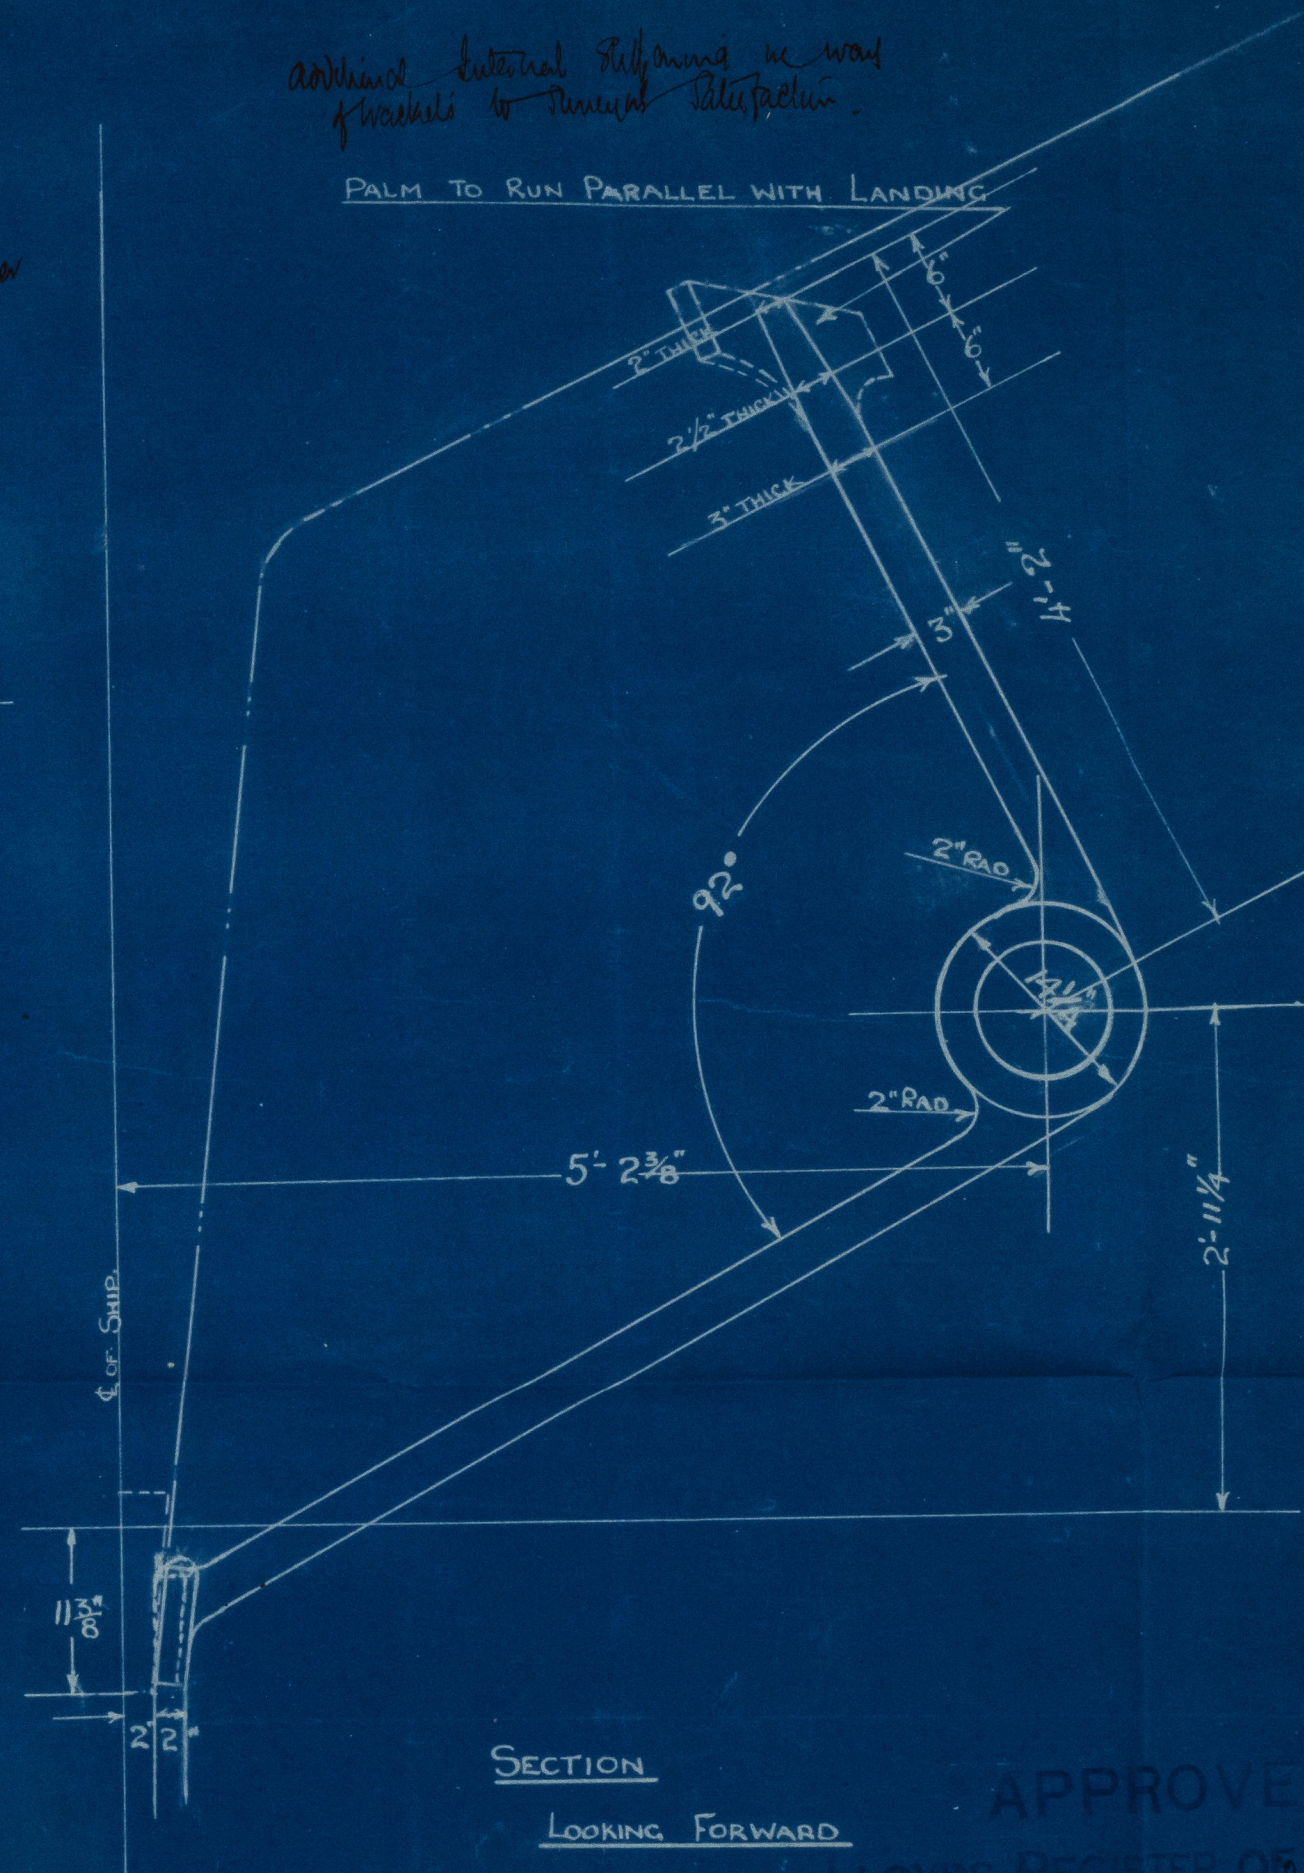

SECTION

LOOKING FORWARD

APPROVED

LLOYD'S REGISTER OF SHIPPING



003013-001005-0001

LLOYDS PLANS. SHAFT BRACKETS. 117

PROPELLER SHAFT BRACKETS

MESSRS COASTER CONSTRUCTION Co.

T. S. S. No. 114.

T. S. S. "MURITAI"

DUNDEE RPT. No. 8420.

✓ No 1

1000-510830-68000



© 2021
Lloyd's Register
Foundation

2261 100 - 5 OCT 1922