


STANDARD VESSEL, TYPE "D."
MIDSHIP SECTION.

LENGTH	BP	285' 0"
BREADTH	M ^L D.	41' 9"
DEPTH	M ^L D.	21'-24'
SCALE 1/2" = 1 FOOT		


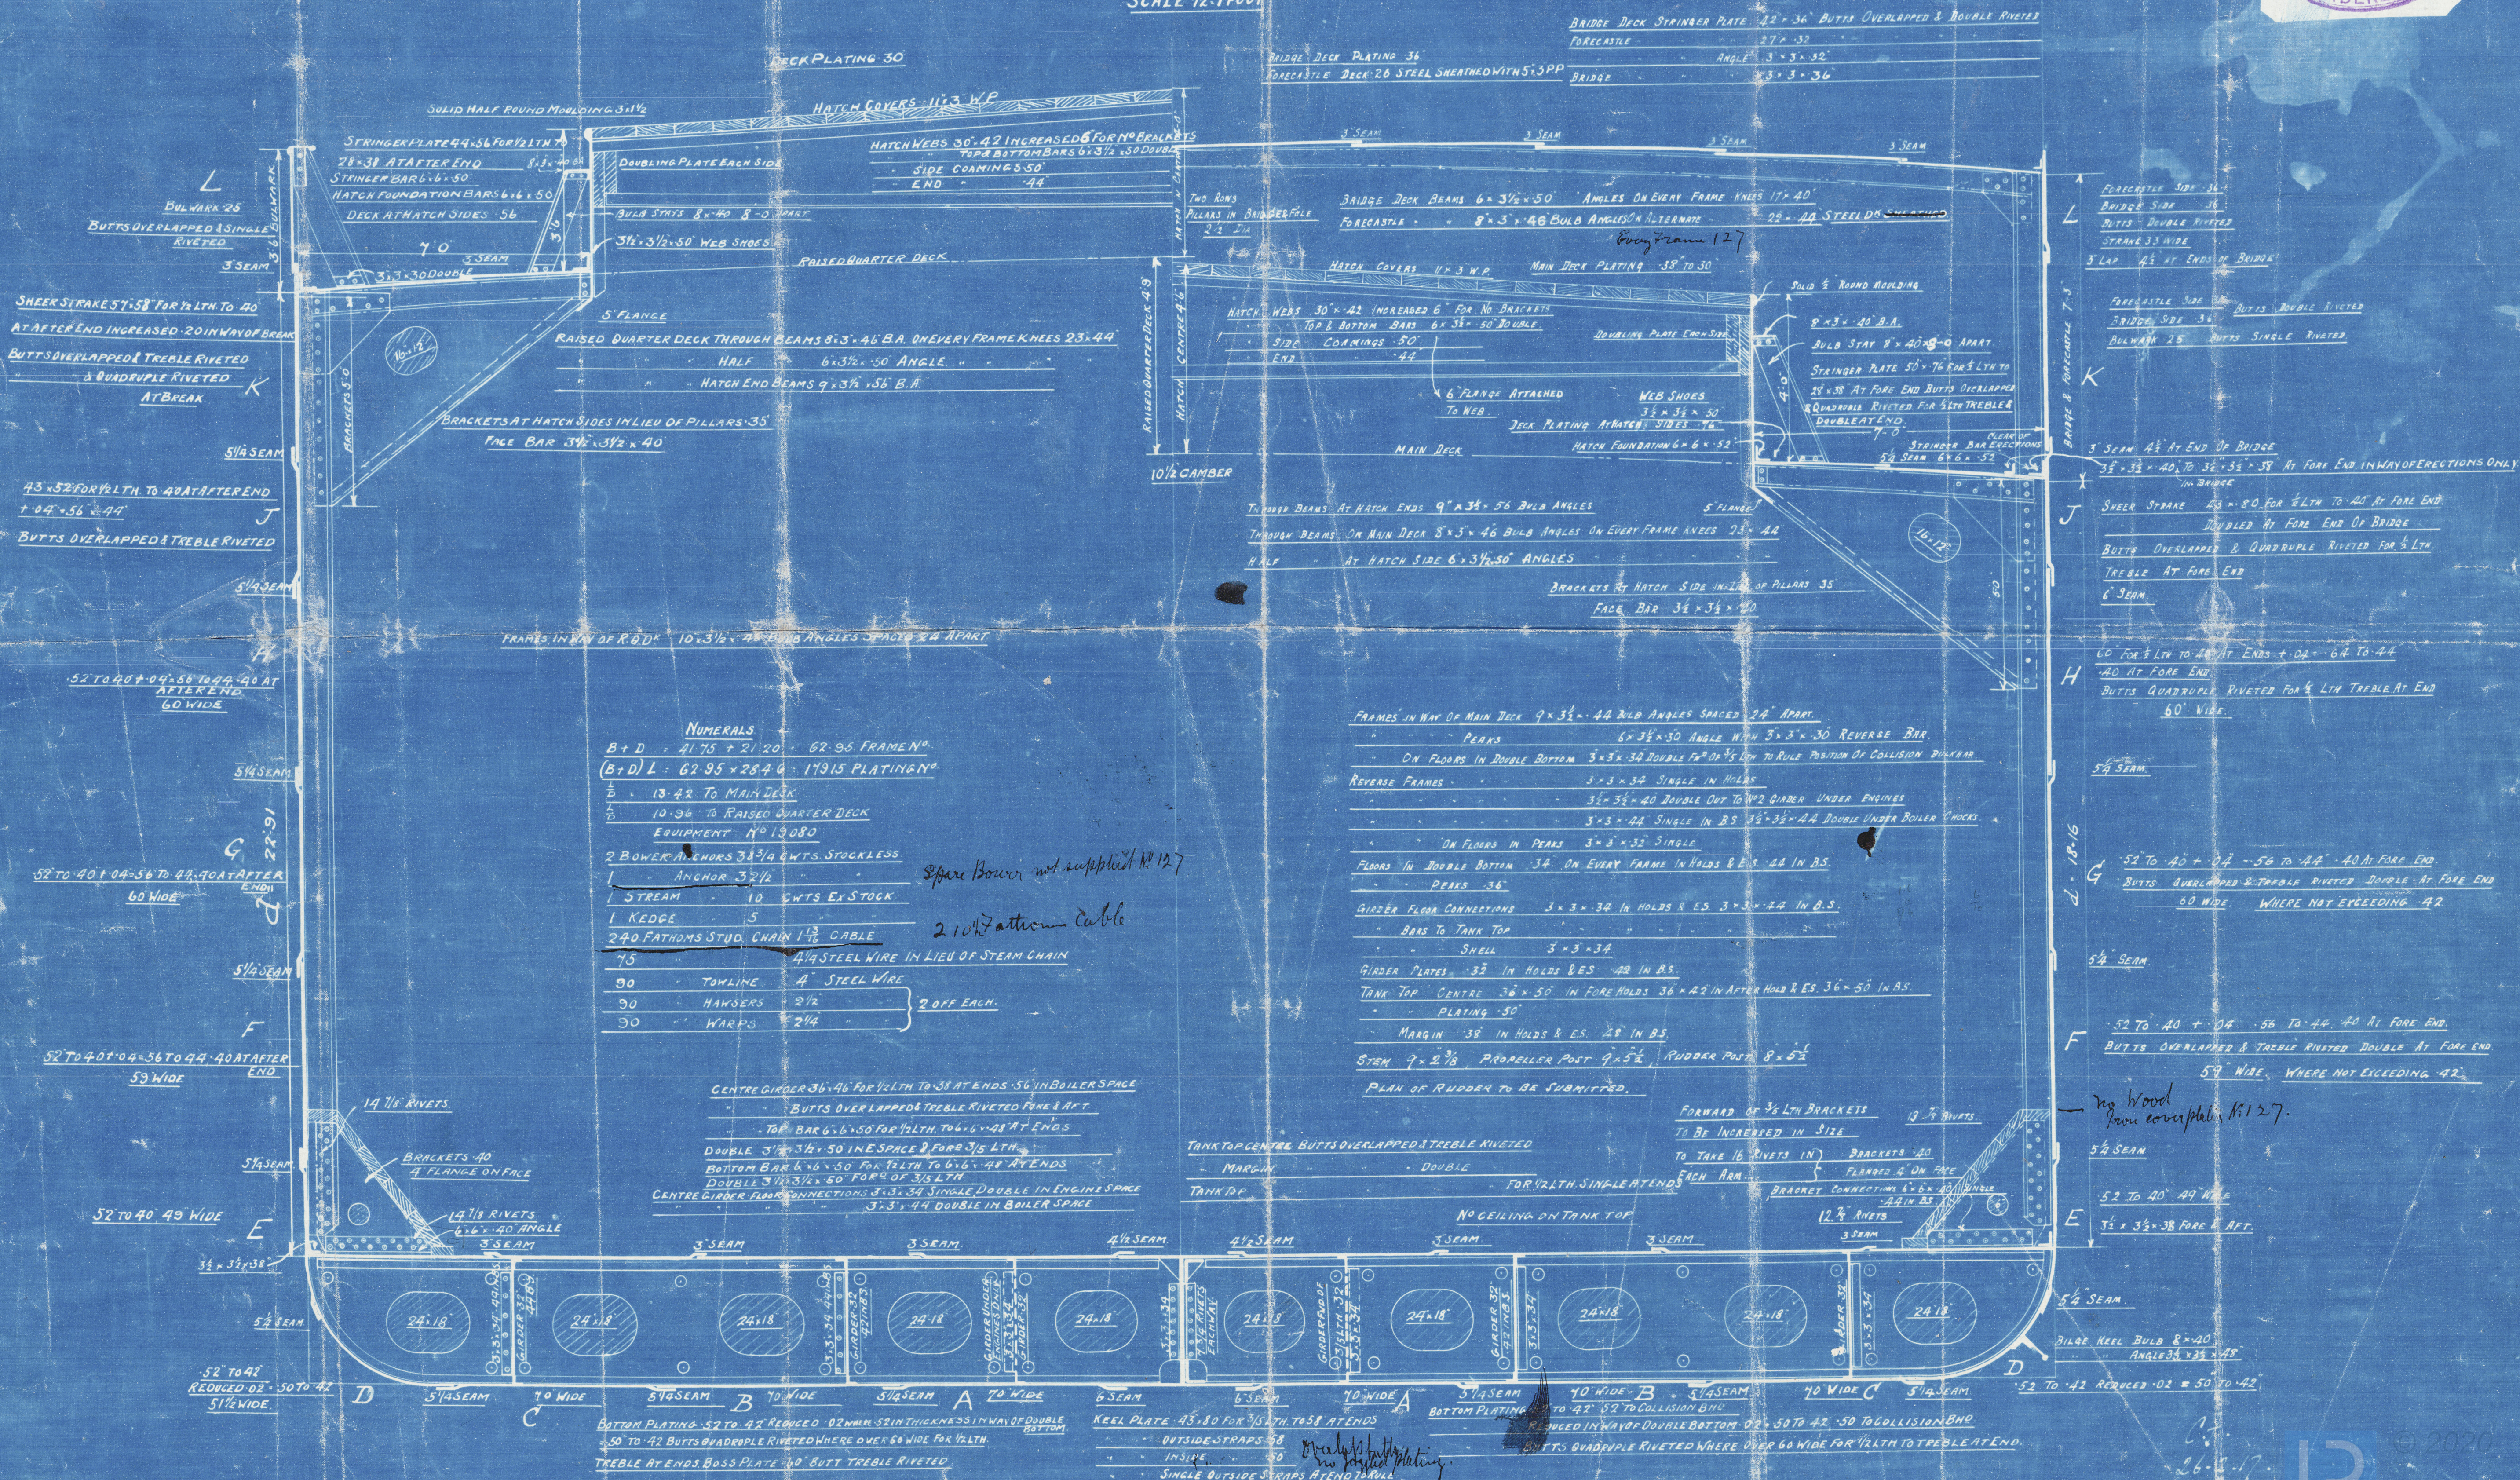


Bristol
Standard Ship Co. Hill & Sons
D. Type No 127 x 8

Midship Section
approved 26.2.17
approved 26.2.17

No 127 s/s War Mustet.
1st Entry R. No 10192

128 s/s War Raper
1st Entry R. No 10219

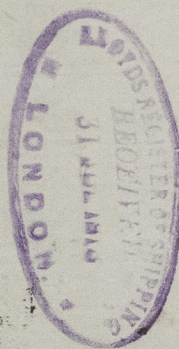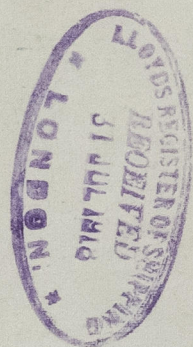

© 2020

Lloyd's Register

Foundation