



PROPOSED AMENDMENT TO CREW'S ACCOMMODATION.

STANDARD "D" TYPE.

SCALE $\frac{1}{4}" = 1 \text{ FOOT.}$

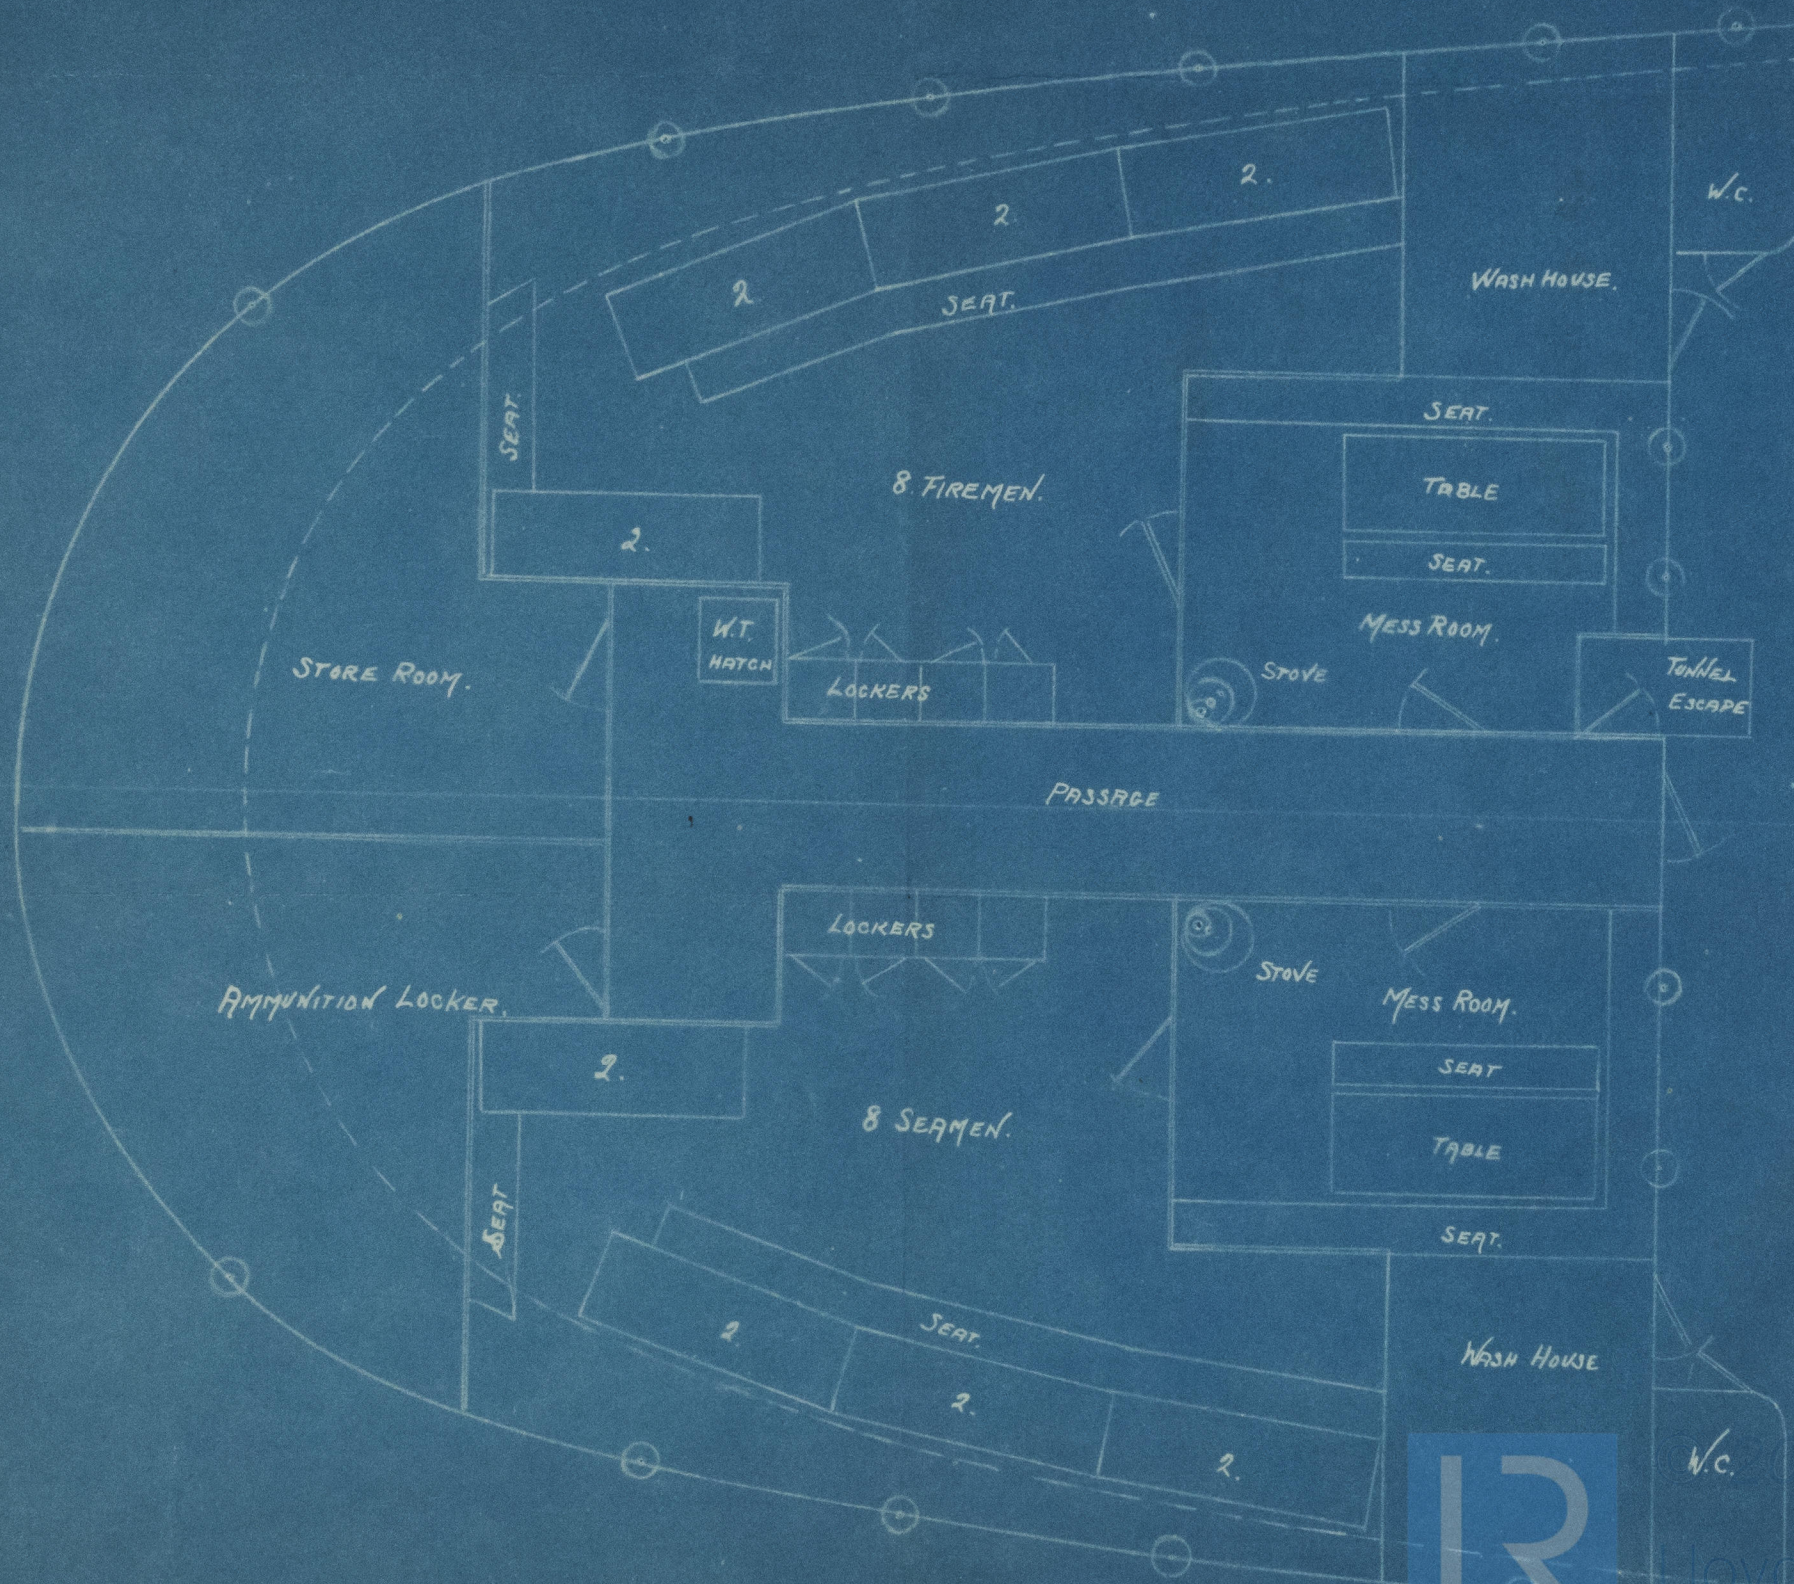

Lloyd's Register
Foundation
008115-008121-0125

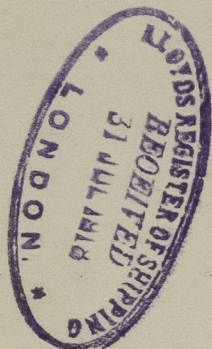

" D " Class.
For the information of the Surveyors at Brs.

(Date) 26.4.18
C. Hill & Sons No 127 & 8

Crew accommodation in Poop

127 s/s. War. Musket

1st Entry Report No. 10192

128 s/s War Repair

1st Entry No 10219



© 2020

Lloyd's Register
Foundation

008115-008121-0125