

Office copy

'RORVIC' EX. H.M.S. 'LLANDUDNO'

PROPOSED CONVERSION TO TWIN SCREW DIESEL MOTOR COASTER TO CLASS LLOYDS SURVEY.

STRUCTURE PROFILE FOR USE WITH MIDSHIP SECTION.


SCALE 1/4" = 1 FOOT.

STRUCTURE ADDED SHOWN IN GREEN.

CHANNER & SONS. SOUTHAMPTON.

See Midship Section for Class and Service Limits.
CLASS AND SERVICE LIMITS.

Wm. Munro. 19/1/49.

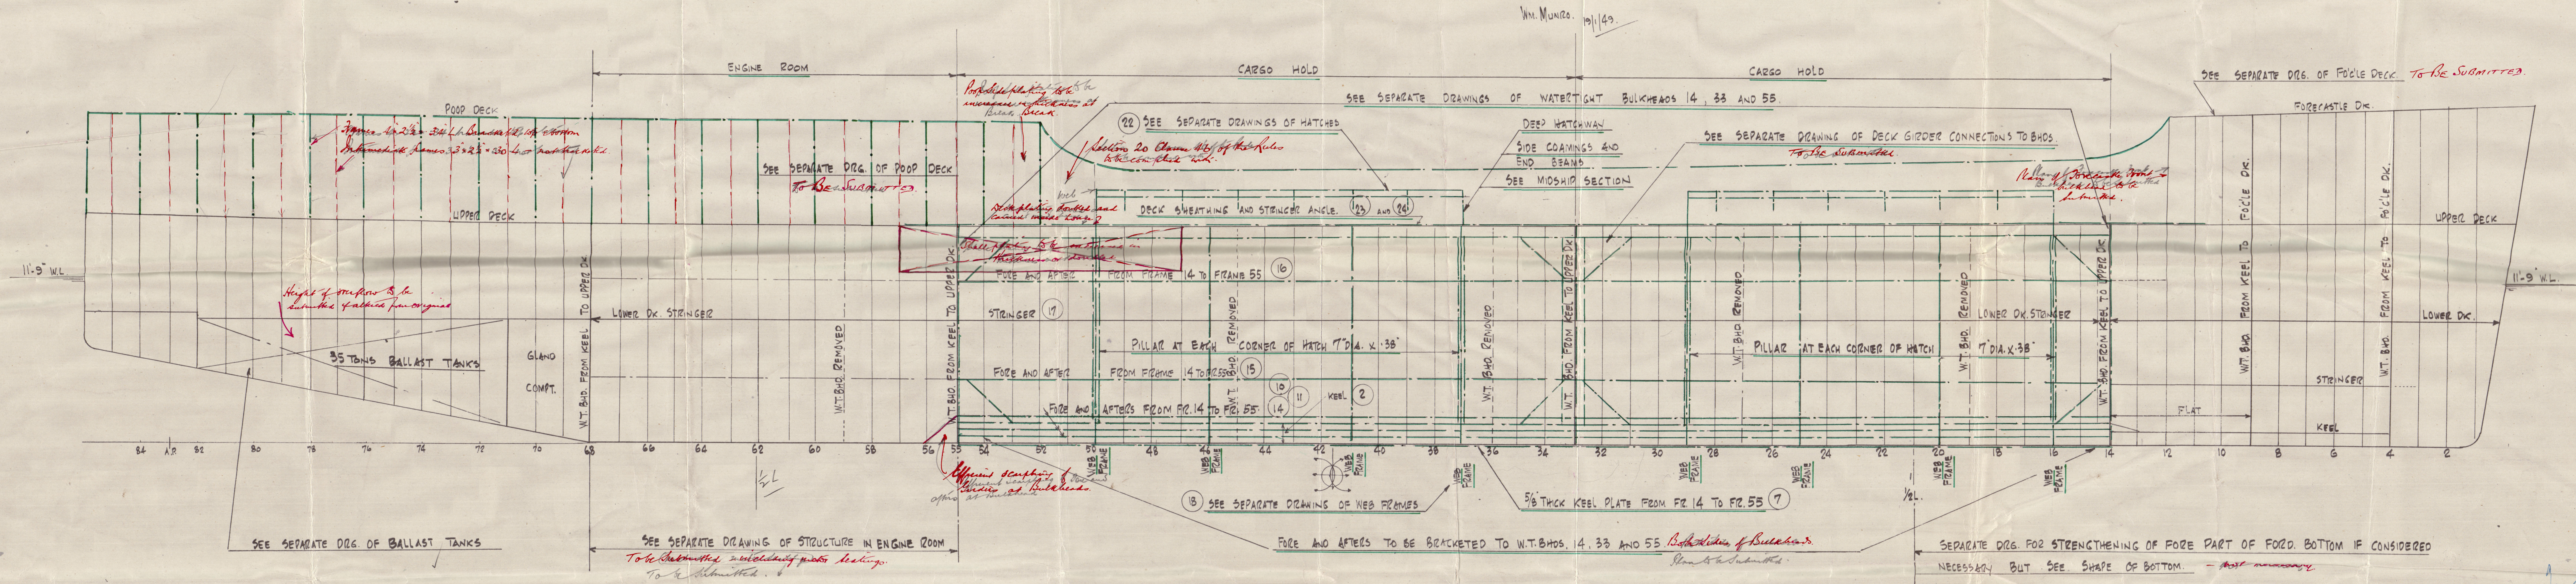

FOR CONVENIENCE NEW STRUCTURE SHOWN CHAIN-DOTTED.

008222-008230-0177

"RORVIR"

RPT. NO. LON. 115293.

Structure Profile



© 2021

Lloyd's Register
Foundation