


ALTERATIONS		
NO.	DESCRIPTION	DATE

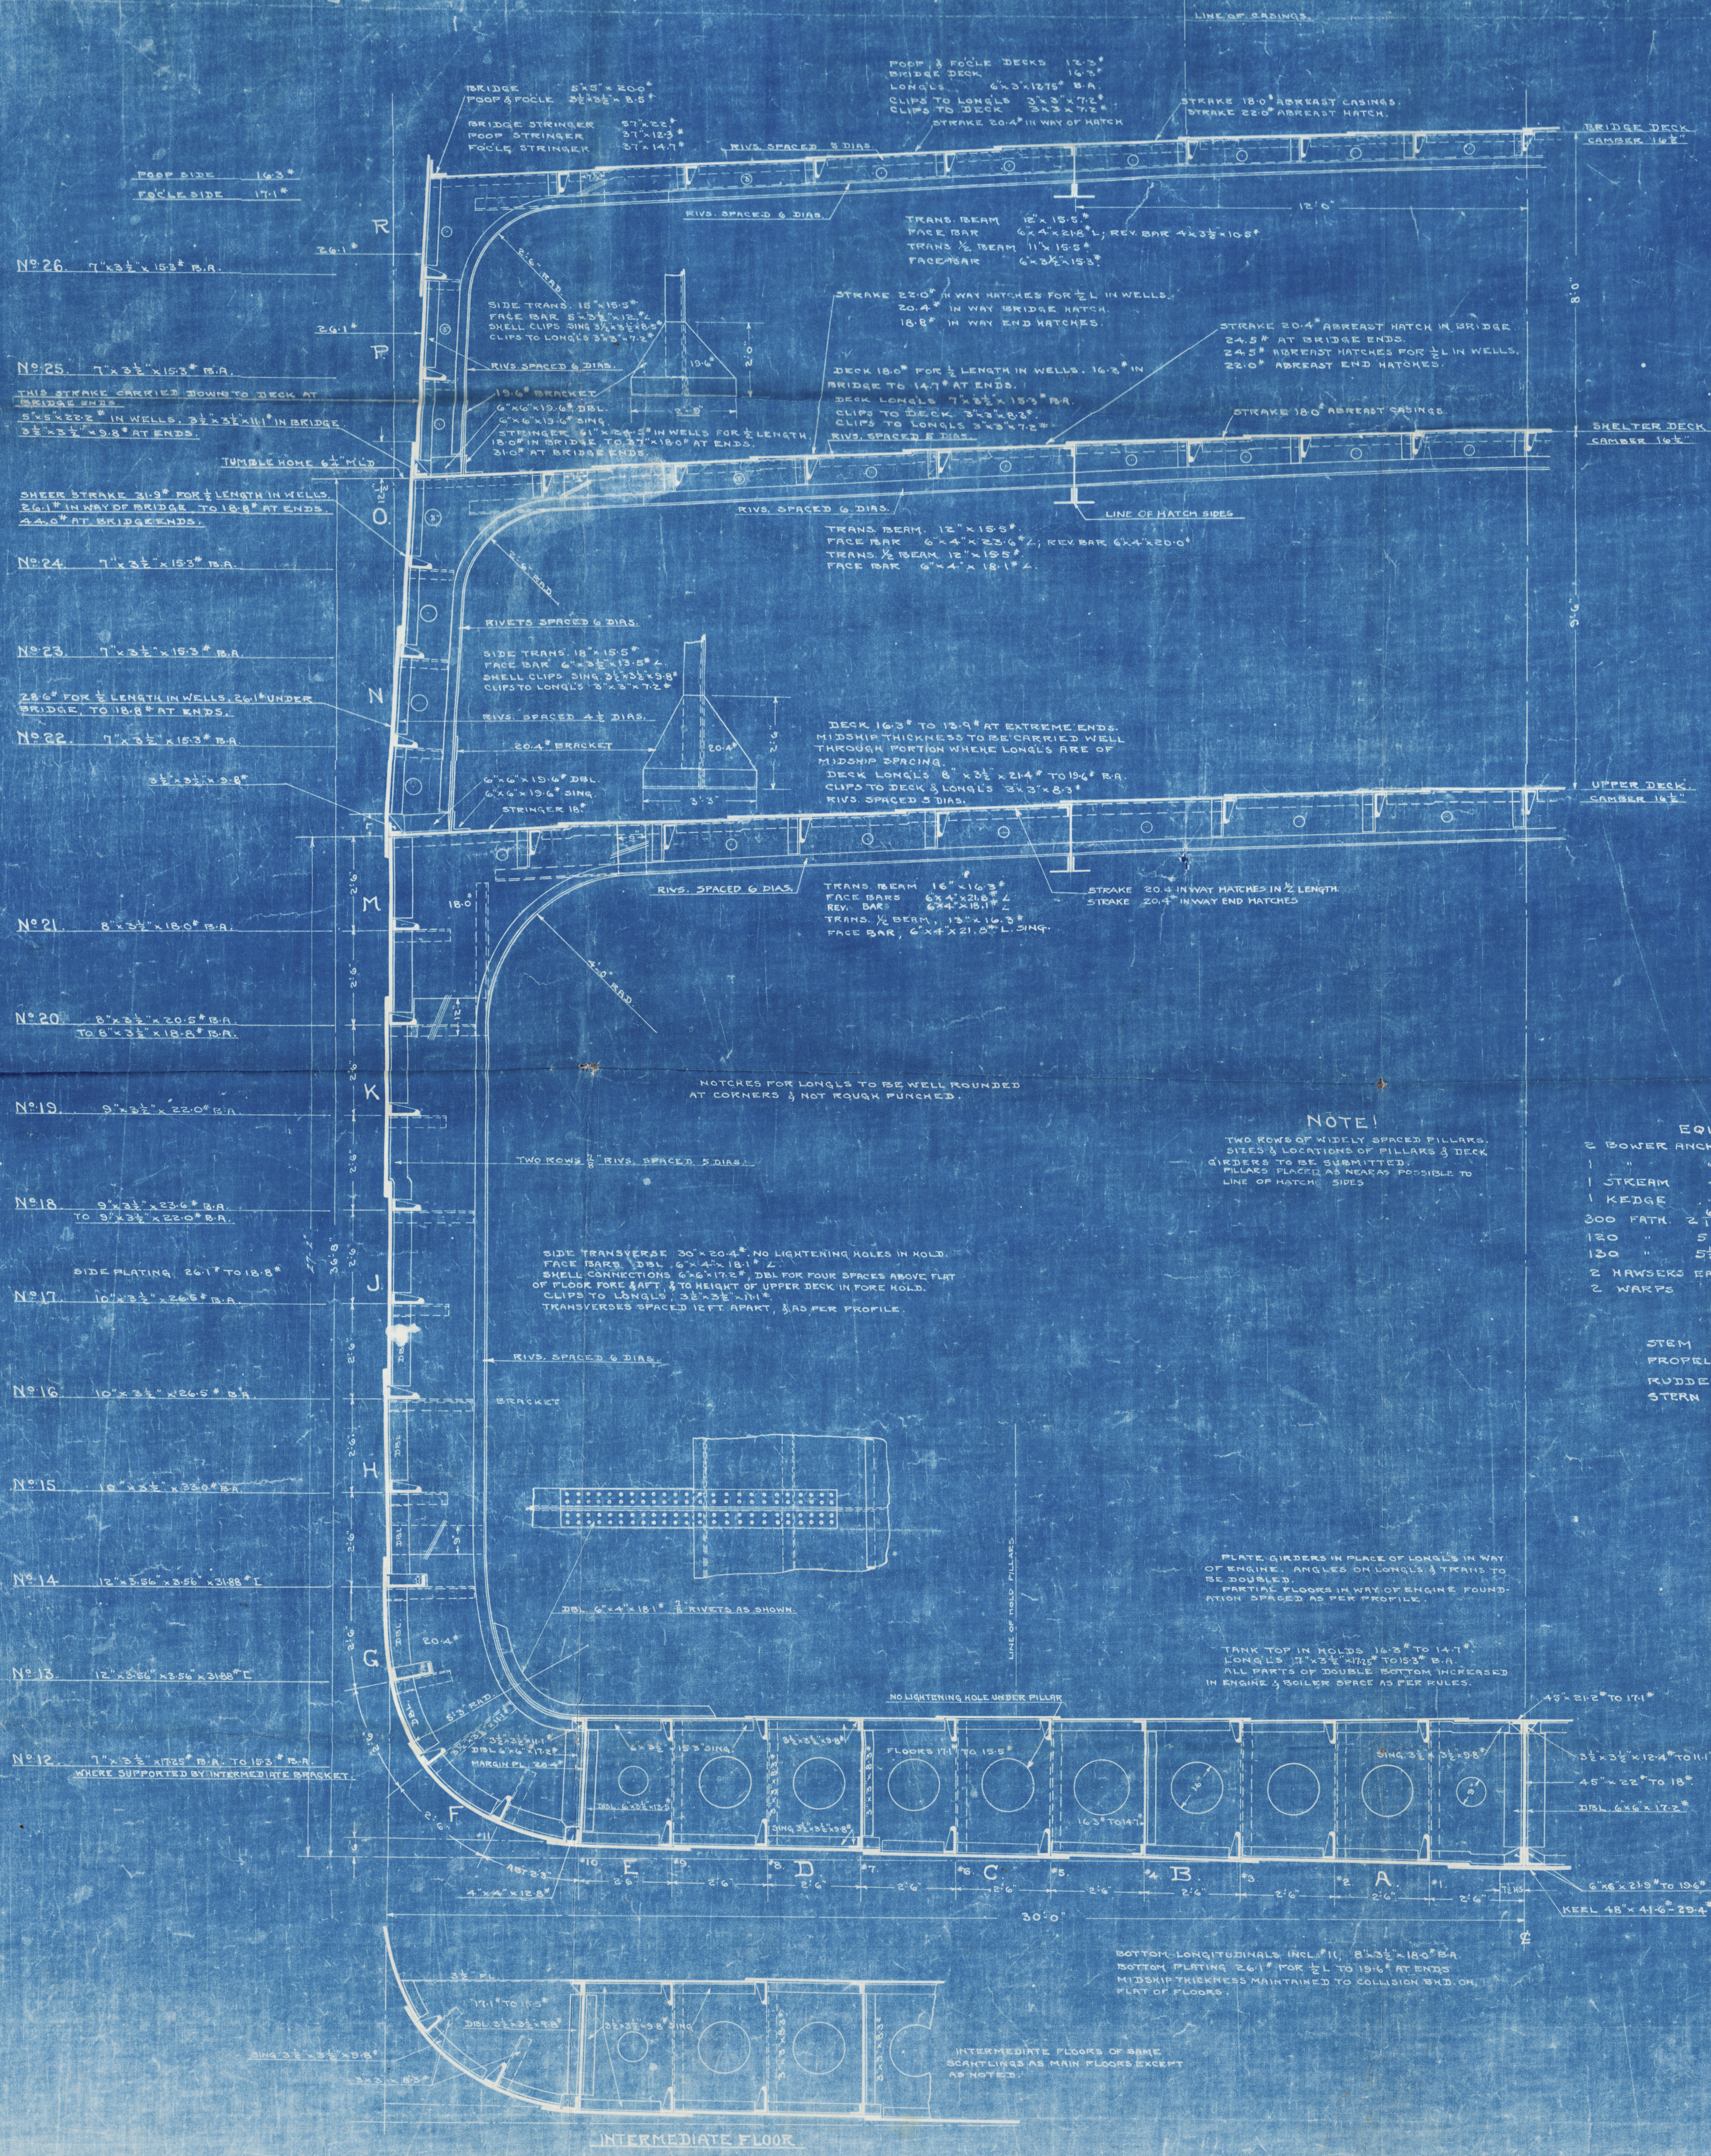

ITEM	NO. OF RIVETS	NO. OF RIVETS PER LINE	NO. OF RIVETS PER LINE	NO. OF RIVETS PER LINE

NOTE:-
TWIN SCREW FOR CONT. CIT
SINGLE SCREW FOR ALL OTHERS

LENGTH LLOYDS	430' 6"
BREADTH MLD	60' 0"
DEPTH SHELTER DECK	36' 8"
SHELTER DECK TYPE	
INCREASED FOR DEEP LOADING	
LLOYDS NUMERALS	
BREADTH	60' 0"
DEPTH FOR RUL. OVR (16' 0" - 8' 0")	28' 6"
TRANS. NO.	58' 6"
LENGTH	439' 5"
LONG. NO.	28' 6"
SHELTER DECK 430' 5" x 36' 8"	26' 8"
PL. DECK (430' 5" x 36' 8") x 36' 8"	13' 2"
BRIDGE HOUSE (340' x 250') x 75' 6"	216' 0"
(440' x 250') x 75' 6"	223' 0"
(520' x 250') x 75' 6"	268' 0"
EQUIP. NUMERAL	43181-0701

THIS PLAN HAS BEEN CORRECTED TO REFLECT
WITH REVISIONS, SHOWN ON THESE REVISIONS
BY LLOYD'S AUG. 24, 1914, & WHICH THEREAFTER
APPROVED BY LLOYD'S 11 OCT. 1914.

ISSUED FOR
CIS

Contract No. C. 715, Structure No. 201
Name: MIDDLE SECTION
3.5 SHELTER DECK CARGO STEAMER
430' 5" x 36' 8" (AM. ST.) MLD
Scale: 1" = 10' 0" H.T.
Date: 10. 1914
Made by: O.S. 23, Traced by: O.S. 23
PENNSYLVANIA © 2020
Lloyd's Register Foundation

008231-008236-0046

By then Allen

008231-008236 -0046



© 2020


Lloyd's Register
Foundation

PRINT No. 15

MADE MAR 30 1920

FOR DEPT. Lloyds

008231-008236-0046

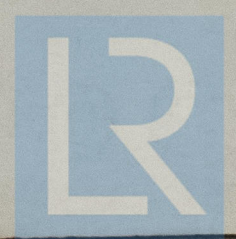

© 2020
Lloyd's Register
Foundation