

Lloyd's Register of Shipping.


Index No. **36900**
 (For London Office only).
 LON. FEB. 11/46

SURVEYS FOR FREEBOARD.

(CONDITIONS OF ASSIGNMENT.)

Ship's Name **KILBRIDE EMPIRE REYNARD** Port of Survey **IPSWICH.**
 Official Number **166692** Surveyor's Signature **A. G. S. G. S.**
 Nationality and Port of Registry **BRITISH LOWESTOFT.** Date of Survey **24-7-42.**

Disposition and dimensions of superstructures, trunks, deckhouses and machinery casings to be inserted in the diagrams and tabular statement: -

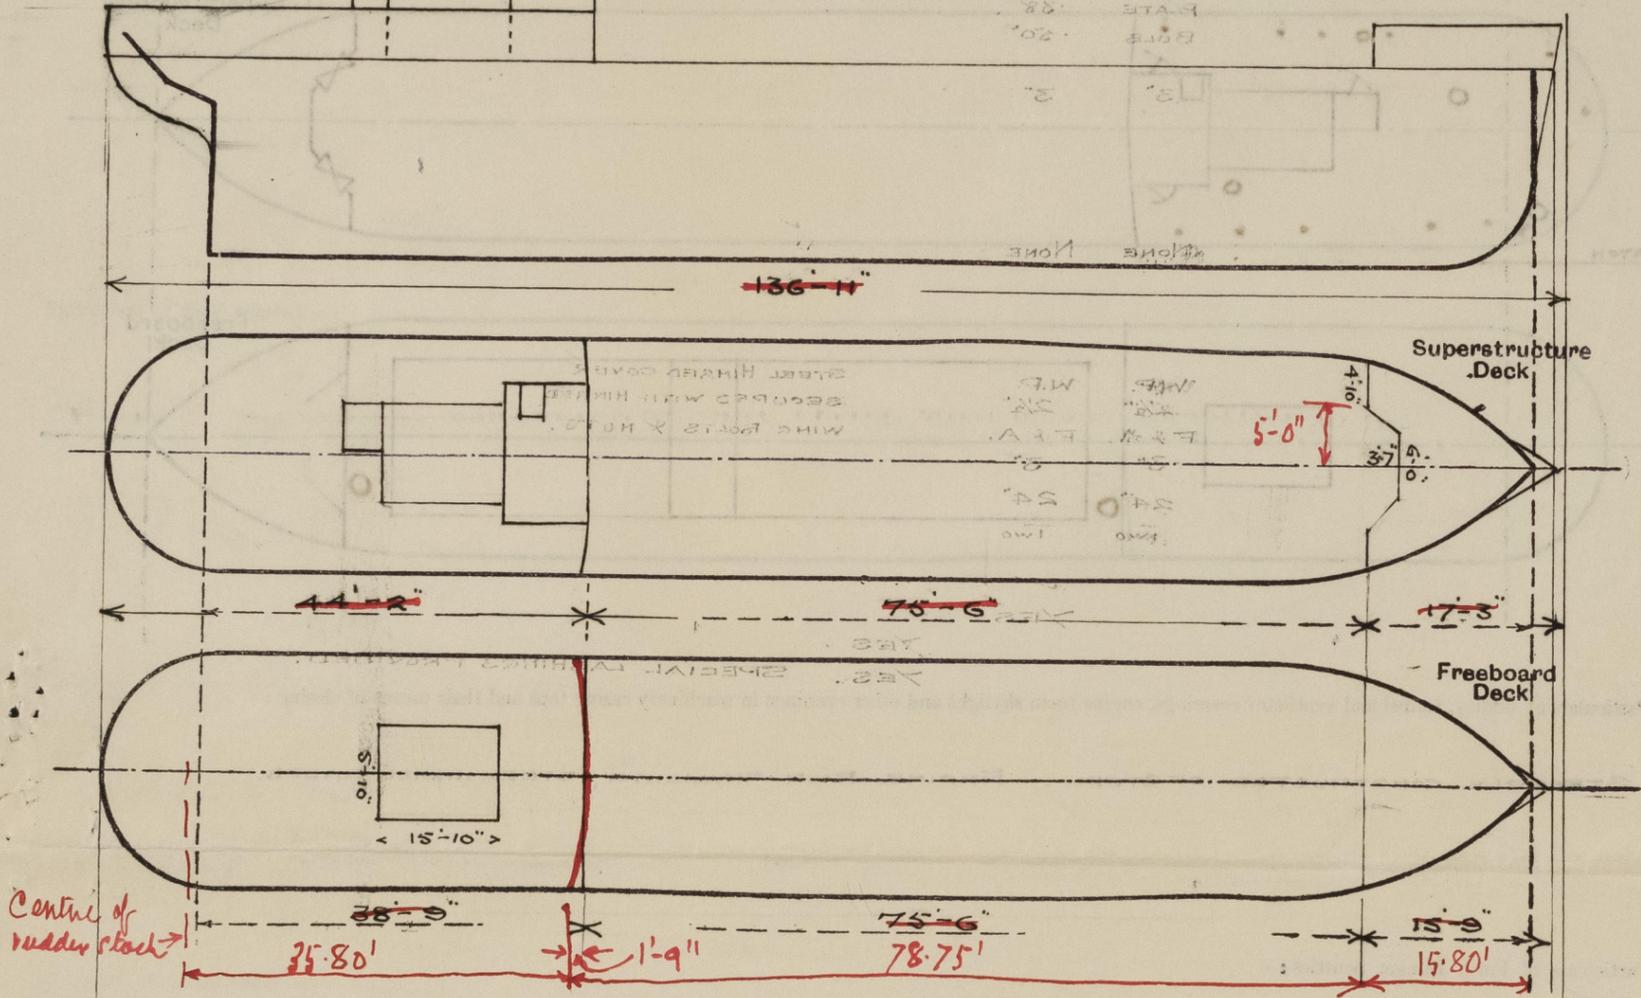

Particulars of Superstructures, Trunks, Casings, Deckhouses.

	Coaming	Plating	Stiffeners	Spacing	End Attachments of Stiffeners	Size of Openings	Height of Sills	Height of Casings
Poop Bulkhead30 ✓	.30 ✓	5 x 3 x 3/8 ✓	28" TO 32"	BRACKETS TOP & BOTT.	NONE	✓	6' 8" / 7' 0"
Raised Quarter Deck Bulkhead ...	✓							
Bridge, After Bulkhead ...	✓							
Bridge, Forward Bulkhead ...	✓							
Forecastle Bulkhead26	.26 ✓	2 1/2 x 2 1/2 x 30	30" ✓	NONE	19 x 46"	12'	5' 0" ✓
Trunk, Aft ...	✓							
Trunk, Forward ...	✓							
Exposed Machinery Casings on Freeboard or Raised Quarter Decks ...	✓							
Exposed Machinery Casings on Superstructure Decks ...	✓							
Machinery Casings within Superstructures not fitted with Class I Closing Appliances30	.25	3 x 2 1/2 x 26	3 1/2"	BRACKETS TOP BOTT. TO GIRDER	21" x 4' 6"	22'	7' 0" ✓
Deckhouses on Flush Deck Ships ...	✓							


Particulars of Closing Appliances (state if capable of being manipulated from both sides).

Poop Bulkhead ...	No openings
Raised Quarter Deck Bulkhead ...	✓
Bridge, After Bulkhead ...	✓
Bridge, Forward Bulkhead ...	✓
Forecastle Bulkhead ...	SHIFTING BOARDS 2" THICK, FITTED IN RIVETED CHANNELS. ✓
Exposed Machinery Casings on Freeboard or Raised Quarter Decks ...	✓
Exposed Machinery Casings on Superstructure Decks ...	✓
Machinery Casings within Superstructures not fitted with Class I Closing Appliances ...	STEEL HINGED DOORS, OPERATED BOTH SIDES. ✓
Deckhouses on Flush Deck Ships ...	✓



PARTICULARS OF PROTECTION TO OPENINGS, ETC.

The following diagrams should be used to indicate the positions of cargo and coaling hatchways, gangway, cargo and coaling ports, ventilators, companionways, etc., which would affect the seaworthiness of the ship:—

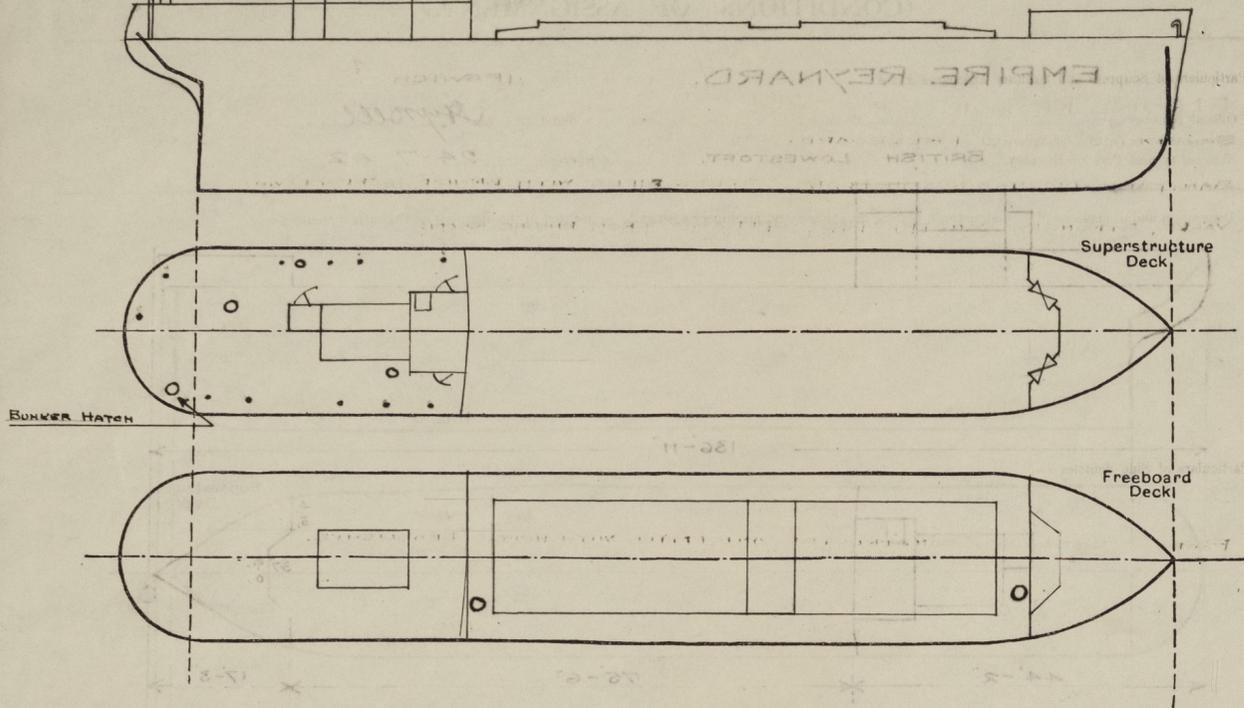

Particulars of fiddle, funnel and ventilator coamings, engine room skylight and other openings in machinery casing tops and their means of closing:—

STRONGLY CONSTRUCTED OF STEEL. ENGINE ROOM SKYLIGHTS, STEEL HINGED COVERS.

Particulars of Flush Bunker Scuttles:—

NONE.

Particulars of Companionways:—

POOP ACCOMMODATION. STRONGLY CONSTRUCTED OF STEEL.

STEEL HINGED DOORS, OPERATED FROM BOTH SIDES. HEIGHT OF SILL 31

Particulars of Ventilators in exposed positions on freeboard and superstructure decks:—

POOP 11 - 5" DIAM. MUSHROOM SCREW DOWN VENTS. TO ACCOMMODATION.
 2 - 7" DIAM. VENTS. TO ALLEYWAY. COAMING 3/2" STEEL. HEIGHT 30".
 1 - 5" DIAM. VENT. TO ACCOMMODATION. COAMING 3/2" STEEL. HEIGHT 30".
 CLOSING ARRANGEMENTS, WOOD PLUGS AND CANVAS COVERS.

HOLD 1 - 10" DIAM. VENT. FORE END OF HOLD. COAMING 3/2" STEEL. HEIGHT 36".
 1 - 8 1/2" DIAM. VENT. AFTER END OF HOLD. COAMING 3/2" STEEL. HEIGHT 36".
 CLOSING ARRANGEMENTS, WOOD PLUGS AND CANVAS COVERS.

Particulars of Air Pipes in exposed positions on freeboard, raised quarter, or superstructure decks:—

F.P.T. 2 1/2" DIAM. HEIGHT ABOVE FREEBOARD DECK 18" } CLOSING ARRANGEMENTS
 A.P.T. 2 1/2" DIAM. HEIGHT ABOVE POOP DECK 18" } WOOD PLUGS AND CANVAS COVERS.

Sillbride.

Particulars of Gangway Cargo and Coaling Ports:—

NONE.

Particulars of Scuppers and Sanitary Discharge Pipes:—

SCUPPERS ABOVE FREEBOARD.
 SANITARY DISCHARGES IN POOP, STEEL PIPES WITH BRONZE SCREW DOWN
 VALVE, STRONGLY CONSTRUCTED, OPERATED FROM ENGINE ROOM.

Particulars of Side Scuttles:—

POOP. STRONGLY CONSTRUCTED, AND FITTED WITH HINGED DEADLIGHTS.

Vertical distance of Sill of lowest Side Scuttle above top of keel

15'-1"

Particulars of Guard Rails:—

FORECASTLE 3 RAILS, 3'-2 1/2" HIGH, STANCHIONS SPACED 4'-0" APART.
 POOP. Do Do Do 4'-6" Do.

Particulars of Gangways, Lifelines, etc.:—

EFFICIENT LIFELINES STRETCHED BETWEEN POOP & FORECASTLE BULKHEADS.

Particulars of Freeing Arrangements.

	Length of Bulwark	Height of Bulwark	Size of Freeing Ports	Number each side	Area each side	Rule area each side
After Well ...	78.75'	3'-2 1/2"	36" x 15 1/2"	4	16.2 sq ft	15.8 sq ft
Forward Well ...						

State position of each freeing port ... } After Well:— FROM POOP BULKHEAD. 9'-6", 25'-0", 42'-0", 62'-0".
 (F. and A. position and height above deck edge) } Forward Well:— HEIGHT ABOVE DECK AT SIDE 7."

State whether the freeing ports are fitted with shutters, bars, or rails, and give particulars of such:— STEEL HINGED SHUTTERS.

Additional area where sheer is less than standard.

PARTICULARS OF PROTECTION TO OPENINGS, ETC.

HATCHWAYS ON FREEBOARD AND SUPERSTRUCTURE DECKS.						
Description of Hatchway	No 1	No 2.		BUNKER HATCH		
Dimensions of Hatchway	20' x 16.5'	35.75' x 16.5'		16' x 12'		
COAMINGS	Height above Deck	36"	36"	12"		
	Thickness	.38"	.38"	.38"		
	Stiffeners	✓	✓	✓		
	Brackets, Stays	✓	✓	✓		
HATCH BEAMS	Number	4	5			
	Spacing	4'-0"	3'-7"			
	Scantling and Sketch	ANGLES 3" x 3" x 42"	3" x 3" x 42"			
FORE AND AFTERS	Number	NONE	NONE			
	Spacing					
HATCH COVERS	Material	W.P.	W.P.	STEEL HINGED COVER		
	Thickness	2 1/2"	2 1/2"	SECURED WITH HINGED		
	How fitted	F & A	F & A	WING BOLTS & NUTS.		
	Bearing Surface	3"	3"			
Spacing of Cleats	24"	24"				
Number of Tarpaulins	Two	Two				

*Are wood fore and afters steel shod at all bearing surfaces? YES
 Are battens and wedges efficient and in good condition? YES
 Are tarpaulins in good condition and in accordance with rule requirements? YES
 Are lashings provided in accordance with rule requirements? YES. SPECIAL LASHINGS PROVIDED.

Particulars of any special features:—

Endorsement at first survey and at surveys for renewal of Certificate:—

The fittings and appliances are in accordance with the particulars shown on this form (or as now modified) and are in good condition.



© 2021

Lloyd's Register Foundation