

Single Screw Cargo Steamer.

No 109.

Midship Section.

Dimensions: 178'-0" x 28'-9" x 13'-3".

To Class 100A1 at Lloyds. Raised Quarter Deck.

Scale: 1/2" = 1 Foot.

Lloyds' Numerals.


B	=	28.75
D	=	13.25
B+D	=	42.00 Transverse N° = 45
L	=	178.00
L x (B+D)	=	7,476.00 Longitudinal N°
d	=	10.75 Main Deck
d	=	13.75 Raised Quarter Deck in way of Double Bottom.
d	=	14.00 " " " " Floor Plates.

Proportions.

L/B	=	13.42 Main Deck
L/D	=	10.95 Quarter Deck.

Equipment.


Raised Quarter Deck	23' 6" x 3' =	280.00
Bridge Deck	11' x 7' x 7' =	57.66
Forecastle Deck	23' x 7' x 7' =	119.91
Casings	52.5 x 7 x 5 =	183.75
2nd N°		7476.00
Equipment N°		8117.32
3 Bower Anchors (stockless)	48 CWT Collective Weight	
1 Stream Anchor	4 1/2"	
1 Kedge	2 1/4"	
210 fathoms of 7/16" stud link Chain Cable		
75 "	2 3/4" steel wire Tow-Line	
30 "	2 1/4" " " " " " "	
60 "	3 " " " " " "	
30 "	1 1/2 " " " " " "	

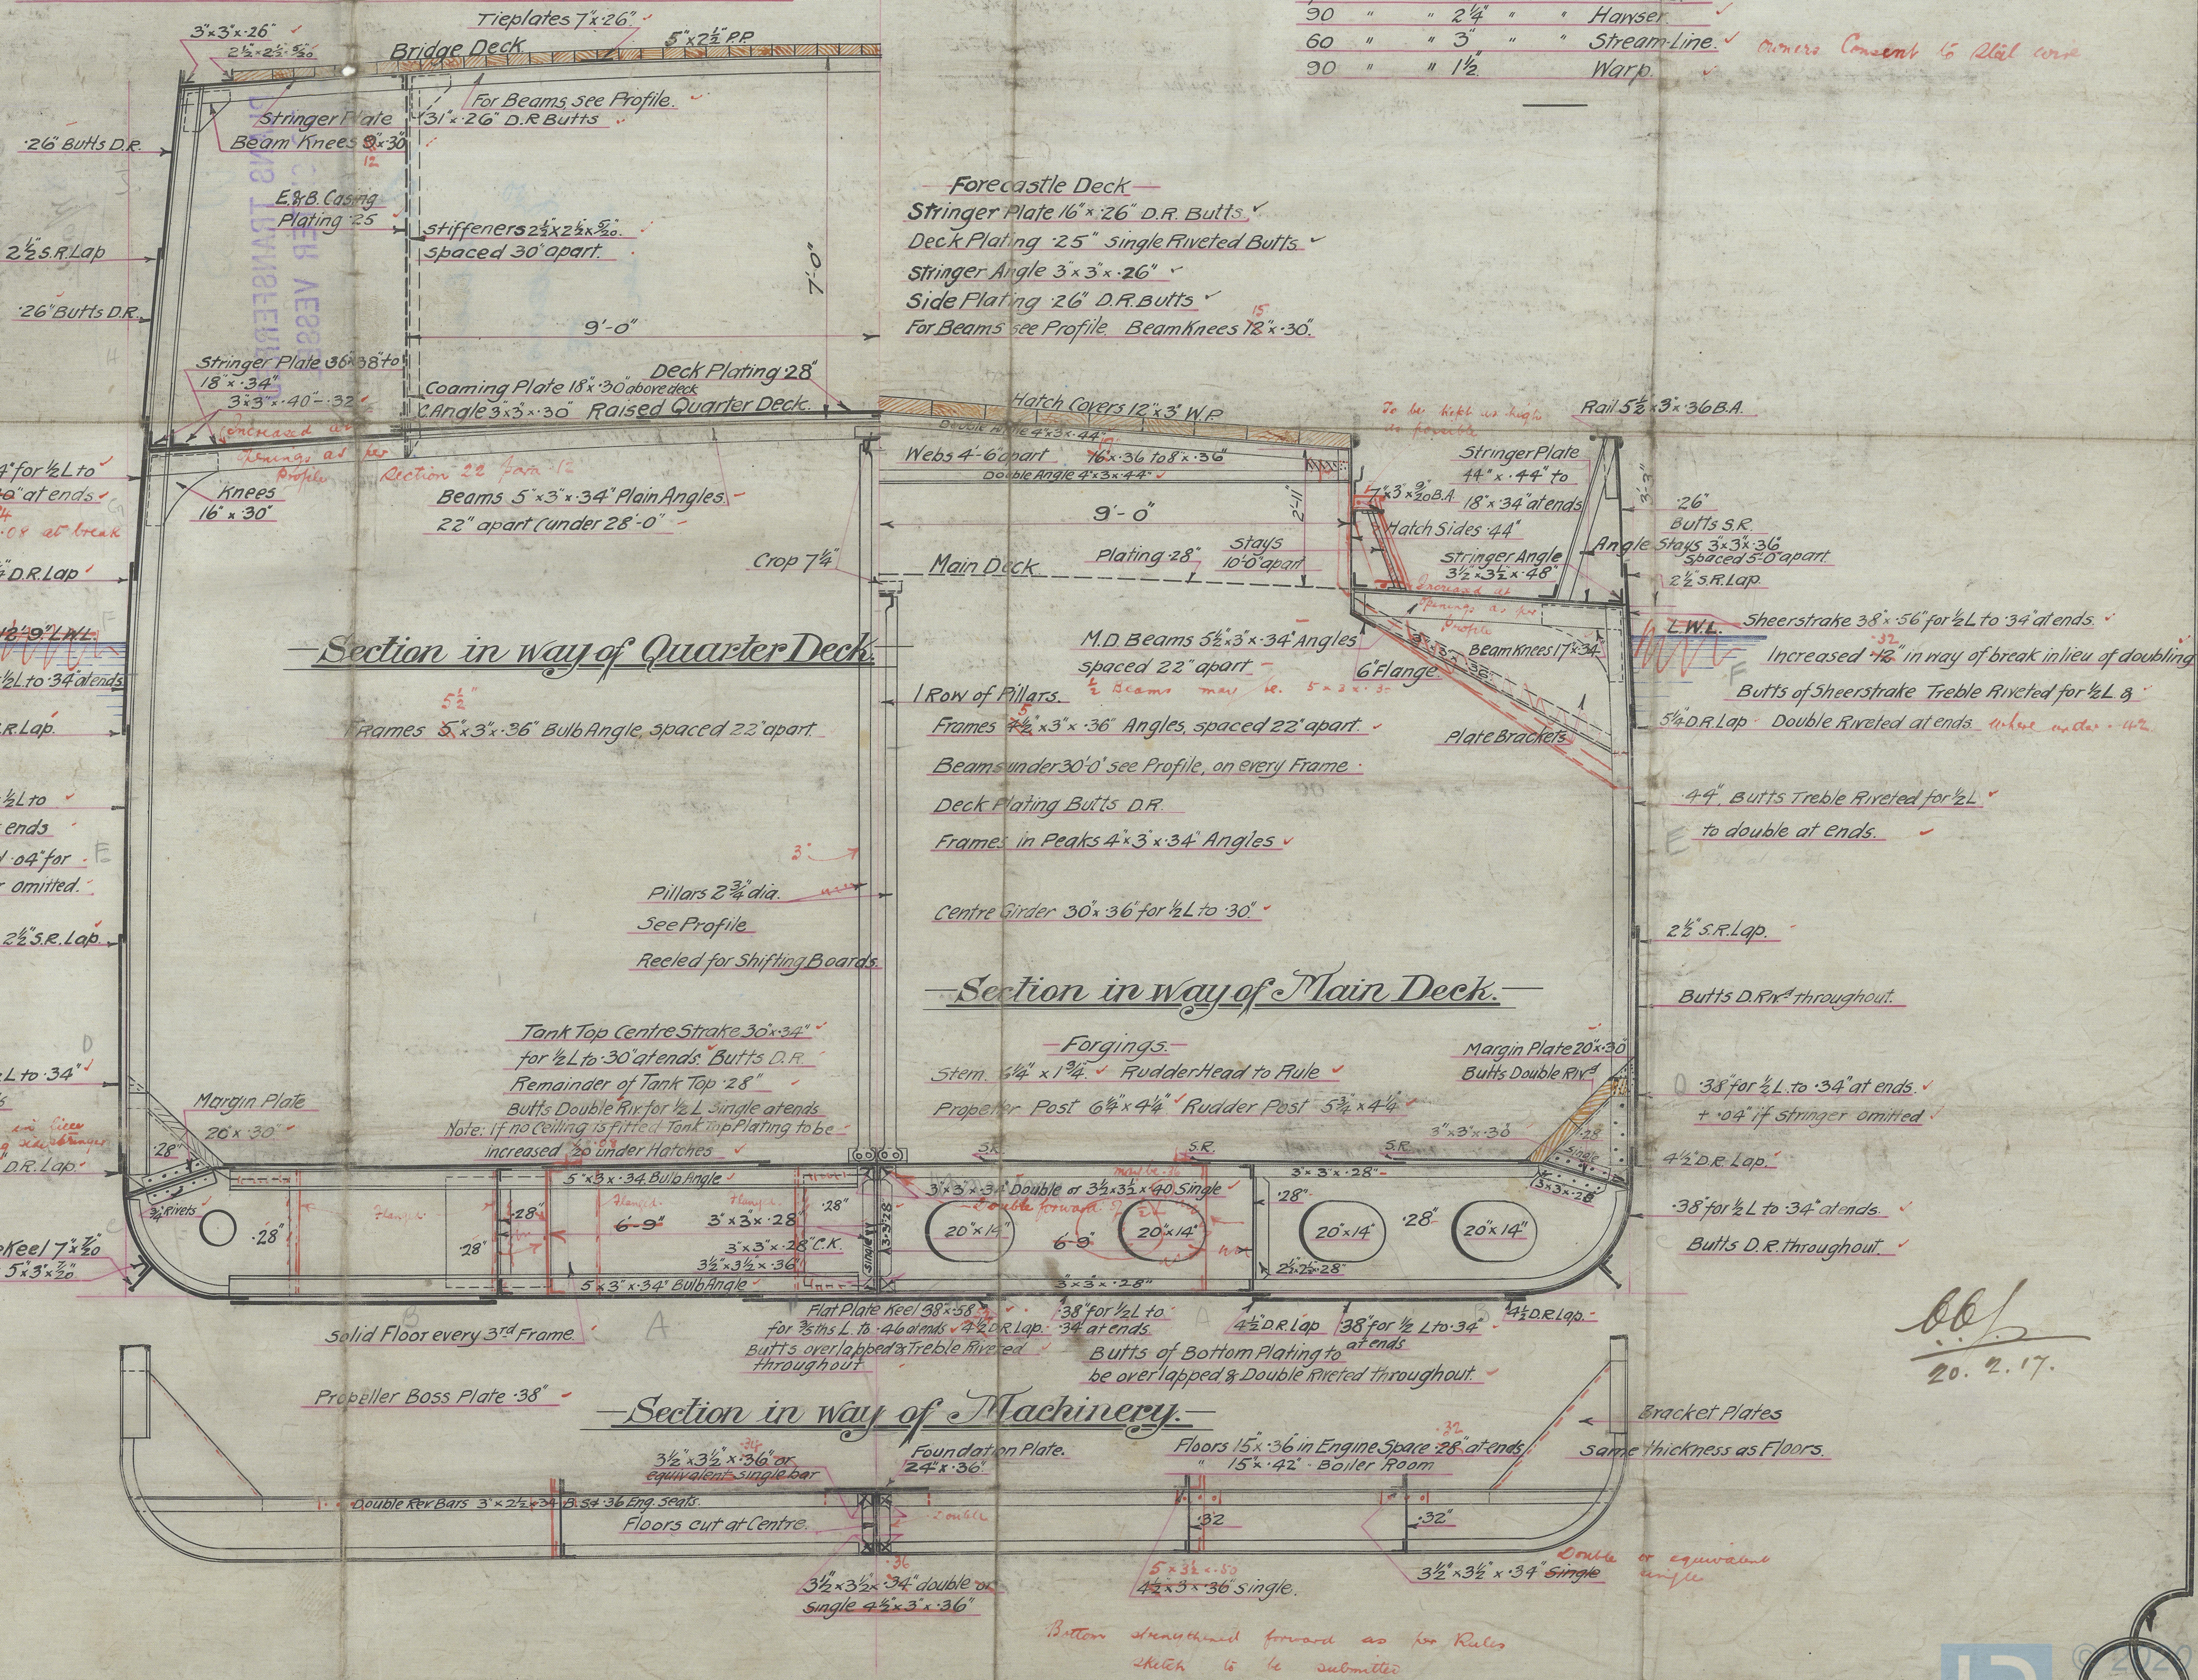

DIBLES LIMITED.

10th July/17

bb/ 20. 2. 17.

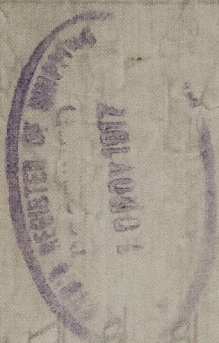

Southamp. 100

Mess: Dibbs Lt. Sou:

Nº 109

MIDSHIP SECTION.

Son: Report Nº 10240

** Mors.*

Awanville

W. S.

**PLANS TRANSFERRED
TO SISTER VESSEL**

008407-008416-0081

Sao

Silver


*En
bustario*

*as
ser*



© 2020

Lloyd's Register
Foundation

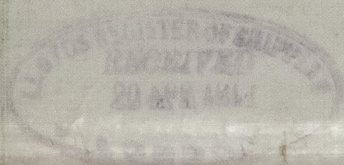

12007914200-104300

Equipment	8117.35
2nd Hs	7476.00
Casings	252x75 - 183 75
Toplastic Truck	177.41
3 Stone Anchors (stockless) 48k	
1 Stream Anchor	
1 Knots	
210 ft of 1/2" stud link Chain	
2 1/2" Steel wire for	
30	
60	
20	



© 2020
Lloyd's Register
Foundation