

—Scale: $\frac{1}{2}"=1\text{Foot}$. Details: $1\frac{1}{2}"=1\text{Foot}$.—

—Sketch of Propeller Nul.—

Scale: 3" = 1 Foot.



—Elevation of Arms.—

Detail of Heel Pintle.

1 1/16 Holes spaced 5" cr. to cr.

Messrs. Dible's L^d Son:

ss. No. 109. & 112, 115.
116.

Stempost, Rudder & Stem

(109) Son: Report N^o 10240. ^{Mons.} *


(112) Son: Rpt No. 10456

9. Afon Towy.

(115) Son Rpt No. 10641.


Report No 10947.

S.V.
PLANS TRANSFERRED
TO SISTER VESSEL

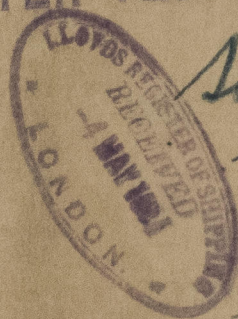

Sao
Silverio
Ex
Carters

Dis See
582

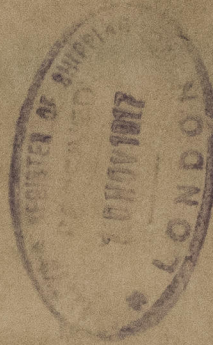

AVANVILLE

