PRINCIPAL DIMENSIONS

LENGTH B.P.	416'-0"
BREADTH EXTR.	57'-1"
BREADTH MLD.	56'-10½"
DEPTH MLD. UPPER DK.	37'-4"
DEPTH MLD. SECOND DK.	28'-7"
DEPTHS TO LENGTH-UPPER DK.	11.14

NOTE: DO NOT USE LARGER ROD THAN 3/16" DIAMETER. NO RIVETING TO BE DONE UNTIL WELDING IS COMPLETED. BUTT WELDS IN ALL CASES TO HAVE A FINISHING BEAD. FIRST TWO BEADS IN BUTT WELDS TO BE WELL PEENED.

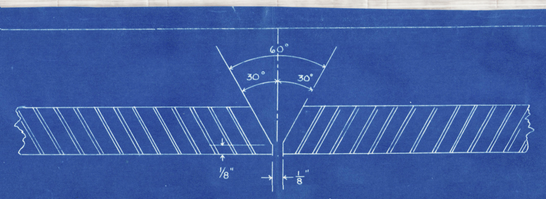

PLATES TO BE VEED OUT TO A 60° INCLUDED ANGLE FOR ALL BUTT WELDS AND BEVELLED TO WITHIN 1/8" FROM BOTTOM PLATE. GAP OF 1/8" TO BE KEPT BETWEEN EDGES TO BE WELDED

SHEERSTRAKE .70" WITH TWEEN DK. FRAMES ON EVERY FRAME TO .45" AT ENDS
STRAKE BELOW SHEERSTRAKE .61" TO .45" AT ENDS.

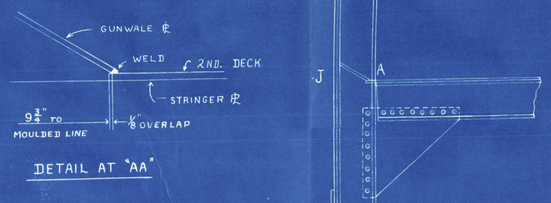

DETAIL AT "AA"

DETAIL OF DRAIN HOLE.

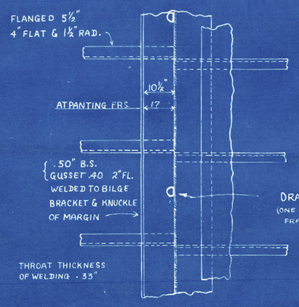

DETAIL OF TANK GUSSETS

SIDE SHELL .61" WITH 30" SPACING TO .45" AT ENDS.
SIDE SHELL 25% ABOVE END THICKNESS = .56" IN WAY OF PANTING IN LIEU OF STRINGERS FOR A DISTANCE AFT OF ROLE POSITION OF COLLISION BHD. EQUAL TO 10% L. OF VESSEL.
SIDE SHELL 25% ABOVE END THICKNESS = .56" IN WAY OF FORE PEAK TANK IN LIEU OF STRINGER CONNECTIONS TO SHELL.
BOSS PLATING .70"
OUTER PLATE INCREASED 25% ABOVE RULE.

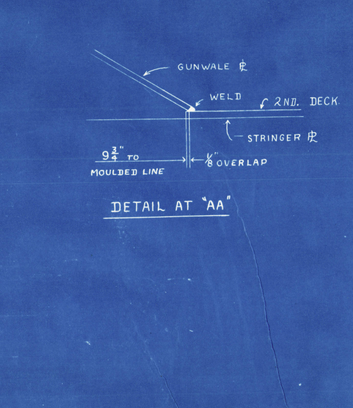

⅞" RIVETS IN NUMBER TO SUIT LENGTH OF KNEE. MIN. NO RIVETS = 16

ARRGT OF BILGE BRACKETS IN NO. 1 HOLD

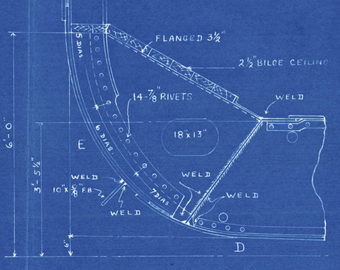

DETAIL OF BILGE BRACKETS AFT OF FRAME 66 & FOR'D OF FRAME 106 (EXCEPT NO. 1 HOLD)

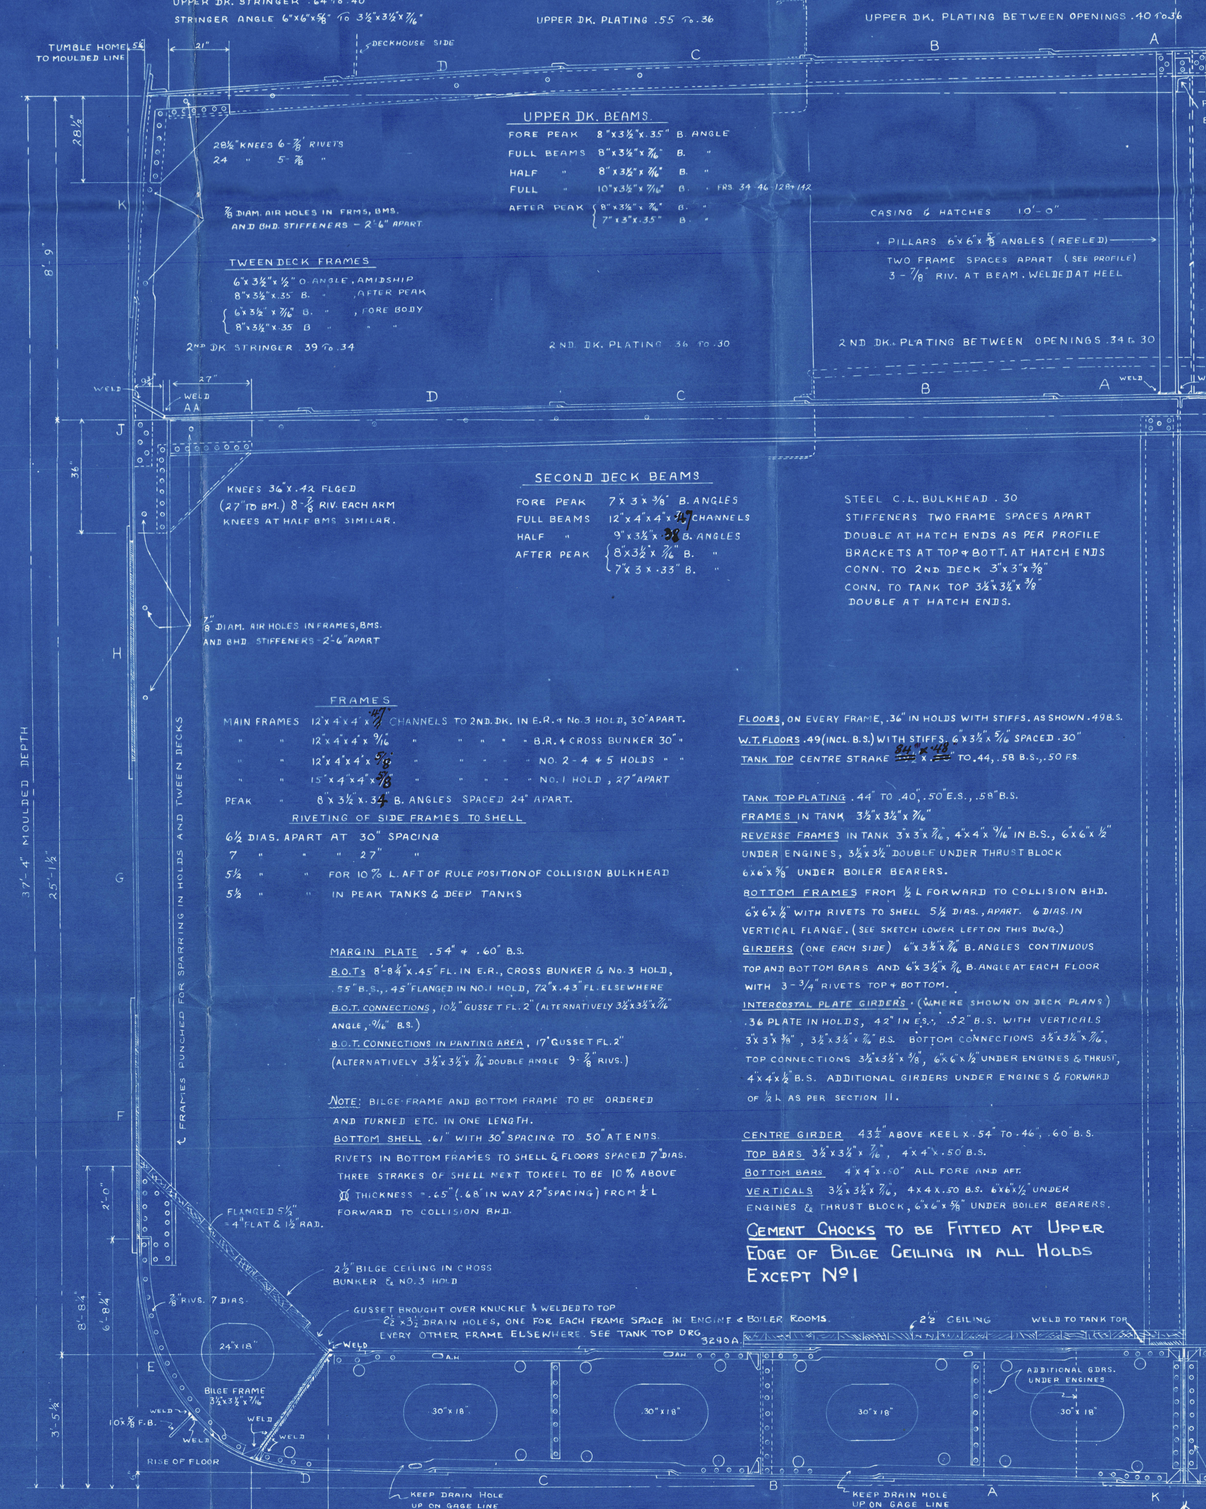

UPPER DK. BEAMS.

FORE PEAK	8"x3½"x.35" B. ANGLE
FULL BEAMS	8"x3½"x⅞" B. "
HALF "	8"x3½"x⅞" B. "
FULL "	10"x3½"x⅞" B. " FRS. 34 46 128+142
AFTER PEAK	8"x3½"x⅞" B. "
	7"x3"x.35" B. "

TWEEN DECK FRAMES

6"x3½"x½" O. ANGLE, AMIDSHIP
8"x3½"x.35 B. " AFTER PEAK
6"x3½"x⅞" B. " FORE BODY
8"x3½"x.35 B. " " "

2ND DK STRINGER 39 To 34

UPPER DK. STRINGER 64 To 40
STRINGER ANGLE 6"x6"x⅝" To 3½"x3½"x⅞"

UPPER DK. PLATING .55 To .36

UPPER DK. PLATING BETWEEN OPENINGS .40 To 3/6

2ND. DK. PLATING .36 To .30

2ND DK. PLATING BETWEEN OPENINGS .34 & 30

SECOND DECK BEAMS

FORE PEAK	7"x3"x.36" B. ANGLES
FULL BEAMS	12"x4"x4"x.44" CHANNELS
HALF "	9"x3½"x.38" B. ANGLES
AFTER PEAK	8"x3½"x⅞" B. "
	7"x3"x.33" B. "

STEEL C.L. BULKHEAD .30
STIFFENERS TWO FRAME SPACES APART
DOUBLE AT HATCH ENDS AS PER PROFILE
BRACKETS AT TOP & BOTT. AT HATCH ENDS
CONN. TO 2ND DECK 3"x3"x⅜"
CONN. TO TANK TOP 3½"x3½"x⅜"
DOUBLE AT HATCH ENDS.

FRAMES

MAIN FRAMES 12"x4"x4"x.44" CHANNELS TO 2ND. DK. IN E.R. & No. 3 HOLD, 30" APART.
" " 12"x4"x4"x⅜" " " " " " B.R. & CROSS BUNKER 30" "
" " 12"x4"x4"x⅝" " " " " " NO. 2-4-5 HOLDS " "
" " 15"x4"x4"x⅞" " " " " " NO. 1 HOLD, 27" APART
PEAK " 8"x3½"x.34" B. ANGLES SPACED 24" APART.

RIVETING OF SIDE FRAMES TO SHELL

6½ DIAS. APART AT 30" SPACING
7 " " " 27" "
5½ " " FOR 10% L. AFT OF RULE POSITION OF COLLISION BULKHEAD
5½ " " IN PEAK TANKS & DEEP TANKS

MARGIN PLATE .54" & .60" B.S.
B.O.Ts 8'-8¼"x.45" FL. IN E.R., CROSS BUNKER & No. 3 HOLD, .55" B.S., .45" FLANGED IN NO. 1 HOLD, 72"x.43" FL. ELSEWHERE
B.O.T. CONNECTIONS, 10½" GUSSET FL. 2" (ALTERNATIVELY 3½"x3½"x⅞" ANGLE, ⅞" B.S.)
B.O.T. CONNECTIONS IN PANTING AREA, 17" GUSSET FL. 2" (ALTERNATIVELY 3½"x3½"x⅞" DOUBLE ANGLE 9-⅞" RIVS.)

NOTE: BILGE-FRAME AND BOTTOM FRAME TO BE ORDERED AND TURNED ETC. IN ONE LENGTH.
BOTTOM SHELL .61" WITH 30" SPACING TO 50" AT ENDS.
RIVETS IN BOTTOM FRAMES TO SHELL & FLOORS SPACED 7" DIAS.
THREE STRAKES OF SHELL NEXT TO KEEL TO BE 10% ABOVE ℄ THICKNESS = .65" (.68" IN WAY 27" SPACING) FROM ½ L FORWARD TO COLLISION BHD.

FLOORS, ON EVERY FRAME, .36" IN HOLDS WITH STIFFS. AS SHOWN. 498 B.S.
W.T. FLOORS .49 (INCL. B.S.) WITH STIFFS. 6"x3½"x⅜" SPACED .30"
TANK TOP CENTRE STRAKE 14"x.75" TO .44, .58 B.S., .50 F.S.

TANK TOP PLATING .44" TO .40", .50" E.S., .58" B.S.
FRAMES IN TANK 3½"x3½"x⅞"
REVERSE FRAMES IN TANK 3"x3"x⅞", 4"x4"x⅞" IN B.S., 6"x6"x½" UNDER ENGINES, 3½"x3½" DOUBLE UNDER THRUST BLOCK 6"x6"x⅝" UNDER BOILER BEARERS.
BOTTOM FRAMES FROM ½ L FORWARD TO COLLISION BHD. 6"x6"x½" WITH RIVETS TO SHELL 5½ DIAS., APART. 6 DIAS IN VERTICAL FLANGE. (SEE SKETCH LOWER LEFT ON THIS DWG.)
GIRDERS (ONE EACH SIDE) 6"x3½"x⅞" B. ANGLES CONTINUOUS TOP AND BOTTOM BARS AND 6"x3½"x⅞" B. ANGLE AT EACH FLOOR WITH 3-¾" RIVETS TOP & BOTTOM.
INTERCOSTAL PLATE GIRDERS - (WHERE SHOWN ON DECK PLANS) .36 PLATE IN HOLDS, 42" IN E.S., .52" B.S. WITH VERTICALS 3"x3"x⅜", 3½"x3½"x⅞" B.S. BOTTOM CONNECTIONS 3½"x3½"x⅞", TOP CONNECTIONS 3½"x3½"x⅜", 6"x6"x½" UNDER ENGINES & THRUST, 4"x4"x½" B.S. ADDITIONAL GIRDERS UNDER ENGINES & FORWARD OF ½ L AS PER SECTION 11.

CENTRE GIRDER 43½" ABOVE KEEL X .54" TO .46", .60" B.S.
TOP BARS 3½"x3½"x⅞", 4"x4"x.50 B.S.
BOTTOM BARS 4"x4"x.50" ALL FORE AND AFT.
VERTICALS 3½"x3½"x⅞", 4"x4"x.50 B.S. 6"x6"x½" UNDER ENGINES & THRUST BLOCK, 6"x6"x⅝" UNDER BOILER BEARERS.

CEMENT CHOCKS TO BE FITTED AT UPPER EDGE OF BILGE CEILING IN ALL HOLDS EXCEPT No 1

KEEL 52"x.78" FOR ⅜ L TO .68" AT ENDS
⅞" RIVETS IN SEAMS AND FRAMES.

STERN FRAME AS PER DETAIL PLAN
STEM BAR 10"x2½" TO L.W.L.
PLATE STEM ABOVE L.W.L.
RUDDER AS PER DETAIL PLAN

to accompany Vancouver Bldg 1st Lloyds Hull No. 139 F.T.P.

WELDING NOTES

FLAT KEEL WELD BUTTS FROM INSIDE (WELD IN WAY OF C.V.K. BARS AND SEAMS ONLY). DO NOT COMPLETE WELD UNTIL C.V.K. AND GARBOARD STRAKES ARE BOLTED UP.

C.V. KEEL WILL COME RIVETED COMPLETE EXCEPT IN WAY OF BUTTS OF PLATING. SHORT BARS APPROX. 15"# 30" LONG TO BE INTRODUCED HERE AND FITTED AFTER C.V.K. IS IN PLACE AND BUTTS WELDED

BOTTOM SHELL PLATING

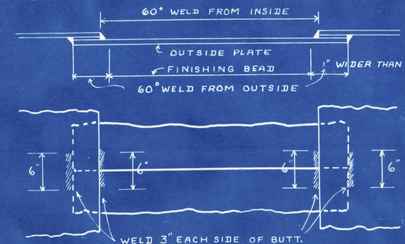

ALL BUTTS OF BOTTOM SHELL TO BE VEED OUT AND WELDED FROM THE INSIDE. THIS IS DONE TO OBTAIN DOWN HAND WELDING TO THE FULLEST EXTENT
BUTTS OF INSIDE STRAKES WILL BE VEED OUT FULL WIDTH.
THE BUTTS OF OUTSIDE STRAKES TO BE VEED INSIDE AND WELDED BETWEEN THE LANDING EDGES OF INSIDE STRAKES ONLY THIS WELD WILL BE COMPLETED BY VEEING OUTSIDE ON THE SHIP AND WELDING BOTH SEAMS. THESE TO BE VEED OUT 1" WIDER THAN LANDINGS.

SIDE SHELL AND ENDS CLEAR OF BOTT. SHELL INSIDE STRAKES TO BE VEED OUT AND WELDED FROM THE INSIDE. OUTSIDE STRAKES TO BE VEED OUT AND WELDED FROM THE OUTSIDE.

J.A STRAKE THIS IS A CLINKER STRAKE. THE BUTTS TO BE VEED AND WELDED FROM OUTSIDE, AND LOWER EDGE WHICH IS INSIDE IS TO BE FINISHED IN THE SAME MANNER AS OUTSIDE PLATES, THAT IS, VEED 1" WIDER THAN LANDING AND WELDED FROM INSIDE.
NOTE: ALL SHELL LANDINGS TOP AND BOTTOM FOR 3" EACH SIDE OF SHELL BUTTS TO BE WELDED.

TANK TOP ALL TANK TOP PLATING SEAMS AND FLOOR ANGLES TO BE RIVETED. ALL BUTTS TO BE WELDED FROM TOP SIDE. TANK TOP SEAMS TO BE WELDED FOR 3" EACH SIDE OF BUTT.
SHAFT TUNNEL PLATING TO BE FILLET WELDED TO TANK TOP SIMILAR TO BHDS. NO FOUNDATION BARS TO BE FITTED.
PLATING TO HAVE SAME PROCEDURE AS TANK TOP

MAIN AND UPPER DECK. W.T. FLOORS IN DOUBLE BOTTOM TOP AND BOTTOM ANGLES TO BE LINERED. ENDS OF BOTH BARS NEXT CENTRE KEEL TO BE CUT ½" SHORT OF TOE OF CENTRE KEEL TOP AND BOTTOM FORE AND AFT ANGLES. OUTER ENDS TO BE CUT ½" SHORT OF MARGIN PLATE. THESE BARS TO BE ELECTRIC WELDED TO FLOOR PLATE WITH HEELS PROJECTING ½" OVER EDGE OF FLOOR PLATE FOR THAT PURPOSE. NO COLLARS TO BE FITTED ON EITHER ENDS OF FLOOR PLATE. THE ENDS OF FLOOR PLATES ARE TO BE FITTED NEATLY TO BUTT AGAINST CENTRE KEEL AND TANK MARGIN FOR FILLET WELDING. PLUG WELDS ABOUT 18" APART TO BE MADE THROUGH FLOOR PLATE FLANGE OF TOP AND BOTTOM BARS TOP AND BOTTOM FLOOR ANGLES TO BE RIVETTED TO TANK TOP AND SHELL RESPECTIVELY.

TANK MARGIN PLATE FLANGED ON TOP AND LAP RIVETED TO TANK TOP PLATING. BOTTOM EDGE TO BE BUTTED ON SHELL PLATE AND FILLET WELDED INSIDE AND OUTSIDE. THE ORDINARY FLOORS AS WELL AS W.T. FLOORS WILL BE WELDED TO THIS PLATE INSIDE AND BILGE BRACKETS WELDED ON OUTSIDE. NO ANGLE CONNECTIONS WILL BE FITTED ON EITHER SIDE OF TANK MARGIN PLATE. ALL BUTTS OF TANK MARGIN PLATES WELDED FROM OUTSIDE, WITH FINISHING BEAD INSIDE TO BE ALL RIVETED EXCEPT IN WAY OF TANK TOP AND TANK MARGIN NO FOUNDATION ANGLE TO BE FITTED TO TANK TOP OR MARGIN BHD. PLATING AND STIFFENER BRACKETS BUTTED HARD ON TANK TOP AND TANK MARGIN AND FILLET WELDED. BULKHEAD SHELL BARS TO BE CARRIED DOWN BILGE AND STOPPED ½" SHORT OF MARGIN PLATE.

W/T BHDS.

BILGE BRKTS AND GUSSET PLATE RIVETED TO FRAME AND BILGE ANGLE AND WELDED TO TANK MARGIN. GUSSET PLATE WELDED TO FLANGE OF BILGE BRACKET AND WELDED TO TANK TOP.

PILLARS TO BE WELDED TO TANK TOP.

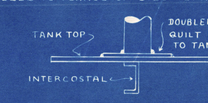

EQUIPMENT

2	- BOWER ANCHORS	- 68 CWTS.	
1	- STUD CABLE CHAIN	- 225 FATHOMS	2 5/16
1	- STREAM ANCHOR (STOCKLESS)	- 23 ¾ CWTS.	
1	- STREAM WIRE	90 FATHOMS	5" - 6x12 F.S.W.
1	- TOWLINE	120 "	4 ¾" - 6 x 24 SPECIAL F.S.W.
2	- HAWSERS	90 "	2 ¾" - 6x12 F.S.W.
2	- WARPS	90 "	2 ½" - 6x12 "

9 RIVETS ¾" TO FLOORS
8 " ⅞" " CENTRE GDR. FOR ½ L
9 " ¾" " " AT ENDS
13 " ⅞" " " 6 FLOORS IN 6"x6" ANGLES

REVISIONS	
JULY 21/41	RE DRAIN HOLES
AUG 21/41	A DETAIL SHOWING W.T. FLOORS AT C.V. KEEL HAS BEEN ADDED (SEE BELOW AT LEFT) UPPER & SECOND DK. PLATING NOW JOGGLED INSTEAD OF TAPERED LINERS.
JAN 15/42	RE DRAIN HOLES - SEE NOTE
FEB 3/42	NOTE ADDED - RE- CEMENT CHOCKS

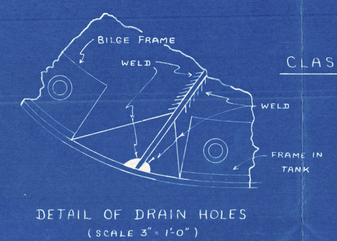

DETAIL OF DRAIN HOLES (SCALE 3" = 1'-0")

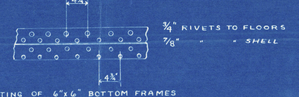

RIVETING OF 6"x6" BOTTOM FRAMES FROM ½ L FORWARD TO COLLISION BHD.

CLASS:- 100 A.1. LLOYDS, WITH FREEBOARD CORRESPONDING TO A DRAFT 18" MORE THAN THAT OF A C.S.S. VESSEL

EQUIPMENT NUMERAL

L(B+D)		39189
MIDSHIP DECKHOUSE	30.25x7.5x.50	113
CASINGS	20.5 x 7.5 x .50	77
"	59.75 x 10.5 x 50	314
AFTER DECKHOUSE	28 x 7.5 x .50	105
		39,798

: LETTER "a"

ISSUED MAR 7 1942 BURRARD DRY DOCK CO. LTD. HULL DEPARTMENT

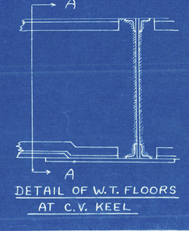

DETAIL OF W.T. FLOORS AT C.V. KEEL

WELDING FOR FLOORS WITH SINGLE TOP & BOTT. BARS.

WELDING FOR FLOORS WITH DOUBLE TOP & BOTT. BARS.

REVISIONS
APR 28/42 DRAIN HOLES REVISED.

BURRARD DRY DOCK CO. LTD.
N. VANCOUVER, B.C. No 39
ENGINEERING DEPARTMENT

MIDSHIP SECTION

VESSELS 130 - 170

DRAWN TRACED R.B.Y. CHECKED
DESIGNED BY
SCALE ½" = 1'-0"
DATE NOV. 25/41 DRAWING NO. 3057A

F.T. PINE - HULL 139