

M.V. "SOBIESKI" PROFILE & DECK PLANS.


DIMENSIONS: 485' O.P.P. 67'0" B.M.D. 36'5" D.M.D. TO D' DECK.

TO CLASS LLOYD'S * 100 A.H. WITH FREEBOARD.


SCANTLING'S SUITABLE FOR A DRAFT OF 26'9" B.M.

SCALE: 1/6" = 1'-0".


B' DECK

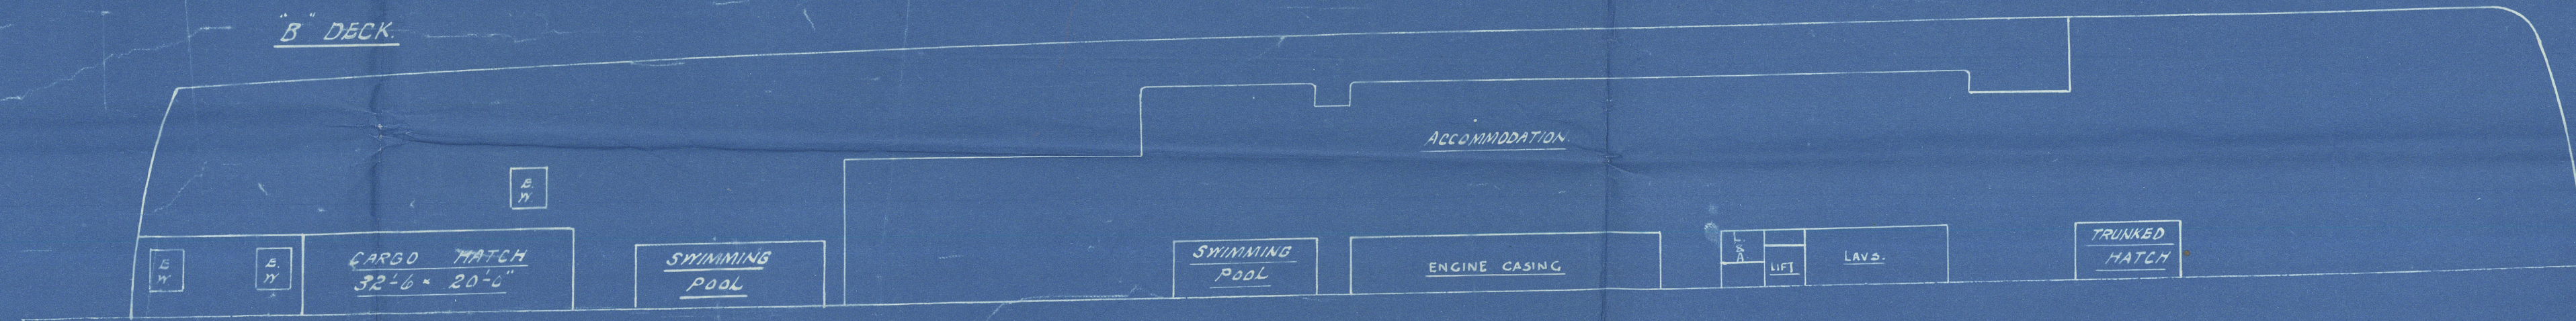


FORECASTLE DECK.

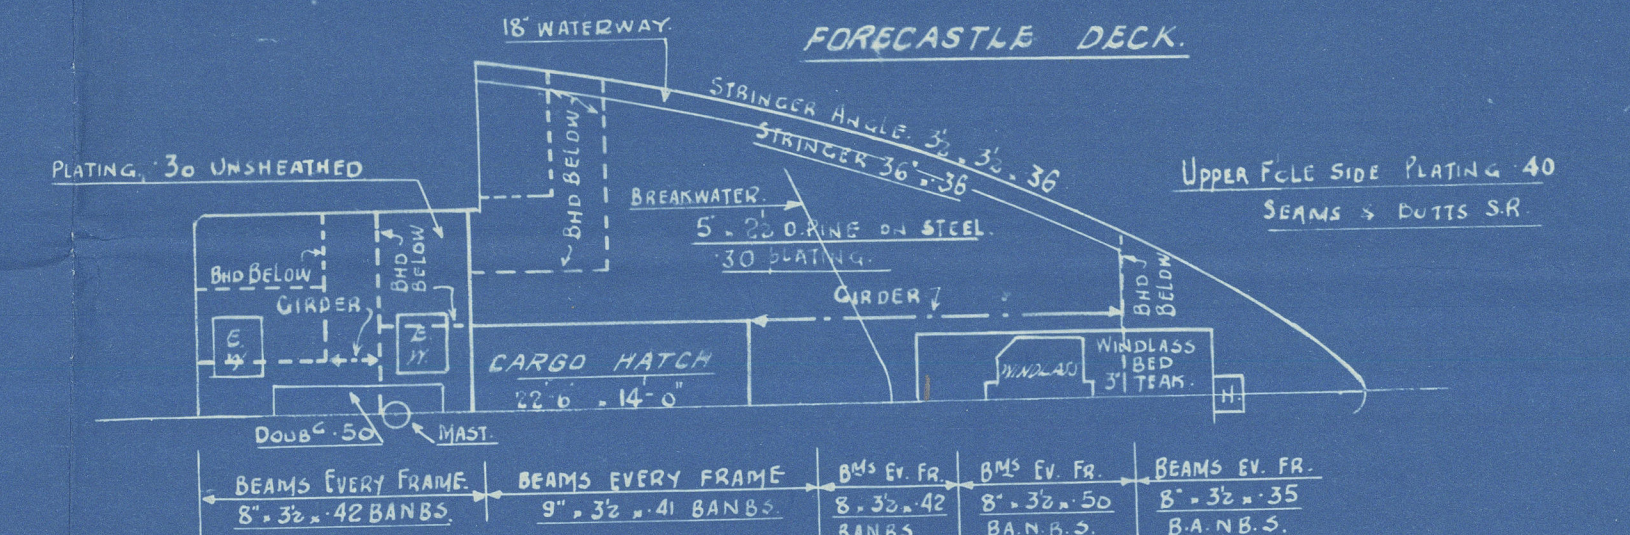


C' DECK

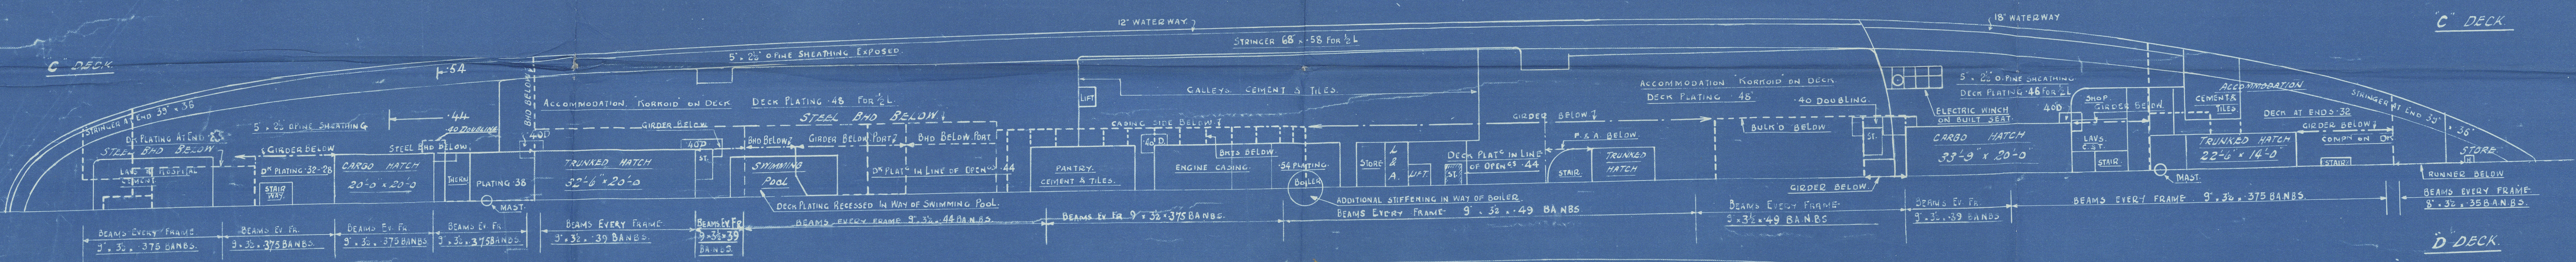


D' DECK

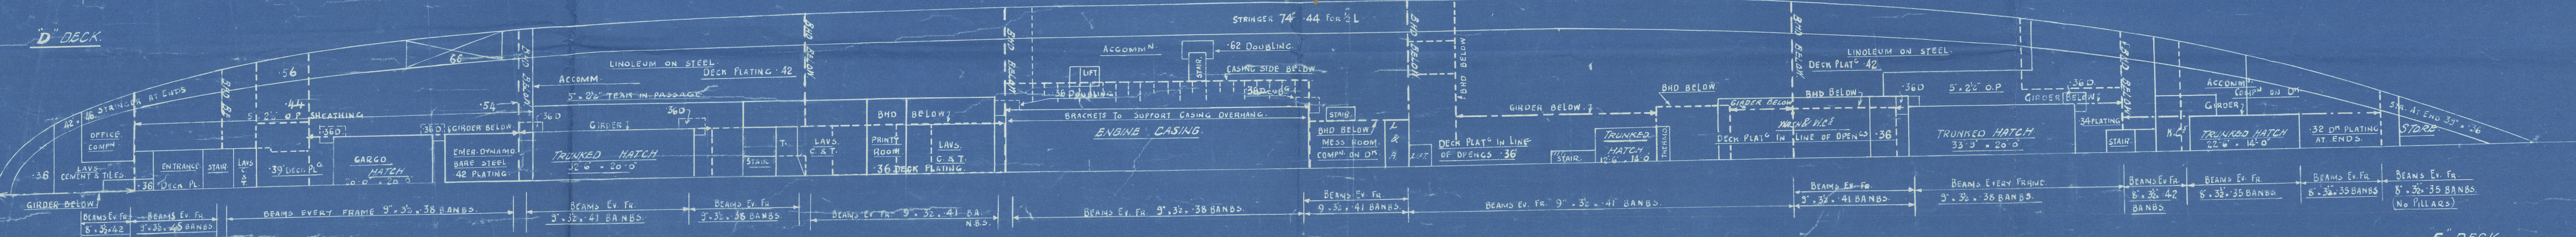

E' DECK

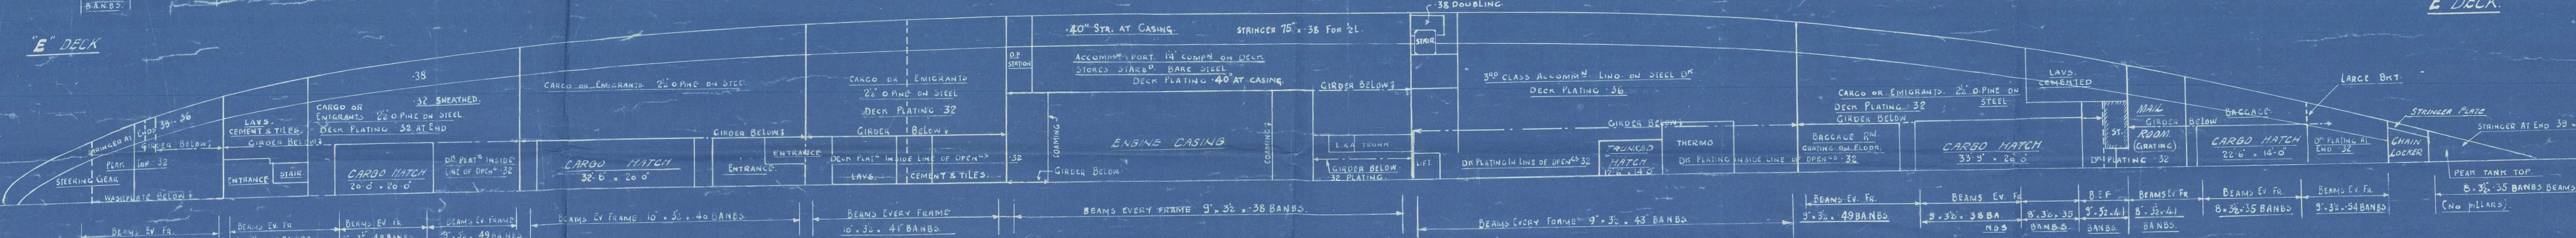

F' DECK

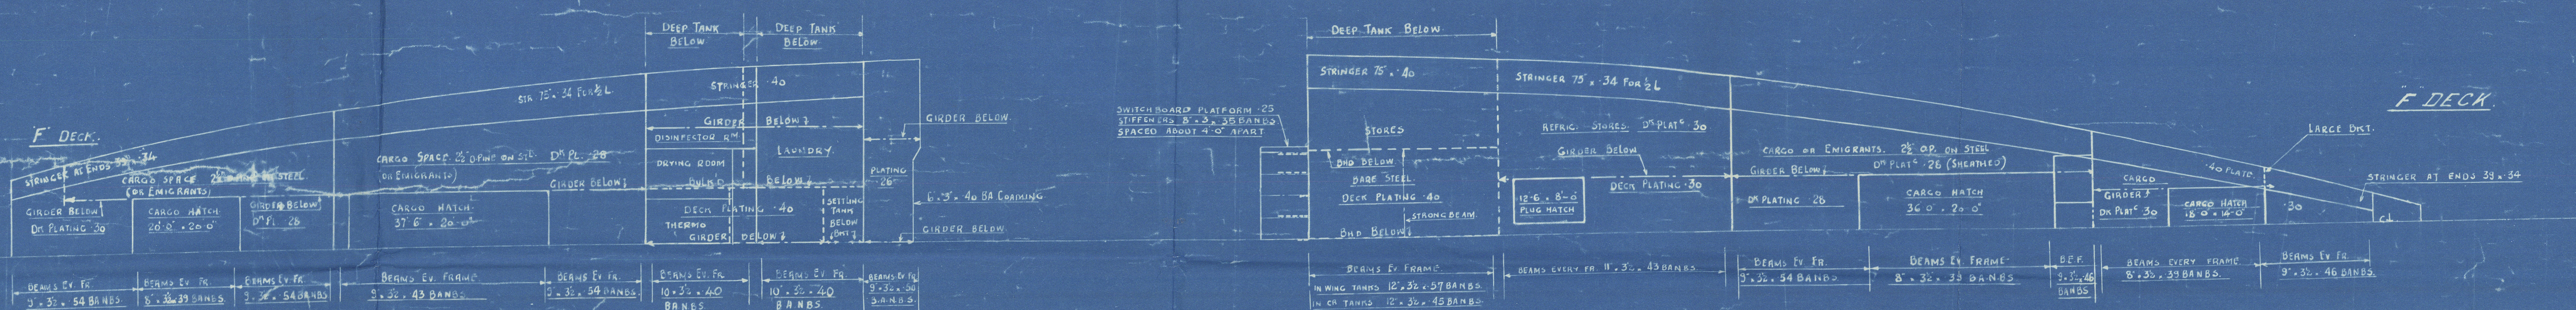

F' DECK

SHWR 1872

SOBIESKI

PROFILE + DECKS (AS FITTED)

SWAN, HUNTER, & WIGHAM
RICHARDSON LTD.

SHIP No. 1572

s.s. "Sobieski"

NEWCASTLE ON TYNE.

Report No.



© 2020

Lloyd's Register
Foundation

008446-008454-0011

SHWR 1572

"SOBIESKI"

~~MAINTENANCE SECTION~~ (AS FITTED)
PROFILE & DECKS.

© 2020

008446-008454-0011



Lloyd's People
Foundation