


No 1572. PROFILE & DECK PLANS.


DIMENSIONS: 485'0" P.P. x 67'0" B.M.L. x 36'3" D.M.L. TO 'D' DECK.
TO CLASS LLOYDS * 100 A.I. WITH FREEBOARD.
SCANTLINGS SUITABLE FOR A SUMMER DRAFT OF 26'9" BK.
SCALE 1/16" = 1'-0".

APPROX. UNDER DECK TONNAGE: 7500


B' DECK

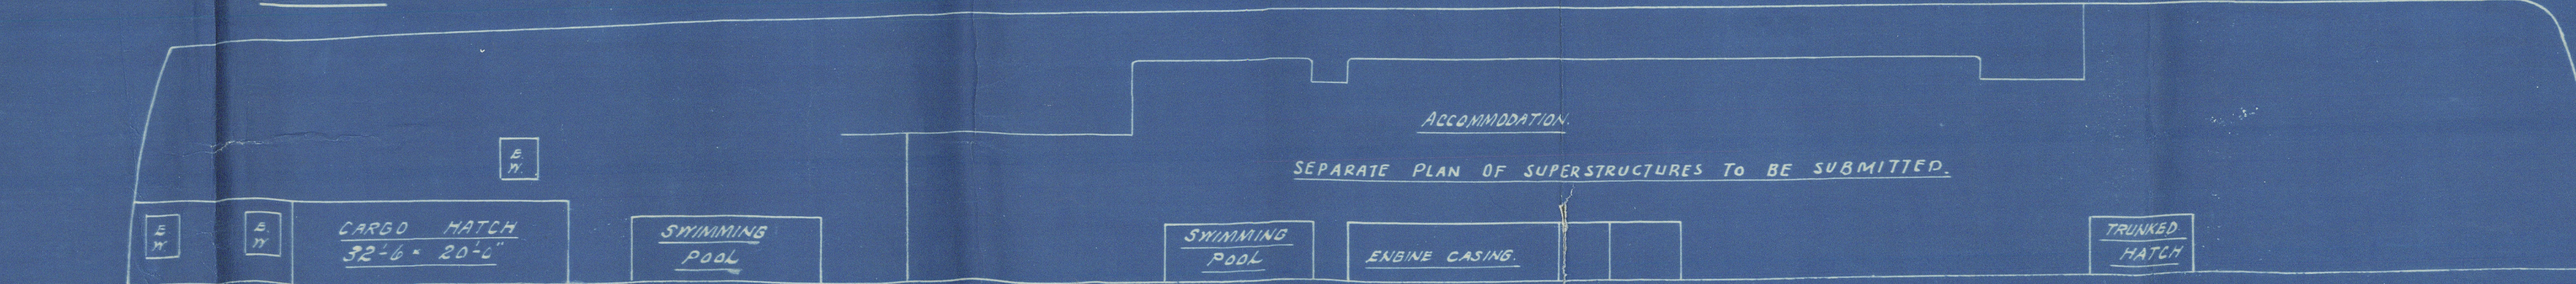


FORECASTLE DECK.

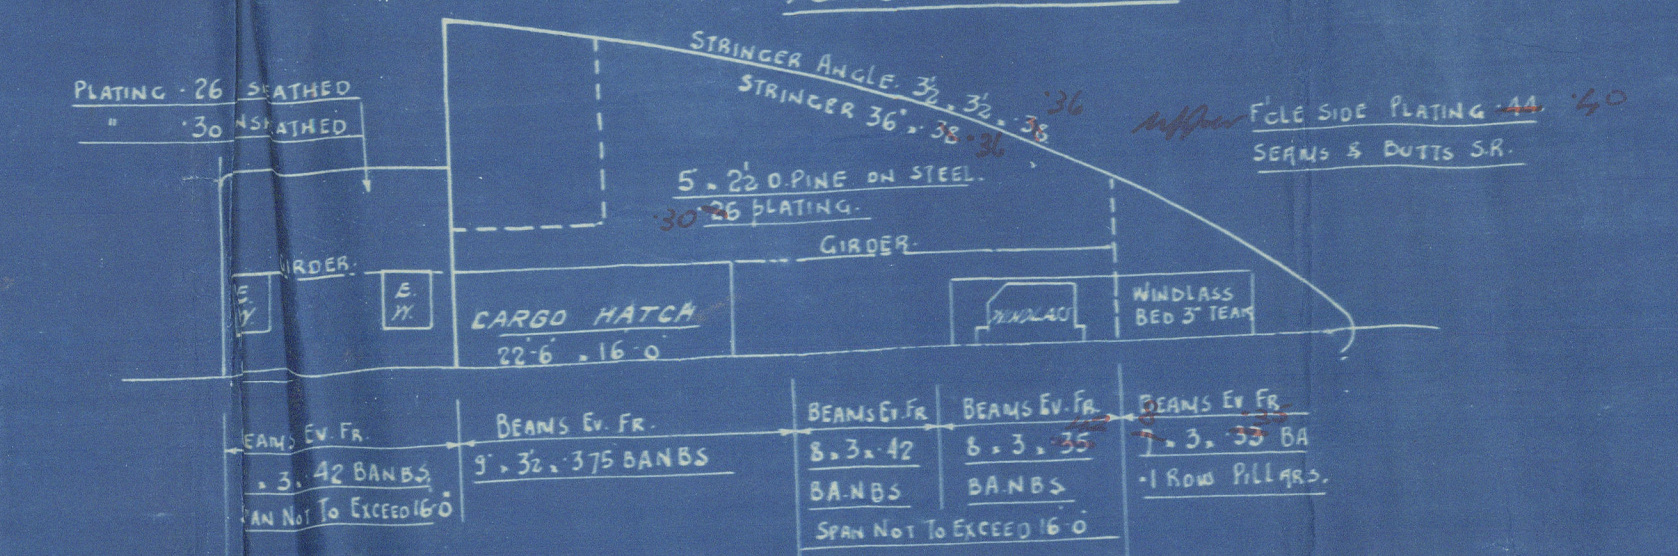


C' DECK

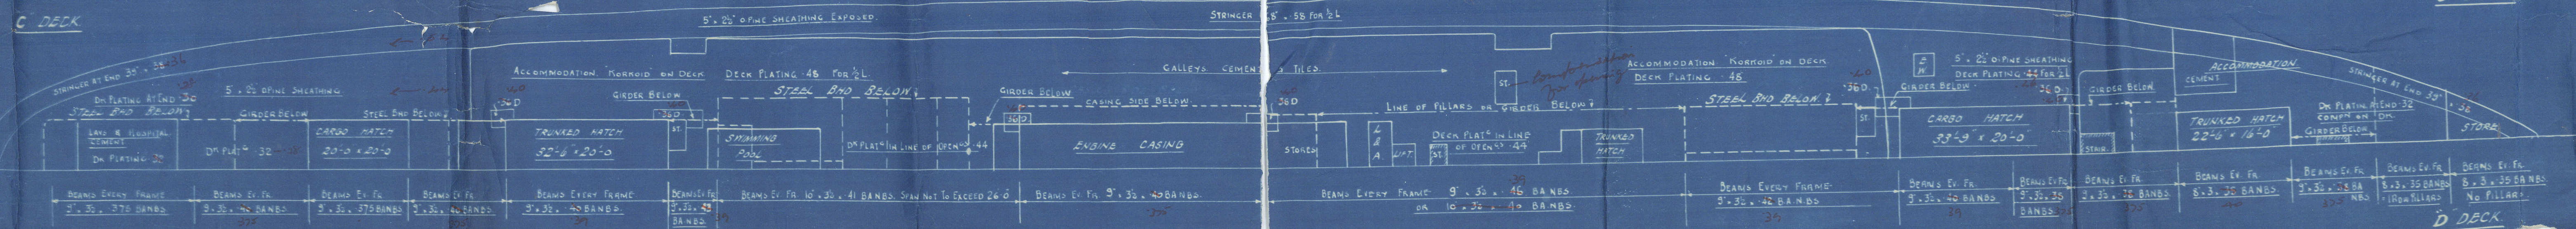


D' DECK

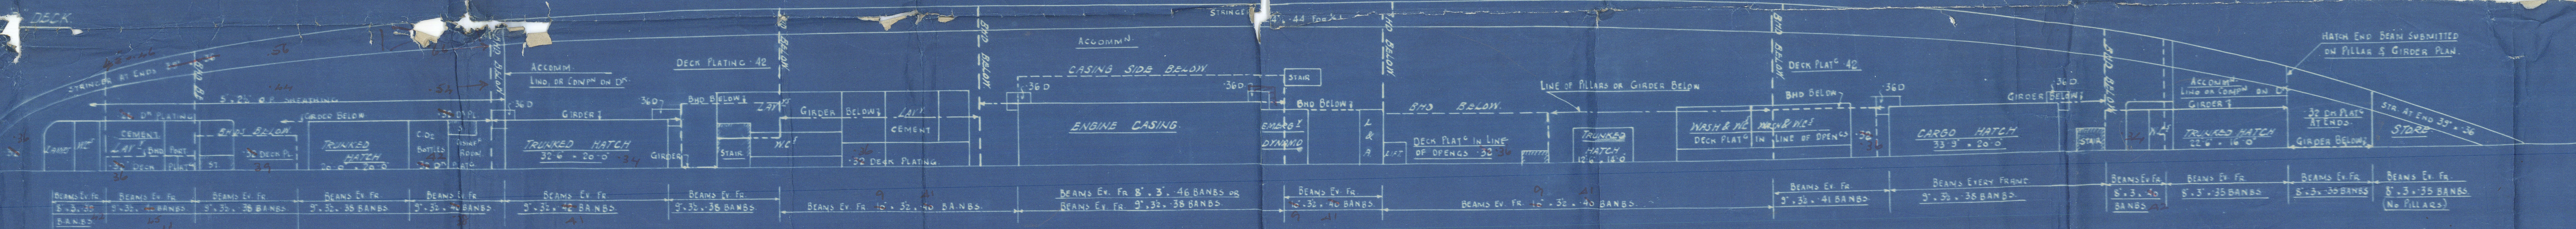

E' DECK

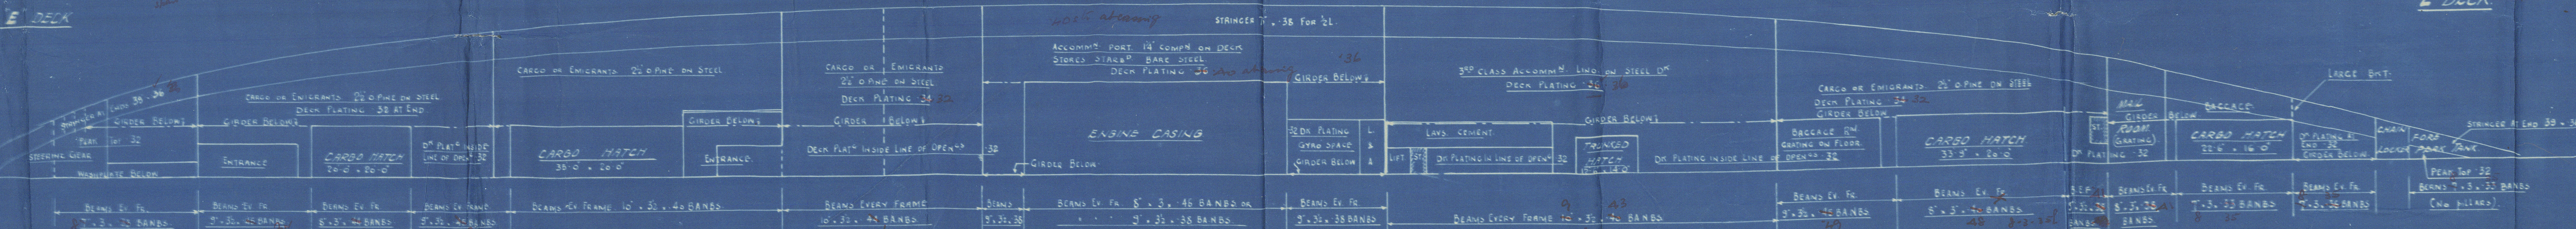

F' DECK

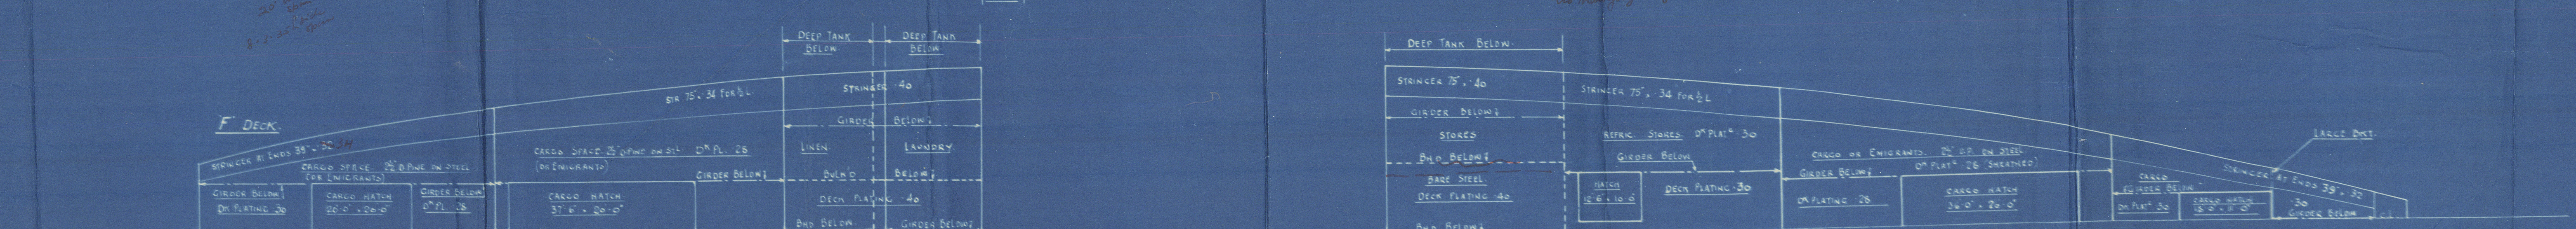

4
S. H. W. R. 15 1/2.

Profile & decks

m. v. "Solieski"

NEWCASTLE ON TYNE.

Report No. 97503.

"GRUZIA"

M/M 8446



© 2020

Lloyd's Register
Foundation

008446-008454-0015