


28/3/24.

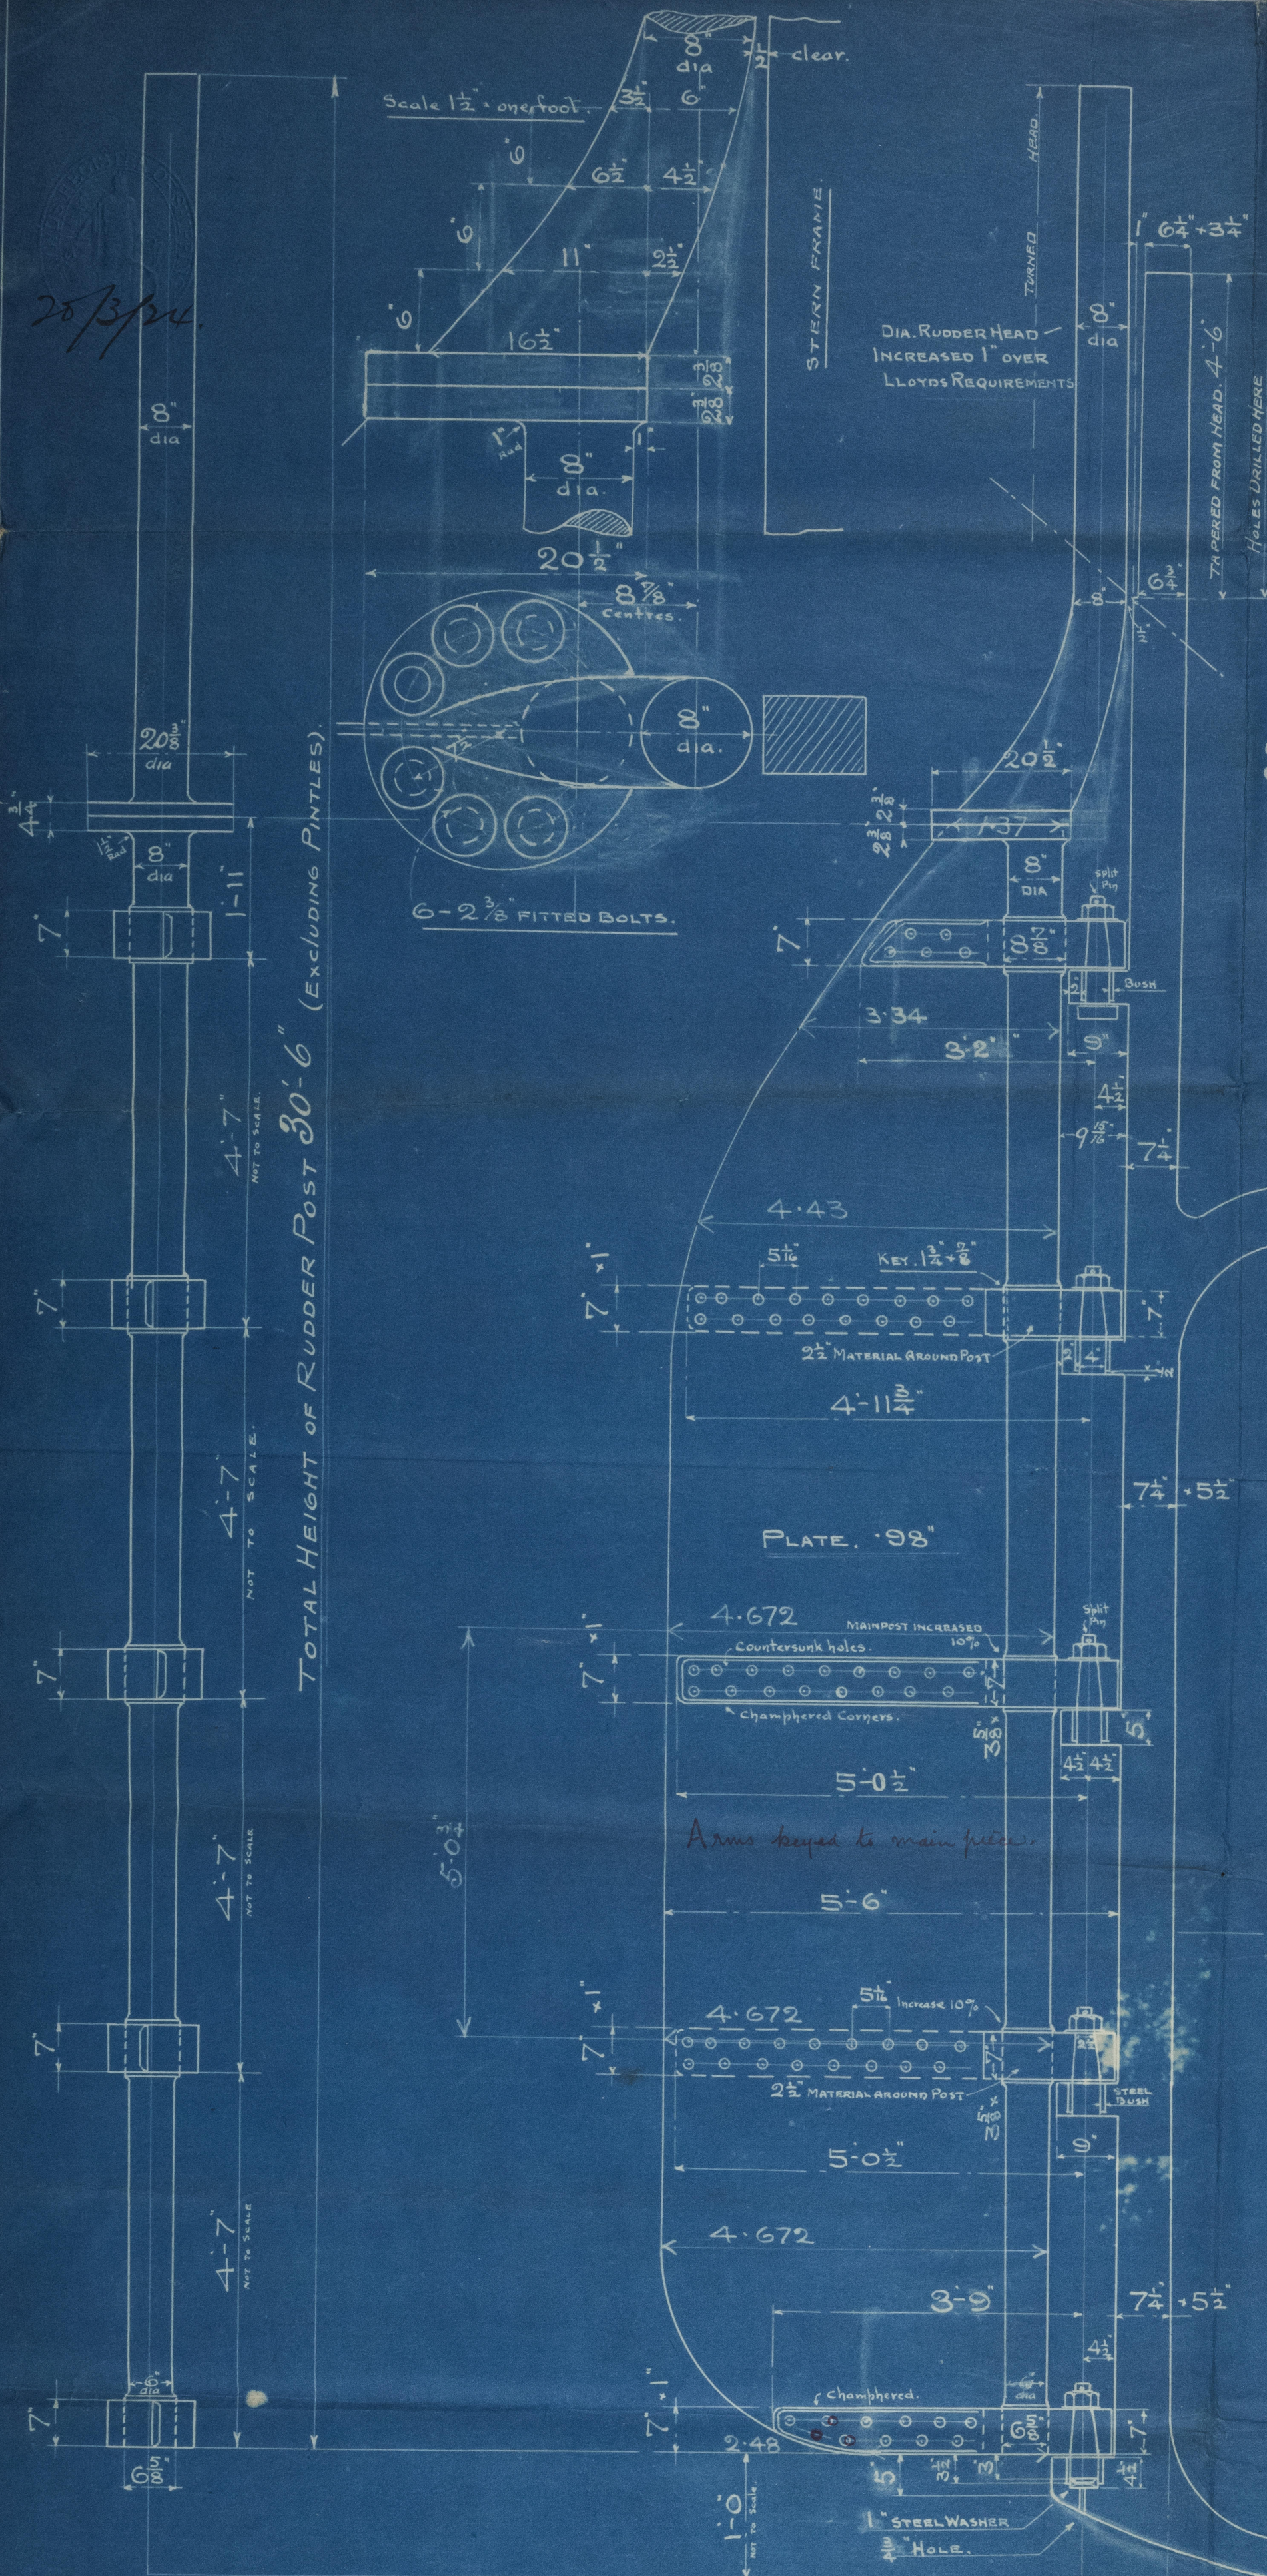

SINGLE PLATE RUDDER & STERN FRAME.

Scale $\frac{3}{4}$ " = 1 foot.


WOOD, SKINNER & CO. LTD.
NEWCASTLE-ON-TYNE
No 889 DATE 8-3-24

237 1/2.

A. = 84.87
D. = 2.634
A+D. = 223.54

SPEED UNDER 10 KNOTS.

RADIUS OF QUADRANT. 4'-4" DEPTH BOSS. 7" dia
STEERING CHAIN. 1" dia RODS. 1 1/4" dia. STEM BAR. 7 1/2" x 2 1/8"

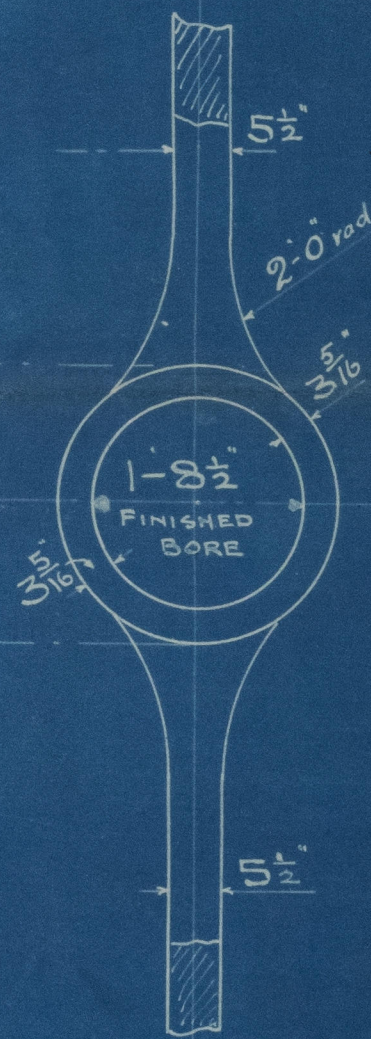

20.3.24

RUDDER. SINGLE PLATE DRILLED 1 1/8" HOLES FOR 1 1/8" RIVETS. SPACED 4 1/2" DIAS. APART. (CENTRES)
STERN FRAME " 1 1/8" dia " 1" dia " 5 " " (")



Newcastle-on-Tyne.

Wood Skinner & Co L^d

No 237.

Stern Frame & Rudder.

S. S. LISWORTH

NEWCASTLE ON TYNE.

Report No. 79635.



© 2020

Lloyd's Register
Foundation

008472-008506-0104