



31-7-19

Note:- all Scanlings not found on this Plan to be as previously approved.

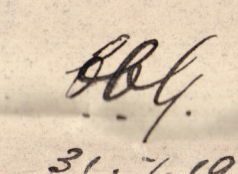

919-20.

2 Bower Anchors (Stockless)	72 $\frac{1}{2}$ Cents each
1 " " "	62 " "
1 Stream " (B. Stock)	20 $\frac{1}{2}$ " "
1 Ridge " "	9 $\frac{1}{2}$ " "
300 fms. of Steel Chain Cable	2 $\frac{1}{2}$ " "
120 " " Stream "	1 $\frac{1}{2}$ " or 5" Steel Wire
130 " " Heavy Portline	15 " or 5 $\frac{1}{2}$ " "
100 " " Wafco 8" (2 off)	
100 " " " 8"	

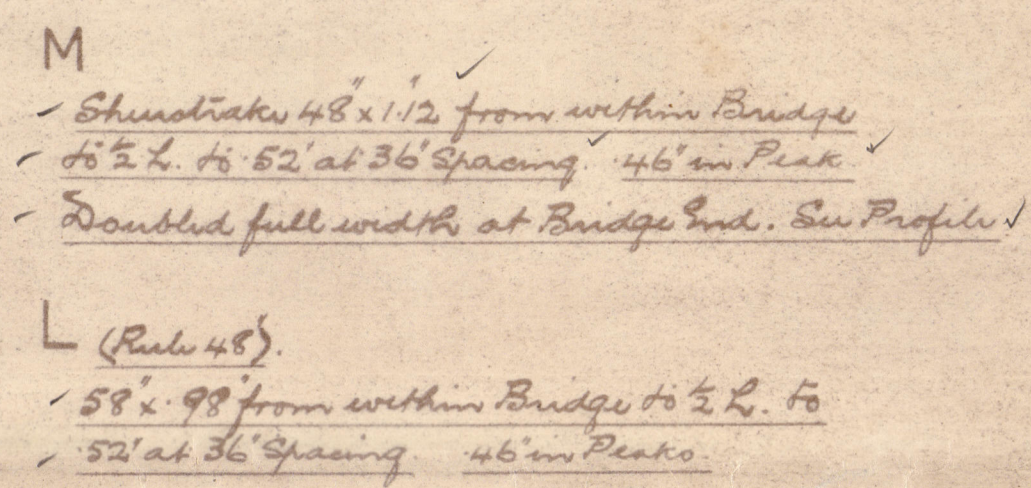

919-20.



APPROVED

(8)

PART MIDSHIP SECTION

Section through Bridge & Forele

GRAY S. 919-20

No 919
4

City of Evansville "

Hpl 16058.

No 920

8/8 "City of Singapore" Hpl. Rpt 16062.



© 2020

Lloyd's Register
Foundation

008507-008514-0139