


# PROFILE. —SCALE 1/4"=1 FOOT.—

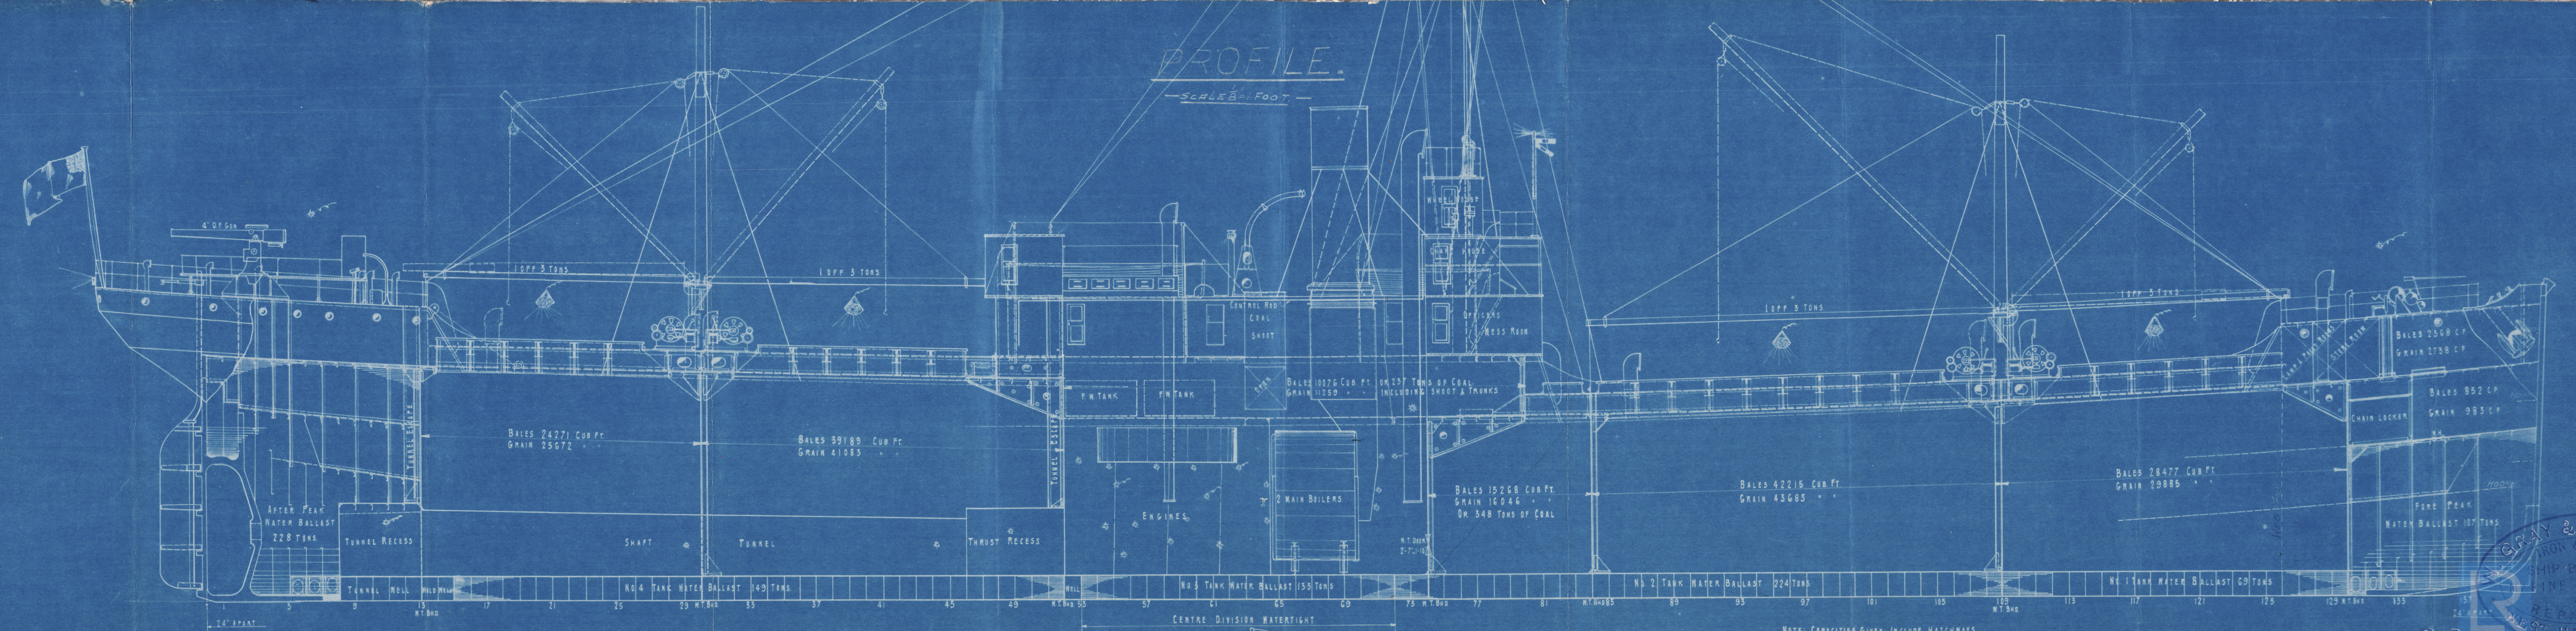

901

008524-008532-0162

GRAY & CO. LIMITED  
IRON & STEEL  
SHIP BUILDERS  
AND  
REPAIRERS  
WEST HARTLEPOOL




W. Gray & Co

S. S. N° 901

Profile given as built:

"ISED" ex  
S. S. "WAR SHELL"

Report No. 15529.

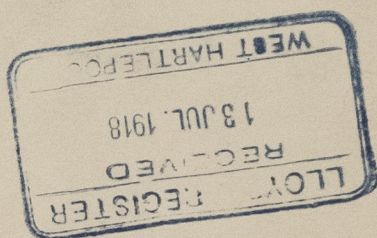

© 2020

Lloyd's Register  
Foundation

008524-008532-0162