

— S. S. N° 17 —
PROFILE AND DECK PLAN


ALTERNATIVE SECTIONS PROPOSED

NOTE = VERTICAL STIFFENERS BELOW WT. FLAT 840 86
6" x 3" x 38 BA
BRIDGE FRONT STIFFENERS 6" x 3" x 42 BA
FORECASTLE DECK BEAMS 43-45 6" x 3" x 38 BA.

Mess^{rs} DUBLIN SHIPBUILDERS LTD

Nº 17

PROFILE & DECK PLANS,

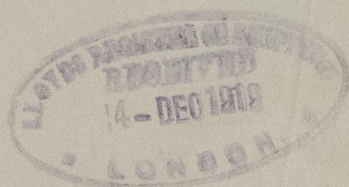

^a Holm dale
s/s " Kylebeg ^{Ex} "

Sub 4156.

D.B. 84 T



© 2020

Lloyd's Register
Foundation

008628-008633-0226