



10.2.20.

Nº 163
PROFILE AND DECK PLAN
SCALE 1/4" = ONE FOOT

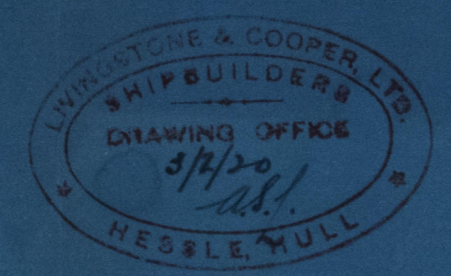


DIMENSIONS :- 102'-6" B.P. x 18'-7" MLD. x 10'-3" MLD.

CLASS 100 A.I. AT LLOYDS (STEEL)
see letter.

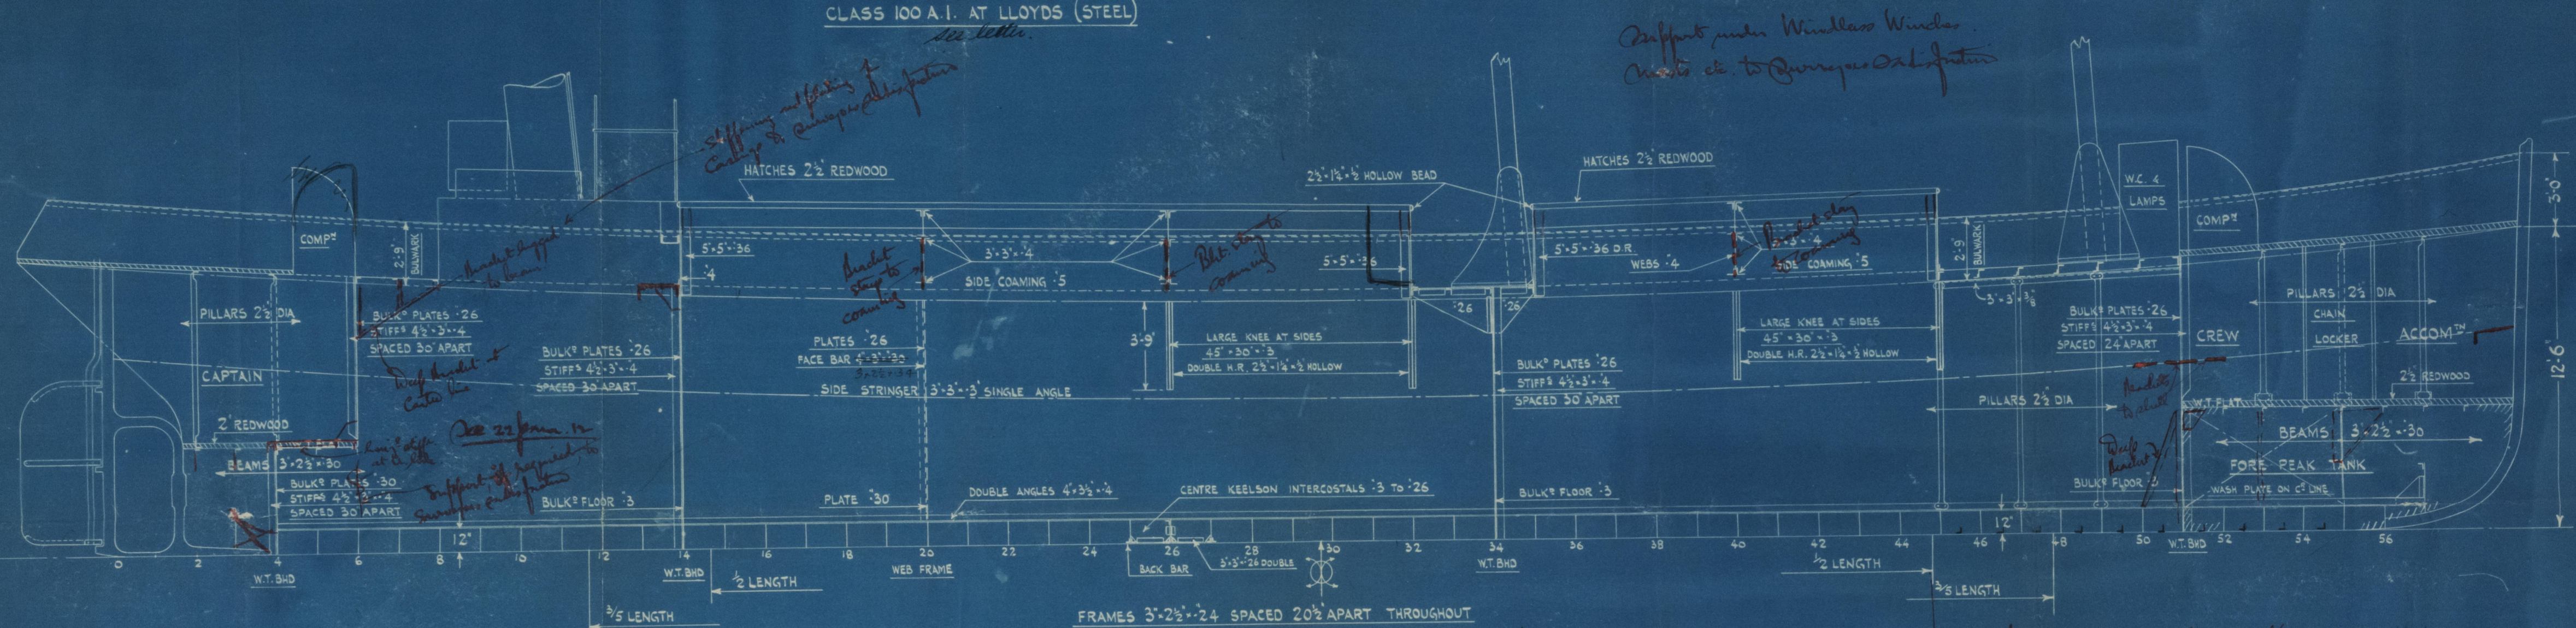

*Support main Windlass Winder
Chains etc. to Quayside or other*

*Trusses on bottom fore of 1st. doubled on
intermediate frames where no superstructure between the
Keels and extending from trans of bilge to trans of bilge
for equivalent strengthening (see Sec. 17 of Rules.)*

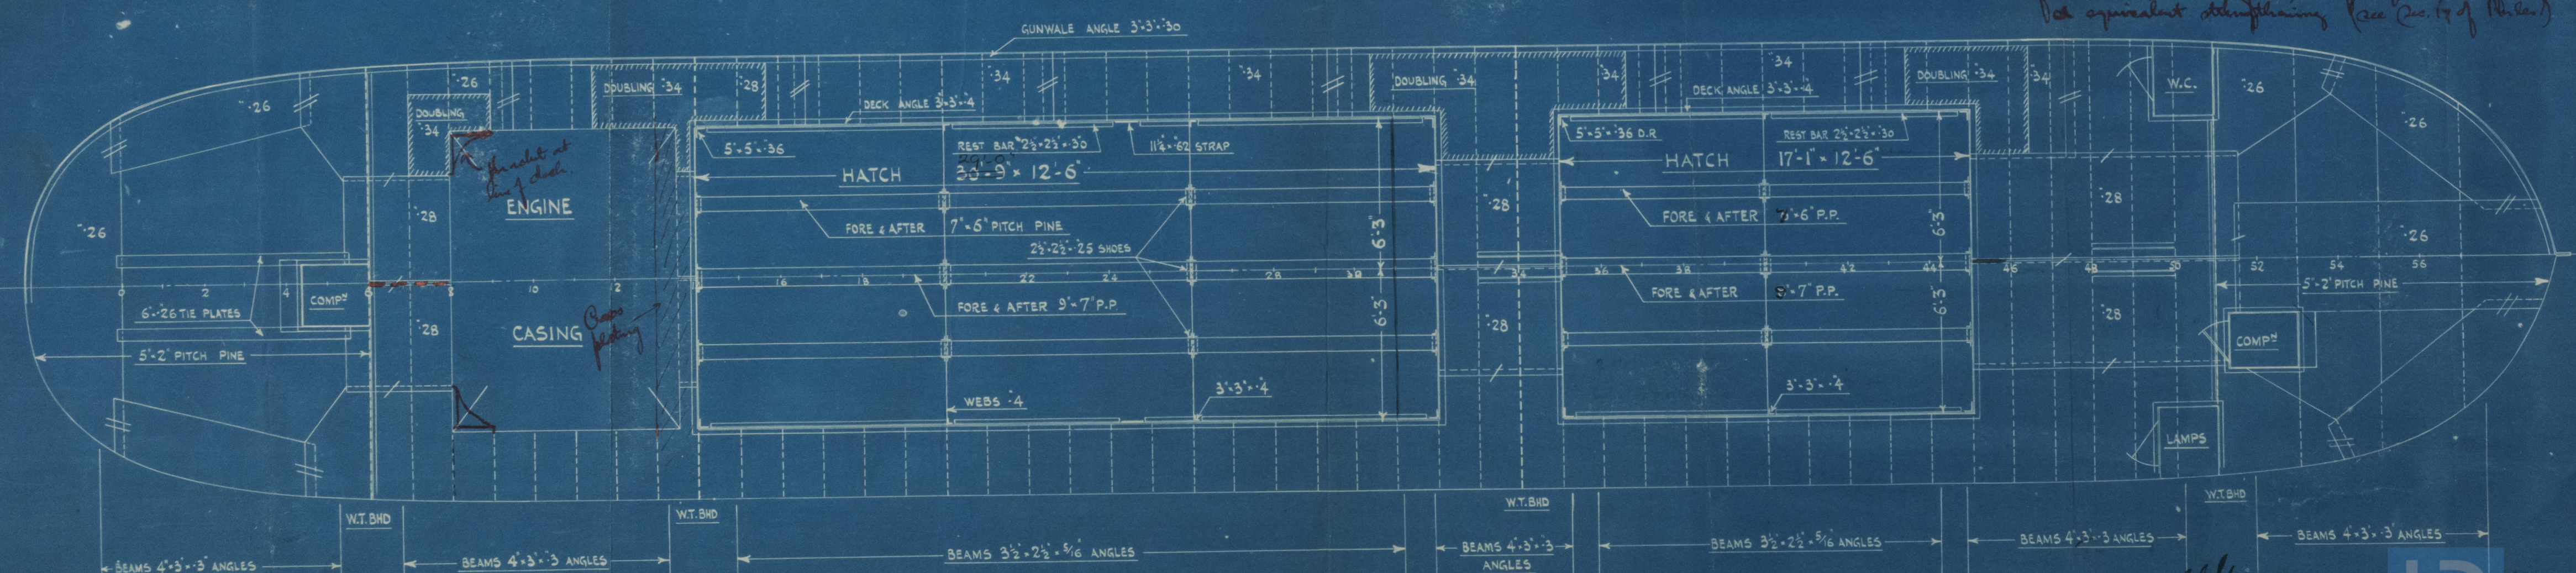

10.2.20.



Livingstone & Coopers
No 163.

Amended plan of
Profile + deck.

^{S/S}
Hull Rph No 32393 (2nd)

S.S. "Stratum"

Hull report No 32463.



© 2021

Lloyd's Register
Foundation