
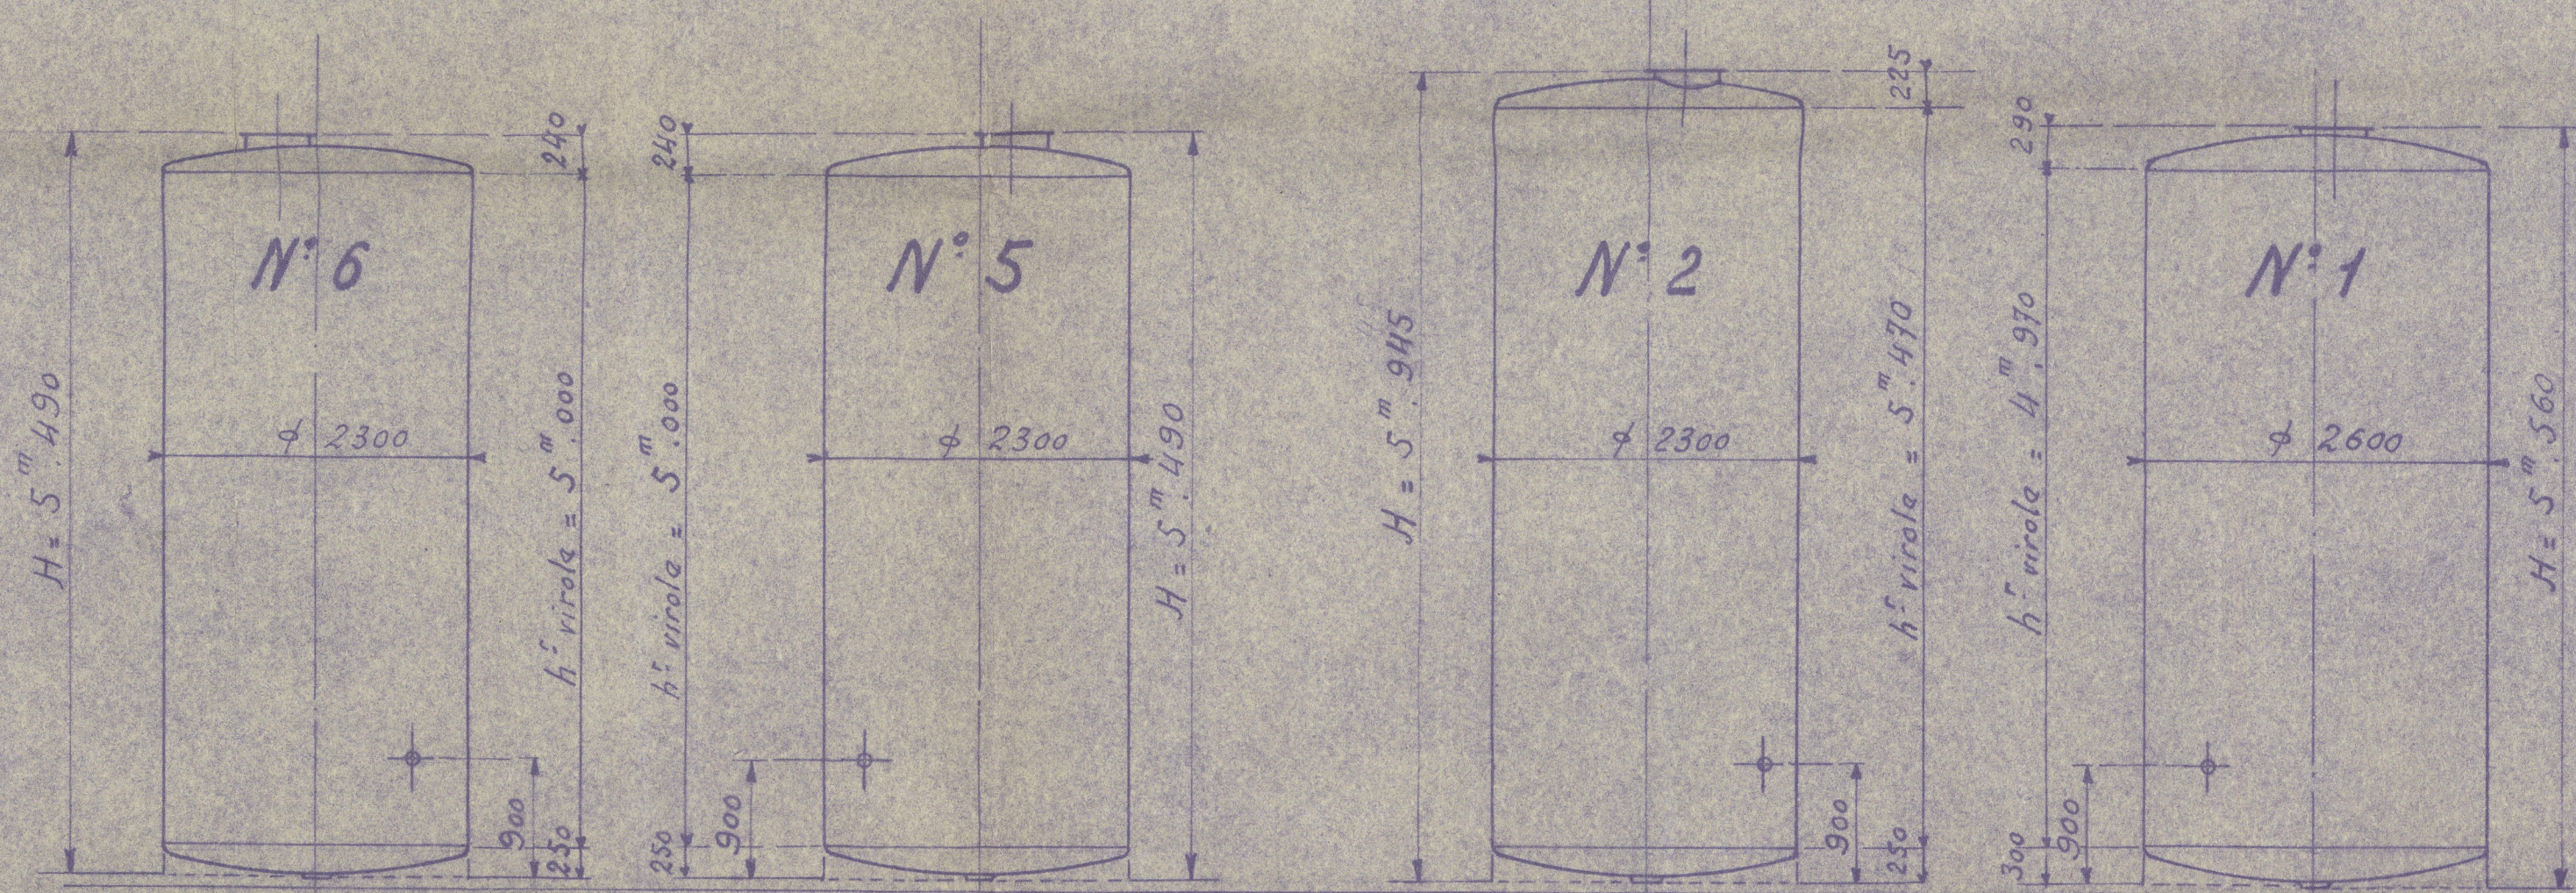


Orientation des cuves N° 1.2.5.6.10.11.12.15.16.

Cuves en tôle de 5^m/m partout

(Plating joint electrically welded)


Echelle 1/50

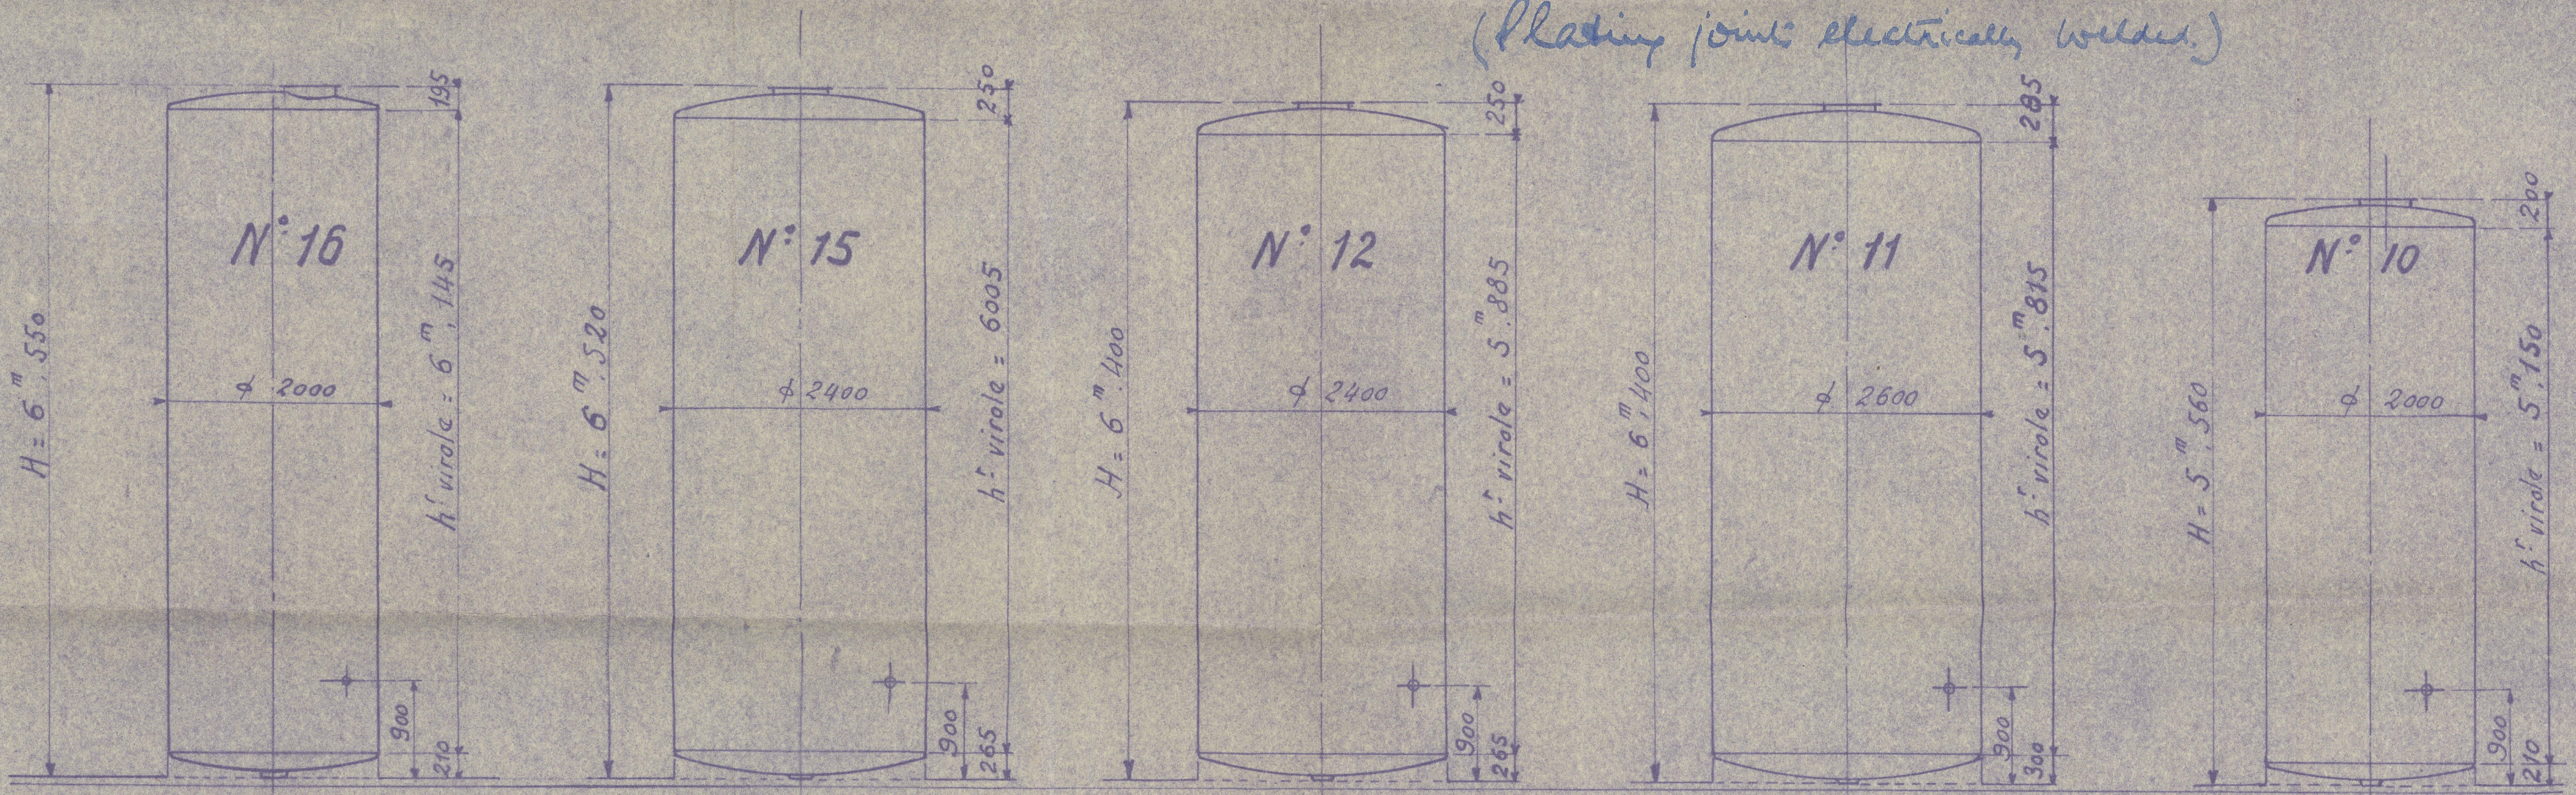


Tanks to be tested to maximum pressure which can be experienced.

Storage to Surveyor's satisfaction

NOTATION: Carrying wine in Portable Tanks.

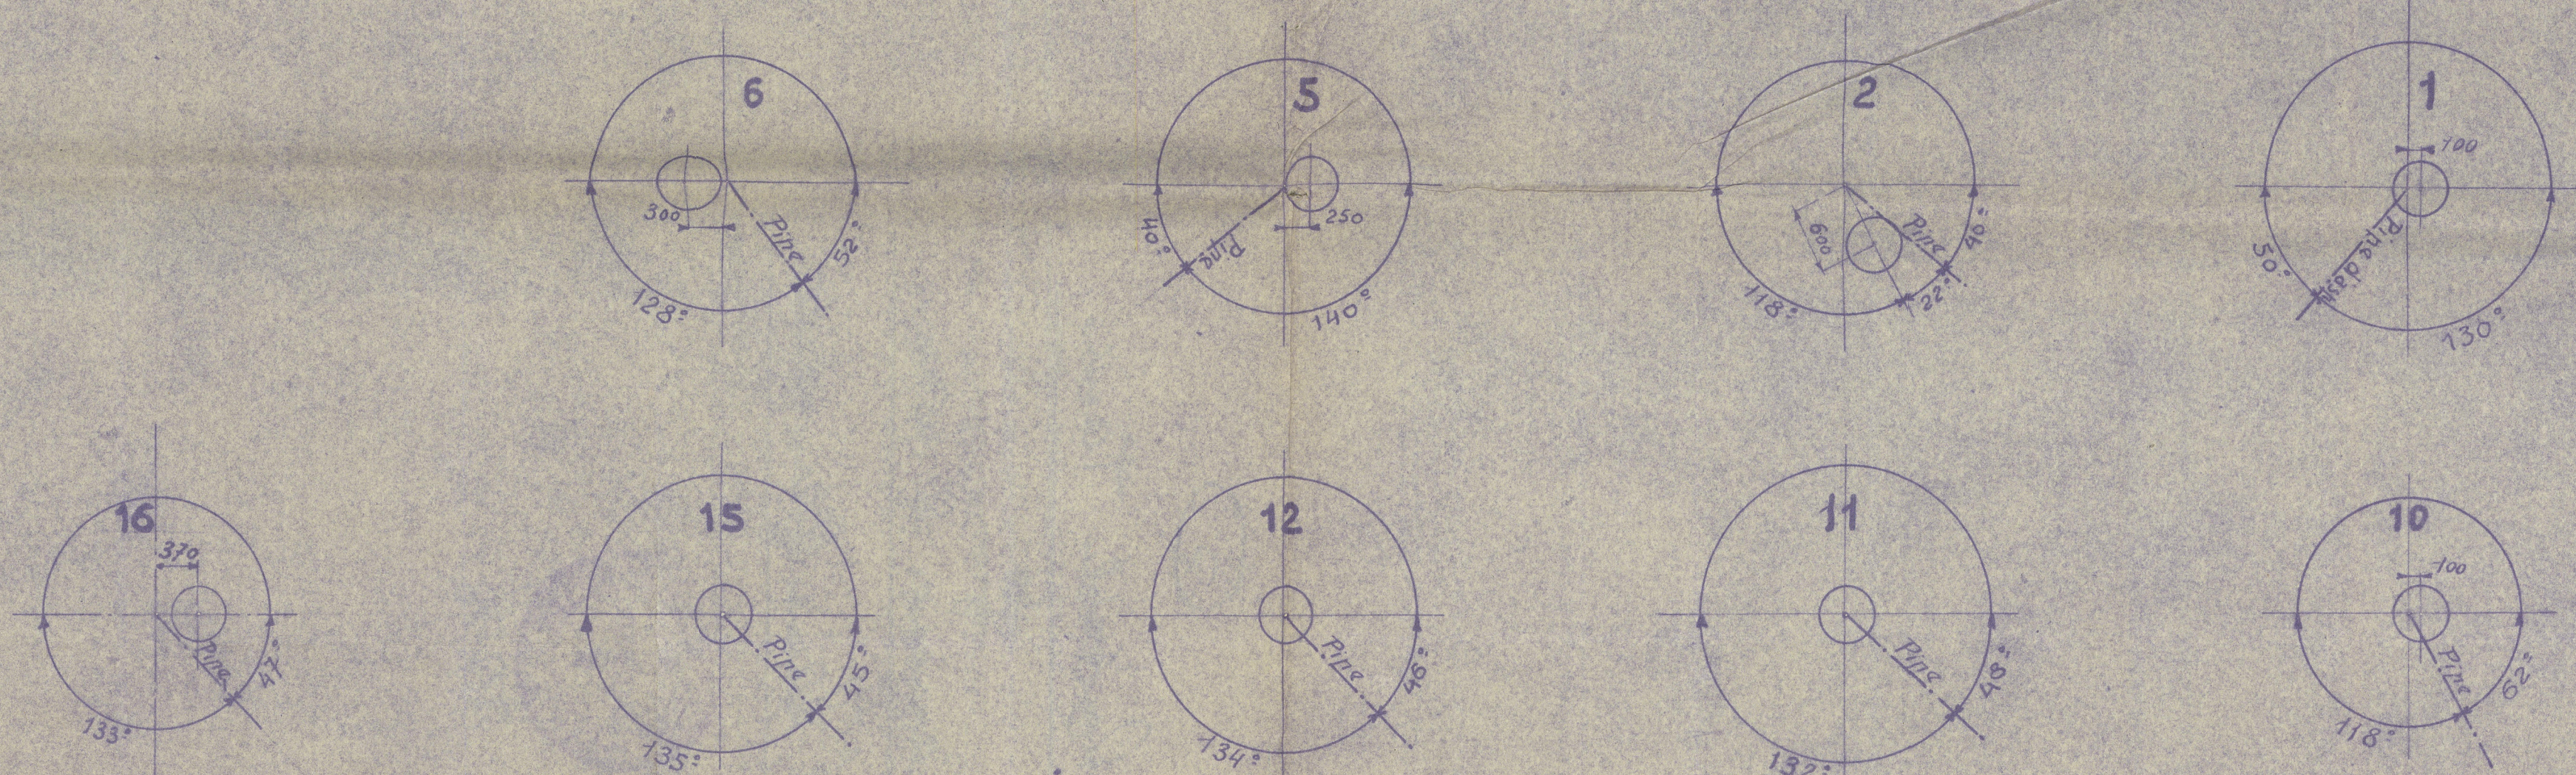

Axe de symétrie

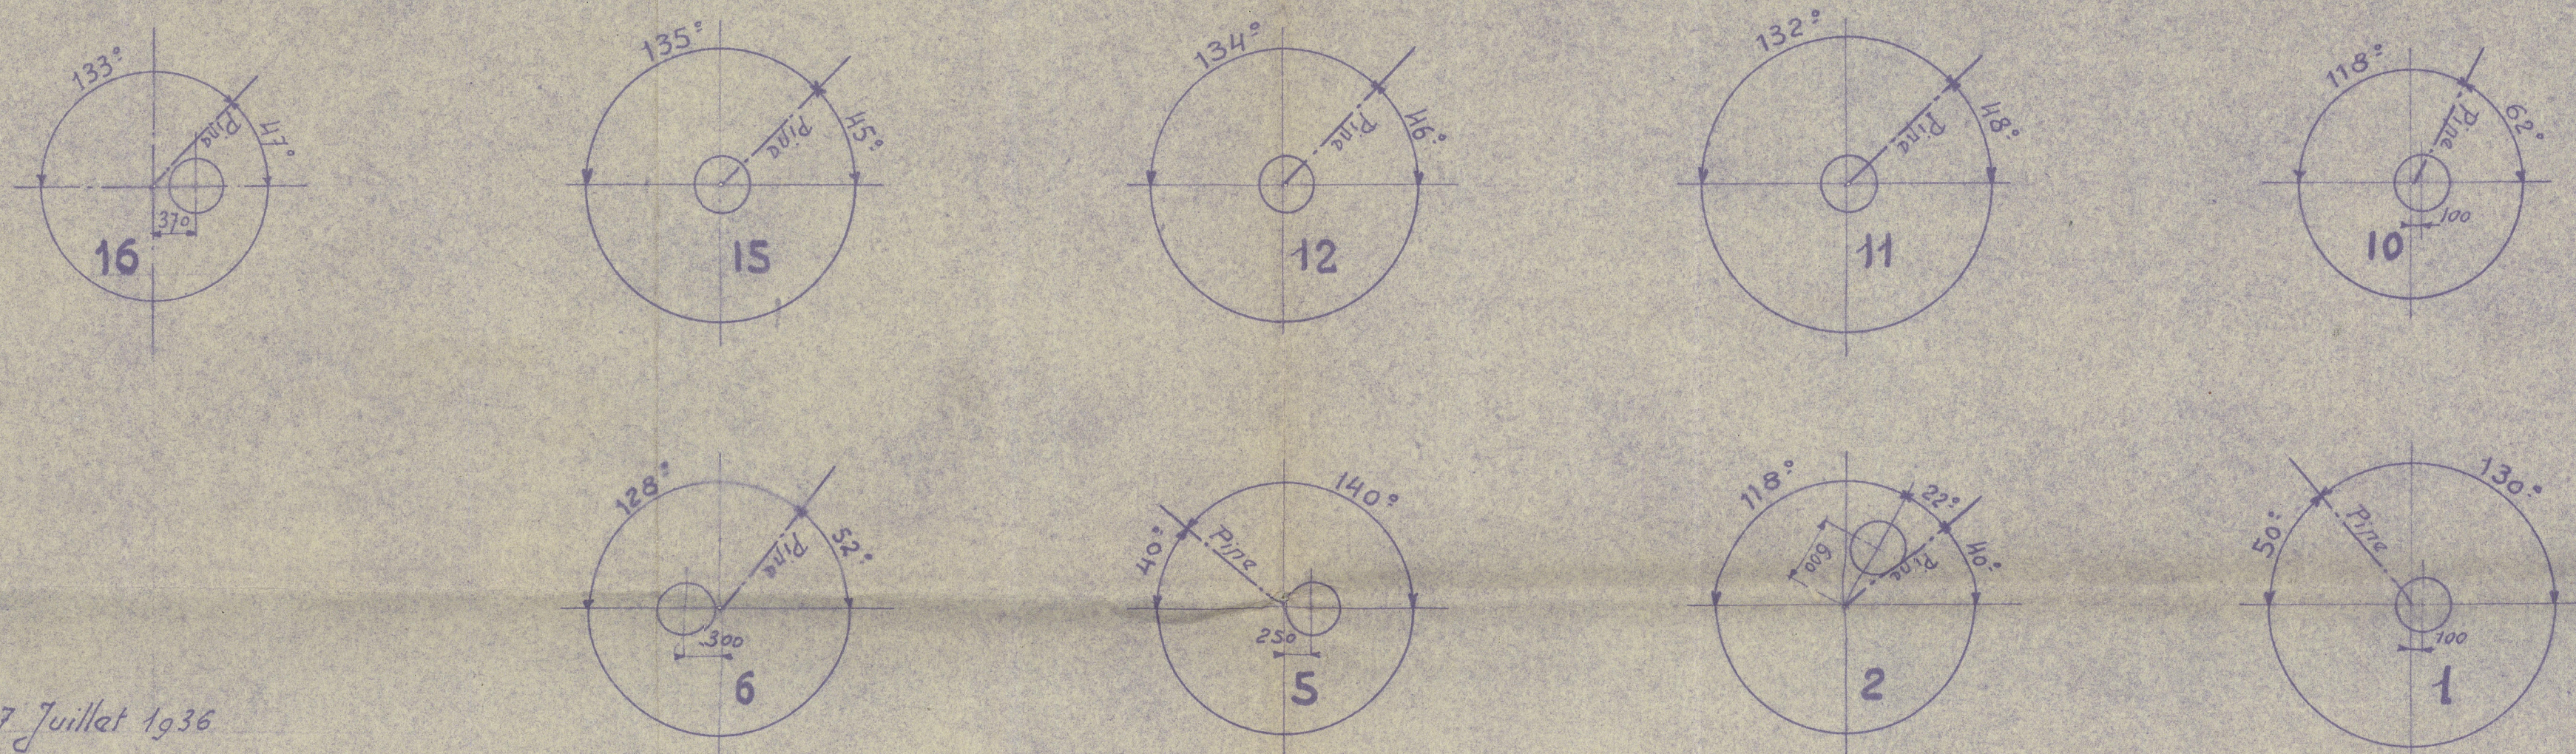

Marseille le 7 Juillet 1936

Complété le 15 Juillet 1936.

(2)

Portable Tank


for

Carriage of Wine.

St. Saint Bernadette.



17.7.36.

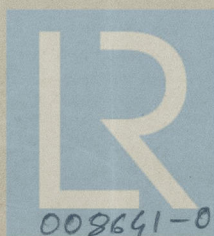

© 2021

Lloyd's Register
Foundation

008641-008697-0166