

Lloyd's Register of Shipping

SURVEYS FOR FREEBOARD.—STEAM SHIPS.

Index No. 31249
(For London Office only)

28 APR 1928 93624

PARTICULARS RELATING TO ALL STEAM SHIPS EITHER FLUSH DECKED, OR WITH TOP GALLANT FORECASTLES, SHORT POOPS AND BRIDGE HOUSES DISCONNECTED, OR WITH TOP GALLANT FORECASTLES HAVING LONG POOPS, OR RAISED QUARTER DECKS CONNECTED WITH BRIDGE HOUSES, OR OTHERWISE.

Port of Survey Birkenhead
Date of Survey 14-16 April 1928.
Name of Surveyor Geo. L. Ryle.

Ship's Name.	Port of Registry and Nationality.	Official Number.	Gross Tonnage.	Date of Build.	Particulars of Classification.
"LOUIE ROSE"	British	147265	1596.	1924-7	100% Contemplation
Number in Register Book					
Registered dimensions from Ship's Register.	Length. 250.5 Breadth. 37.1 Depth. 16.45	Under Deck Tonnage. 1243.48			
Length on LOADLINE.	Frame Depth 7 1/2" Ceiling 4.20 Rule 5" Sheer 4.78	Peak 2' N.H. Tanks 3 tons			
CORRECTED DIMENSIONS.	Length. 250.0 Breadth. 36.68 Depth. 17.40	Under Deck Tonnage. 1246.48			
Co-efficient of fineness.....	.48				
Any modification necessary [Para. 4 (a) to (e)]*	C.D. 0				
Co-efficient as corrected76				
Sheer { Stem 80.57 at Sternpost 149.0 } 129.6 ÷ 2 = 64.78 Mean 28		36728.18			
Sheer at 1/8 of the length from { Stem 116.01 at Sternpost 228.57 } 69.6 ÷ 2 = 34.75 Mean 58 - 63.18					
Gradual mean Sheer	63.18				
Standard mean Sheer [Table, Para. 18]	35.00	Correction			
Difference.....	28.18 ÷ 4 = 7.04				
§ If limited as Para. 18 (f)	-7"				
R.O.D.					
Rise in Sheer { At front of bridge house from amidships [Para. 18 (e)] At after end of forecastle }	5 1/2 "				
Fall in Sheer { Para. 18 (d) } ✓ ÷ 2 =					
Length uncovered	Correction				
ALLOWANCE FOR DECK ERECTIONS :—					
Freeboard, Table C.....	1-0 1/2 "				
Correction for Length, if required (Para. 12, 13, and 14)	-				
Freeboard by Table A. corrected for sheer, and for length, if required (Para. 12, 13, and 14)	2 .. 10				
Difference	1 .. 9 1/2				
Percentage as below.....	57.4%				
Bridge House on R.Q.D. at fore end 12.6 long	-12.34				
Correction for R.Q.D. if engine and boiler openings not covered by bridge house (Para. 11)	1-85				
Allowance for Deck Erections	11.49				
Length. 23.29	Length allowed. 28.29	Height. 7'0			
Bridge House on R.Q.D. 12.66	-	7'0			
† Raised Qr. Dk. 155.79	155.79	4'0			
Poop.....	179.08	= .716			
Total	250.0				
Length of Ship					
Corresponding percentage { (Para. 11, 12, 13, or 14) } 57.4%					
FREEBOARD recommended amidships from centre of Disc to top of Statutory Deck Line, Wood (Steel) Deck :					
Fresh Water Line	above centre of Disc	
Indian Summer Line	" " "	
Winter Line	below "	
Winter North Atlantic Line	" "	

* If the frames, skin planking, or ceiling are of unusual thickness the breadth of vessel to inside of ceiling should be reported if possible.
† In vessels obtaining an allowance for deck erections under Para. 11 where the sheer drops abeam amidships the height of the R.Q.D. is to be taken from the level of the top of the amidship beam.
‡ In flush-decked vessels the total standard mean sheer means the sheer measured at the stem and stern-post. In vessels having poops and forecastles, it means the sheer measured at points distant one-eighth of the vessel's length from stem and stern-post.

Do all the Frames extend to the top height in the Poop? ✓ Raised Quarter Deck? Yes. ✓ Bridge House? Yes. ✓ Forecastle? Yes.
 To what height do the Reverse Frames extend? ✓
 Has the Poop or Raised Quarter Deck an efficient Iron Bulkhead at the fore end? Yes.
 Give particulars of the means for closing the openings in Bulkhead
 Is the Poop or Raised Quarter Deck connected with the Bridge House? *Bridge house* ✓ R. 3. 52. Has the Bridge House an efficient Bulkhead at the fore end? *on R.A.D.* Yes.
 Give particulars of the means for closing the openings in Bulkhead
 What is the thickness of the Bridge Front plating? .34 and Coaming plate? .34.
 Give scantlings and spacing of the Stiffeners 5' x 3' x .38 about 30°
 Are bracket plates fitted at each end of the Stiffeners? Yes. ✓ Are hor'l. brackets fitted connecting Bridge Bulk'd. with Bulwarks? *Yes*
 Has the Bridge House an efficient Iron Bulkhead at the after end? Yes.
 How are the openings closed? *Shut down.*
 Is the Forecastle at least as high as the main or top-gallant rail? Yes. ✓ Has the Forecastle an efficient Iron or Wood Bulk'd. at after end? *Partial, see List.*
 Are the Engine and Boiler openings covered by a Bridge, Poop, Raised Quarter Deck, & enclosed by a Strong Iron or Steel Deckhouse? Yes.
 If the openings are not so protected are the exposed parts of the Casings efficiently constructed?
 Give thickness of plating; scantlings and spacing of Stiffeners .35/.38. 5' x .38.
 What is the height of the exposed Casings? 7'0" Are suitable means provided for closing all openings in them in bad weather? Yes.
 Are the Weather Deck Hatchways efficiently constructed and at least equal to the requirements of Section 28 of the Rules for 1904-5? Give particulars below:— *No appearance.*

Position and Size.		(1) 27'9" x 25'0" x 19'0"	(2) 27'6" x 25'0"	(3) 28'1" x 24'11"	(4) 28'2" x 24'11"			
Item.	Ship.	Rule.	Ship.	Rule.	Ship.	Rule.	Ship.	Rule.
COAMING: Height above top of DECK	36"		36"		33"		33"	
Thickness { Sides... Ends...	.44 .44 .44		.44 .44 .44		.44 .44 .44		.44 .44 .44	
SHIFTING BEAMS OR WEB PLATES. Number { Section and Scantlings... Material	5. <i>5' x 3' x 42</i> <i>18 1/2 x 26 1/2 x 12 1/2 in.</i>		5' <i>6' x 3' x 46</i> <i>19 1/2 x 38 1/2 x 13 1/2 in.</i>		5' <i>6' x 3' x 46</i> <i>19 1/2 x 38 1/2 x 13 1/2 in.</i>		5' <i>6' x 3' x 46</i> <i>19 1/2 x 38 1/2 x 13 1/2 in.</i>	
* FORE AND AFTERS. Number { Section and Scantlings... Material	—		—		—		—	
HATCHES Thickness	3		3		3		3	
Remarks								

* The depth of Fore and Afters should be stated from the underside of the hatches in all cases.

(If the sill of the lowest side scuttle will be less than 6 inches above the Indian Summer Load Line if assigned under the tables, state vertical distance from top of deck at side amidships to lower edge of lowest side scuttle.)

The following information is to be given in all Cases of vessels dealt with under Paras. 11, 12 (under 15 feet Moulded depth) and under Shelter Deck Rules.

What is the thickness of the Bridge Sheerstrake? ✓ Strake between Main and Bridge Sheerstrakes? ✓

Delete the words { The Crew are, *are not*, berthed in the bridge house. *Aft.*
that do not apply { The arrangements to enable them to get backwards and forwards from their quarters are, *are not* satisfactory.



Length of Bulwarks in well *100 ft 70.92*

Area of Freeing Ports required by Para. 11 (e) each side of vessel = *14.20* Sq. ft.

Ft. Tenth. Ft. Tenth. No.

Fore end. { 2. 33 x 1. 25 x 4. oval.	Freeing Ports (each side of vessel) = <i>14.11</i>	Sq. ft.
R. 2. D.R. 2. 33 x 1. 25 x 5. —	<i>14.36</i>	
<i>Not for R. of T. copy</i>		

Total deficiency or excess = ✓ Sq. ft.

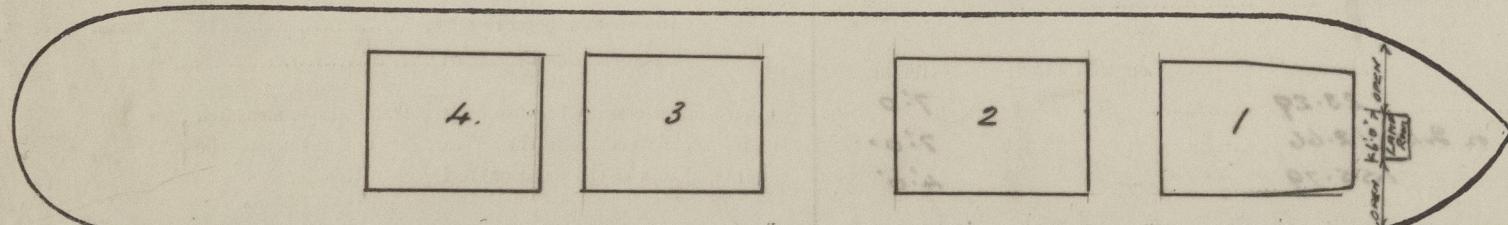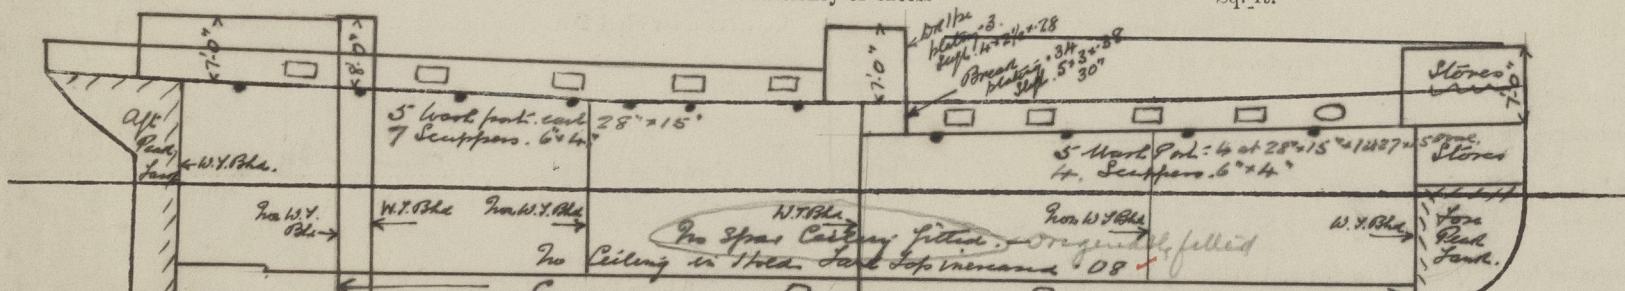

Show hereon line of Floors or Tank Top with position of any Breaks in same; also height of Peak Tank tops, &c., &c.

State any special features in the construction of the Vessel ✓

Builder's name and yard number *J. Gulliver & Co.*

Names of sister vessels ✓

Owners *R. Hughes & Co.*

Address *Liverpool*

Fee £ 5 : 10 : 0.

Received by me See Reclassification Report.



© 2021

Lloyd's Register
Foundation