

EX 17.1.33
Lloyd's Register of Shipping.Index No. 24117
(For London Office only.)

SURVEYS FOR FREEBOARD.—STEAM SHIPS.

PARTICULARS RELATING TO ALL STEAM SHIPS EITHER FLUSH DECKED, OR WITH TOP GALLANT FORECASTLES, SHORT POOPS AND BRIDGE HOUSES DISCONNECTED, OR WITH TOP GALLANT FORECASTLES HAVING LONG POOPS, OR RAISED QUARTER DECKS CONNECTED WITH BRIDGE HOUSES, OR OTHERWISE.

Port of Survey London
Date of Survey November 1919
Name of Surveyor

Ship's Name.

Northwestern Muller

Port of Registry and Nationality.

Liverpool
British

Official Number.

137431

Gross Tonnage.

6504

Date of Build.

1915

Particulars of Classification.

100A.1. Shelter deck
with freeboardNumber in Register Book 22016

LENGTH.

419.8

BREADTH.

53.4

DEPTH.

27.8

UNDER DECK TONNAGE.

4745.51

Moulded Depth as measured.....

30.629.0

NOTE.—If the depth is measured when vessel is afloat, the details of measurement should be reported.

Addition for Keel below base line for draught record.....inches.

CORRECTION FOR LENGTH.

Length of Ship on Loadline..... 419.8

Length in Table

Difference

Correction for 10ft., Table A.

Table C.

× Difference divided by 10

(if required.)

If $\frac{6}{10}$ ths length covered divide by 2

CORRECTION FOR IRON DECK.

Proportion covered, if less than $\frac{7}{10}$ ths length covered

Thickness of usual wood deck, less stringer

CORRECTION FOR ROUND OF BEAM.

Breadth at Gunwale amidships.....

Round of Beam

Normal round.....

Difference

÷ 2 =

Proportion of Deck uncovered (Para. 19)

NOTE.—The round of beam should be reported on the full breadth of vessel at the gunwale.

Freeboard, Table A 7.6 $\frac{1}{4}$ Correction for Sheer -9 $\frac{3}{4}$ 6.8 $\frac{1}{2}$ Correction for Length +47.0 $\frac{1}{2}$ Allowance for Deck Erections 2.1 $\frac{3}{4}$ 4.10 $\frac{3}{4}$

Correction for Round of Beam.....

Correction for fall in Sheer (if any).....

Correction for Iron Deck (if required)

-3 $\frac{1}{2}$ 4.7 $\frac{1}{4}$

Additions for non-compliance with provisions of

Para. 11 (d) and (e) †

8.613.1 $\frac{1}{4}$ Other Corrections (if any) Reduction for closinglounge opening1.611.7 $\frac{1}{4}$ Winter Freeboard 11.7 $\frac{1}{4}$ Summer Freeboard 11.1 $\frac{1}{4}$ Indian Summer Freeboard 10.7 $\frac{1}{4}$

N.A. Winter Freeboard

Correction necessary because clearside amidships, measured in accordance with the Statute is not taken at the intersection of the wood or iron deck with side.

1 $\frac{3}{4}$ Winter Freeboard from deck line 11.9Summer " " " " 11.3Indian Summer " " " " 10.9Shelter N.A. Winter " " " " 11.3Deck Line, Wood (Iron) Deck :— 6 $\frac{1}{2}$ Fresh Water Line above centre of Disc 6Indian Summer Line " " " " 6Winter Line below " " " " 6

Winter North Atlantic Line " " " "

† If the frames, skin planking, or ceiling are of unusual thickness the breadth of vessel to inside of ceiling should be reported if possible.
† In vessels obtaining an allowance for deck erections under Para. 11 where the sheer drops abaft amidships the height of the R.Q.D. is to be taken from the level of the top of the amidship beam.
§ In flush-decked vessels the total standard mean sheer means the sheer measured at the stem and sternposts. In vessels having poops and forecastles, it means the sheer measured at points distant one-eighth of the vessel's length from stem and stern-post.State dimensions of freeing port area on back of this form.
The Surveyor should state whether the fall in sheer as reported is measured relatively to the straight line of keel or to the water line. If measured relatively to water line the vessel's draft at time of survey, and also the usual load draft forward and aft, should be reported.Lloyd's Register
Foundation
© 2021
008648-008655-0273

Do all the Frames extend to the top height in the Poop? Raised Quarter Deck? Bridge House? Forecastle?
 To what height do the Reverse Frames extend?
 Has the Poop or Raised Quarter Deck an efficient Iron Bulkhead at the fore end?
 Give particulars of the means for closing the openings in Bulkhead
 Is the Poop or Raised Quarter Deck connected with the Bridge House? Has the Bridge House an efficient Bulkhead at the fore end?
 Give particulars of the means for closing the openings in Bulkhead
 What is the thickness of the Bridge Front plating? and Coaming plate?
 Give scantlings and spacing of the Stiffeners
 Are bracket plates fitted at each end of the Stiffeners? Are hor'l. brackets fitted connecting Bridge Bulk'd. with Bulwarks?
 Has the Bridge House an efficient Iron Bulkhead at the after end?
 How are the openings closed?
 Is the Forecastle at least as high as the main or top-gallant rail? Has the Forecastle an efficient Iron or Wood Bulk'd. at after end?
 Are the Engine and Boiler openings covered by a Bridge, Poop, Raised Quarter Deck, or enclosed by a Strong Iron or Steel Deckhouse? }
 If the openings are not so protected are the exposed parts of the Casings efficiently constructed?
 Give thickness of plating; scantlings and spacing of Stiffeners
 What is the height of the exposed Casings? Are suitable means provided for closing all openings in them in bad weather?
 Are the Weather Deck Hatchways efficiently constructed and at least equal to the requirements of Section 28 of the Rules for 1904-5? Give particulars below:— }

Position and Size.									
Item.		Ship.	Rule.	Ship.	Rule.	Ship.	Rule.	Ship.	Rule.
COAMING.	Height above top of DECK								
	Thickness { Sides.....								
	Ends.....								
SHIFTING BEAMS OR WEB PLATES.	Number								
	Section and Scantlings								
	Material								
* FORE AND AFTERS.	Number								
	Section and Scantlings								
	Material								
HATCHES Thickness									
Remarks.....									

* The depth of Fore and Afters should be stated from the underside of the hatches in all cases.

(If the sill of the lowest side scuttle will be less than 6 inches above the Indian Summer Load Line if assigned under the tables, state vertical distance from top of deck at side amidships to lower edge of lowest side scuttle.)

The following information is to be given in all Cases of vessels dealt with under Paras. 11, 12 (under 15 feet Moulded depth) and under Shelter Deck
 What is the thickness of the Bridge Sheerstrake? Strake between Main and Bridge Sheerstrakes?


Delete the words { The Crew are, are not, berthed in the bridge house.
 that do not apply { The arrangements to enable them to get backwards and forwards from their quarters are, are not satisfactory.

Length of Bulwarks in well

Area of Freeing Ports required by Para. 11 (e) each side of vessel = Sq. ft.

Ft.	Tenths.	Ft.	Tenths.	No.	} Freeing Ports (each side of vessel)	=	Sq. ft.
	x			x			
	x			x			

Total deficiency or excess = Sq. ft.

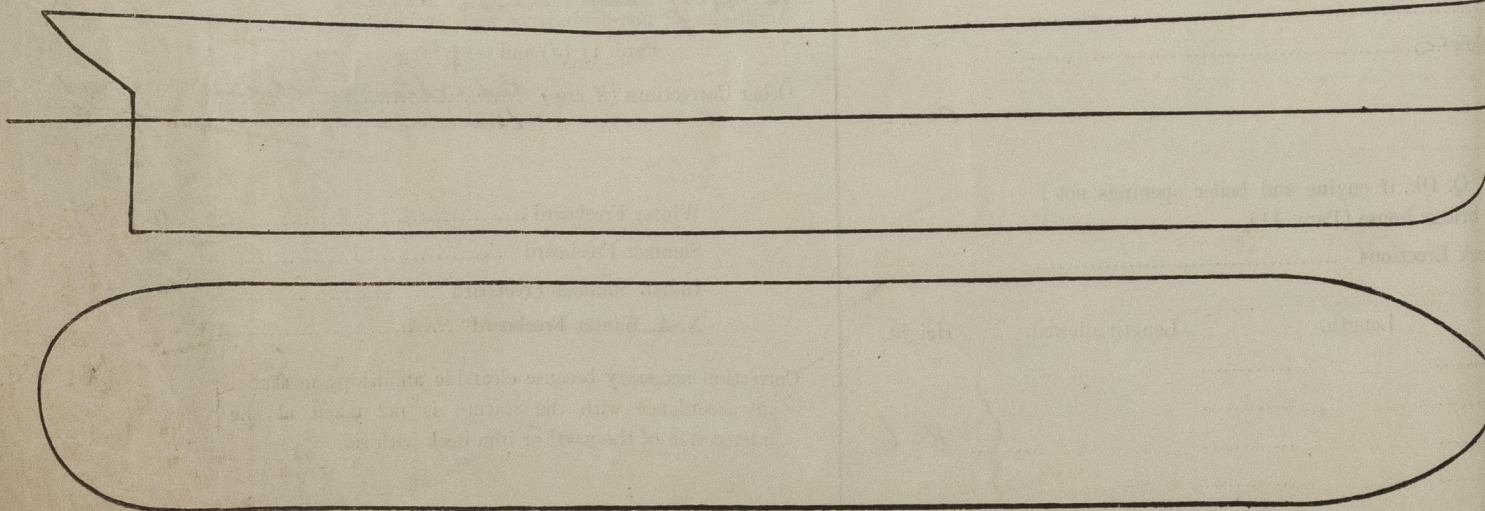

Show hereon line of Floors or Tank Top with position of any Breaks in same; also height of Peak Tank tops, &c., &c.

See verification form.

State any special features in the construction of the Vessel Wash port doors & Lounage opening have
 up with riveted plates. Scuppers to ships side and deck are now fitted with
 Scuppers to bilges from 'tween decks are now fitted. The requirements of circular 12
 been complied with

Owners

Address

Fee £

Received by me



© 2021

Lloyd's Register
Foundation