

Sketch of Scorph Below Boss

on Shipframes No 221/2

As Made


20~~11~~ 14.14

~~20-11-14 (229)~~

2.12.14 (229)

15.3.15 (231)

10.5.15

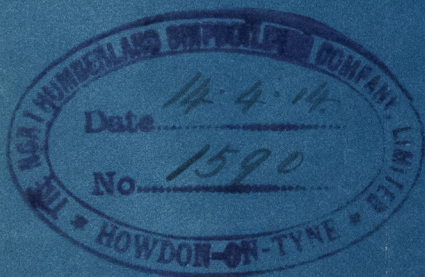

ccp

17.4.14.




CB

008648-008655-0283

Northumberland P.B. 2.
No 221 + 2.

Stem paragraph as made

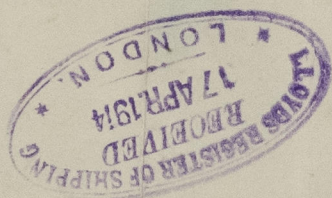

© 2021

Lloyd's Register
Foundation

008648-008655-0283