

N^{OS} 221 & 2 .
PROFILE & DECK PLANS.

MASTS, WINCHES & WINDLASS SUPPORTED TO SURVEYORS SATISFACTION.

PLAN OF BULKHEADS. TO BE SUBMITTED. ✓

HATCHWAYS: End Beams & Pillars to be submitted


CASINGS.

PILLARS NOT EXCEEDING 4 DIA 4 RIVETS IN HEAD & HEEL
 " ^{under} OVER 48 ~~under~~ 5 DIA 5 RIVETS IN HEAD & HEEL
 " ^{and under 6" diam} OF 5 DIA 4 RIVETS IN HEAD & HEEL
 " 6" diam and above 8 " " " " "

SCALE $\frac{1}{8}'' = 1 \text{ Foot}$

Shipping Logs to Birders to be fitted
as required to Surveyors Satisfaction





300 048 - 008

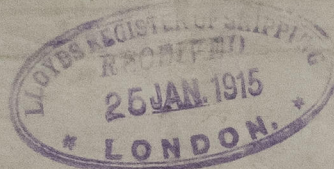

221+2
"TEIRYU MARU" ★

Inthumland & B


No. 221+2
Profile & Deck plan

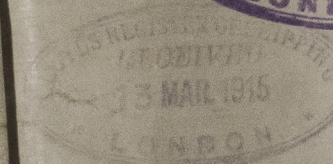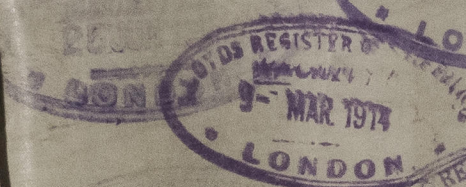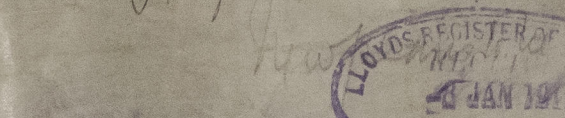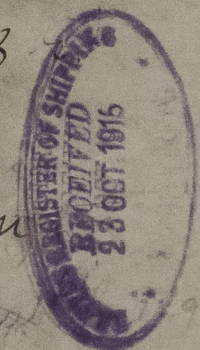

SS. "MONTCALM"
NEWCASTLE ON TYNE.
Report No. 70257.



SS. "NORTHWESTERN MILLER"
NEWCASTLE ON TYNE.
Report No. 67264.

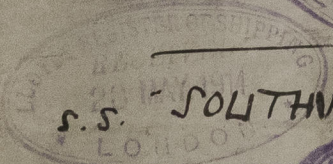

S.S. "SOUTHWESTERN MILLER"
NEWCASTLE ON TYNE



Report No. 67678

